PLAN	SURVEYED	BY	DATE
NOTE BOOK	PLOTTED		
No.	ALIGNMENT CHECKED		
	RT. OF WAY CHECKED		

PROFILE	SURVEYED	BY	DATE
NOTE BOOK	PLOTTED		
No.	ALIGNMENT CHECKED		
	& M.'s NOTED		
	STRUCTURE NOTATIONS CHECKED		

R.O.W. PLAN

THIS SHEET TO BE USED FOR R.O.W. INFORMATION ONLY.

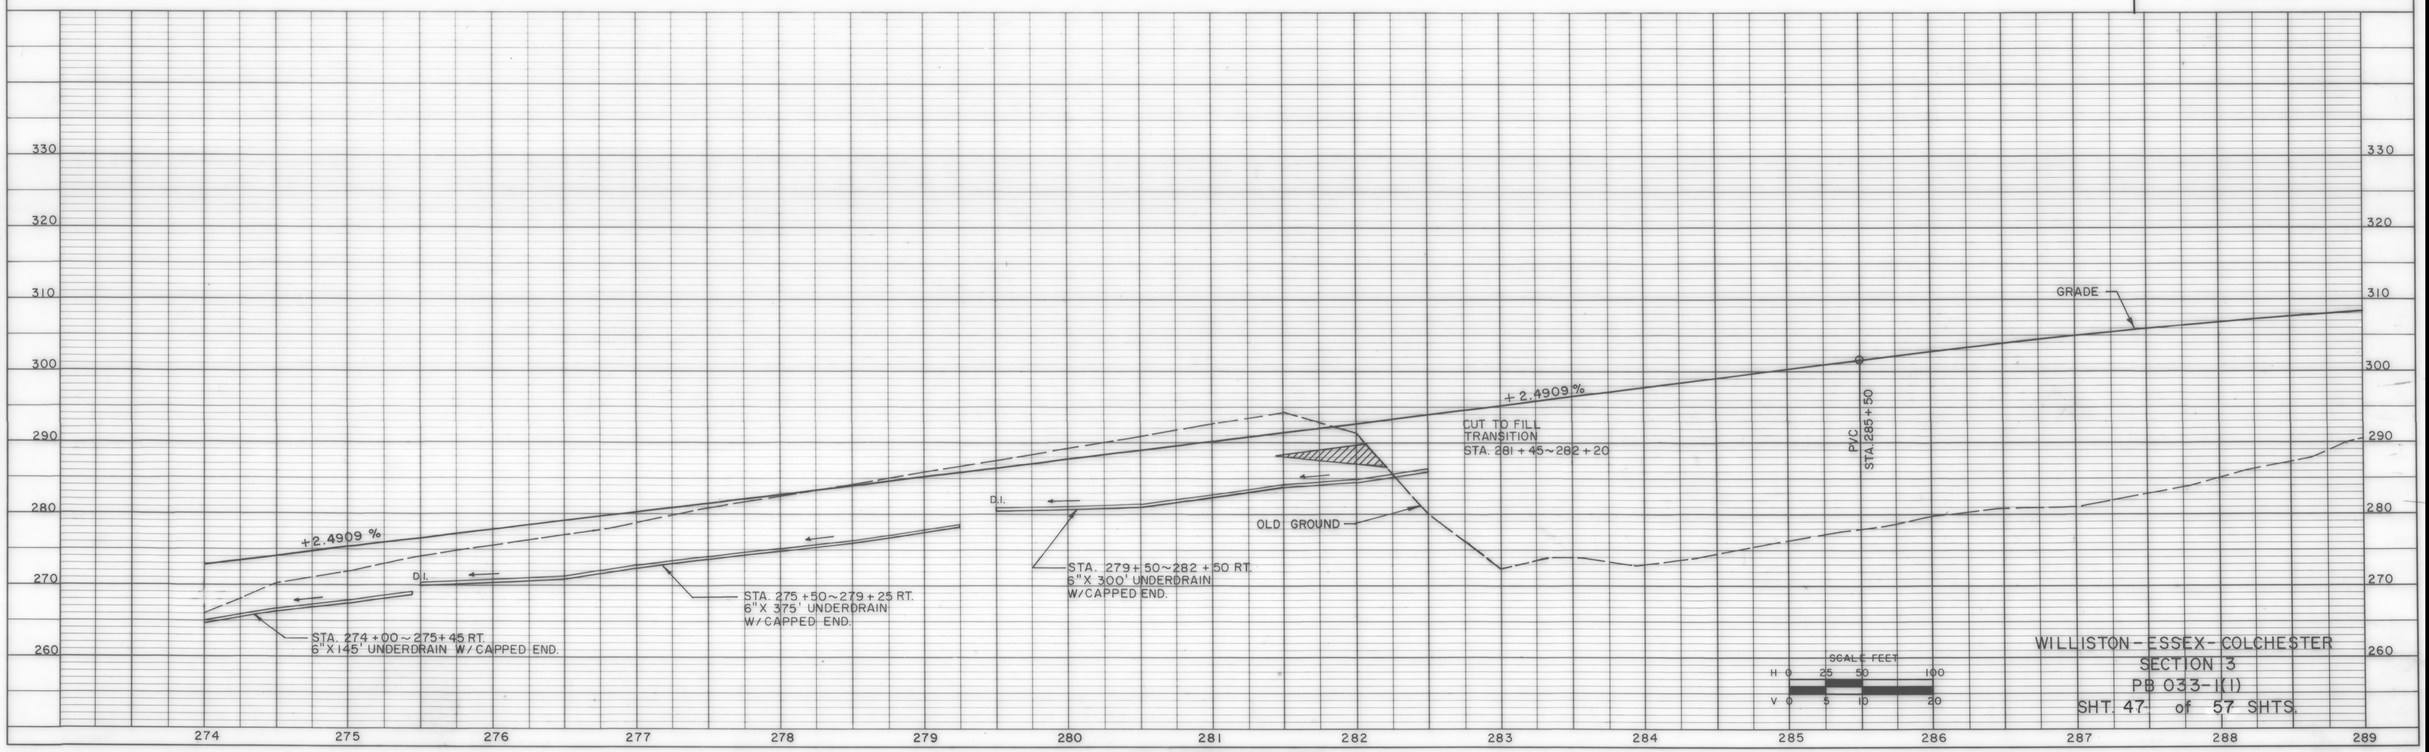

WILLISTON - ESSEX - COLCHESTER
SECTION 3
PB 033-1(1)
SHT. 47 of 57 SHTS.