PLAN		BY	DATE
NOTE BOOK	SURVEYED ____ PLOTTED ____ ALIGNMENT CHECKED ____ RT. OF WAY CHECKED ____		
No. ____			

PROFILE		BY	DATE
NOTE BOOK	SURVEYED ____ PLOTTED ____ GRADES CHECKED ____ B. M.'s NOTED ____ STRUCTURE NOTATIONS CHECKED		
No. ____			

R.O.W. PLAN

THIS SHEET TO BE USED FOR R.O.W. INFORMATION ONLY.

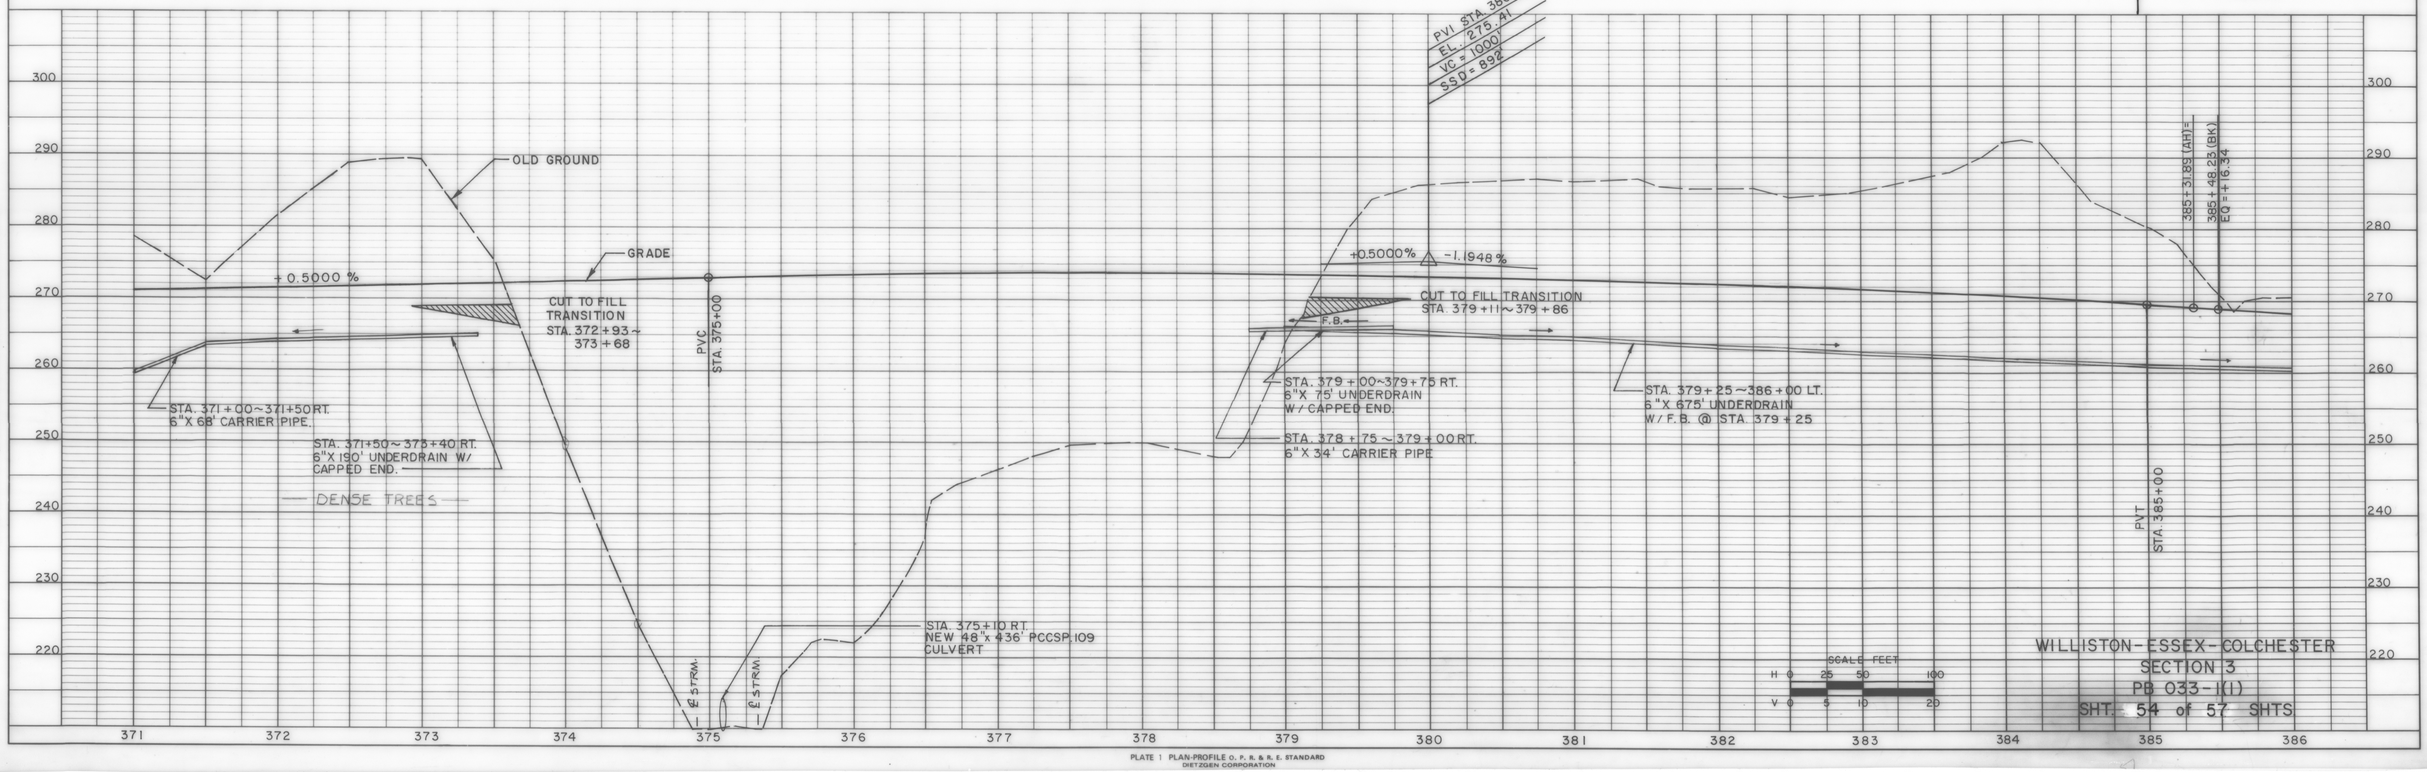

WILLISTON-ESSEX-COLCHESTER
SECTION 3
PB 033-1(1)
SHT. 54 of 57 SHTS

PLATE 1 PLAN-PROFILE O. P. R. & R. E. STANDARD
DIETZGEN CORPORATION