| PLAN | | BY | DATE |
|---|---|---|---|
| NOTE BOOK No. | SURVEYED<br>PLOTTED<br>ALIGNMENT CHECKED<br>RT. OF WAY CHECKED | | |

**R.O.W. PLAN**

THIS SHEET TO BE USE
FOR R.O.W. INFORMATIO
ONLY.

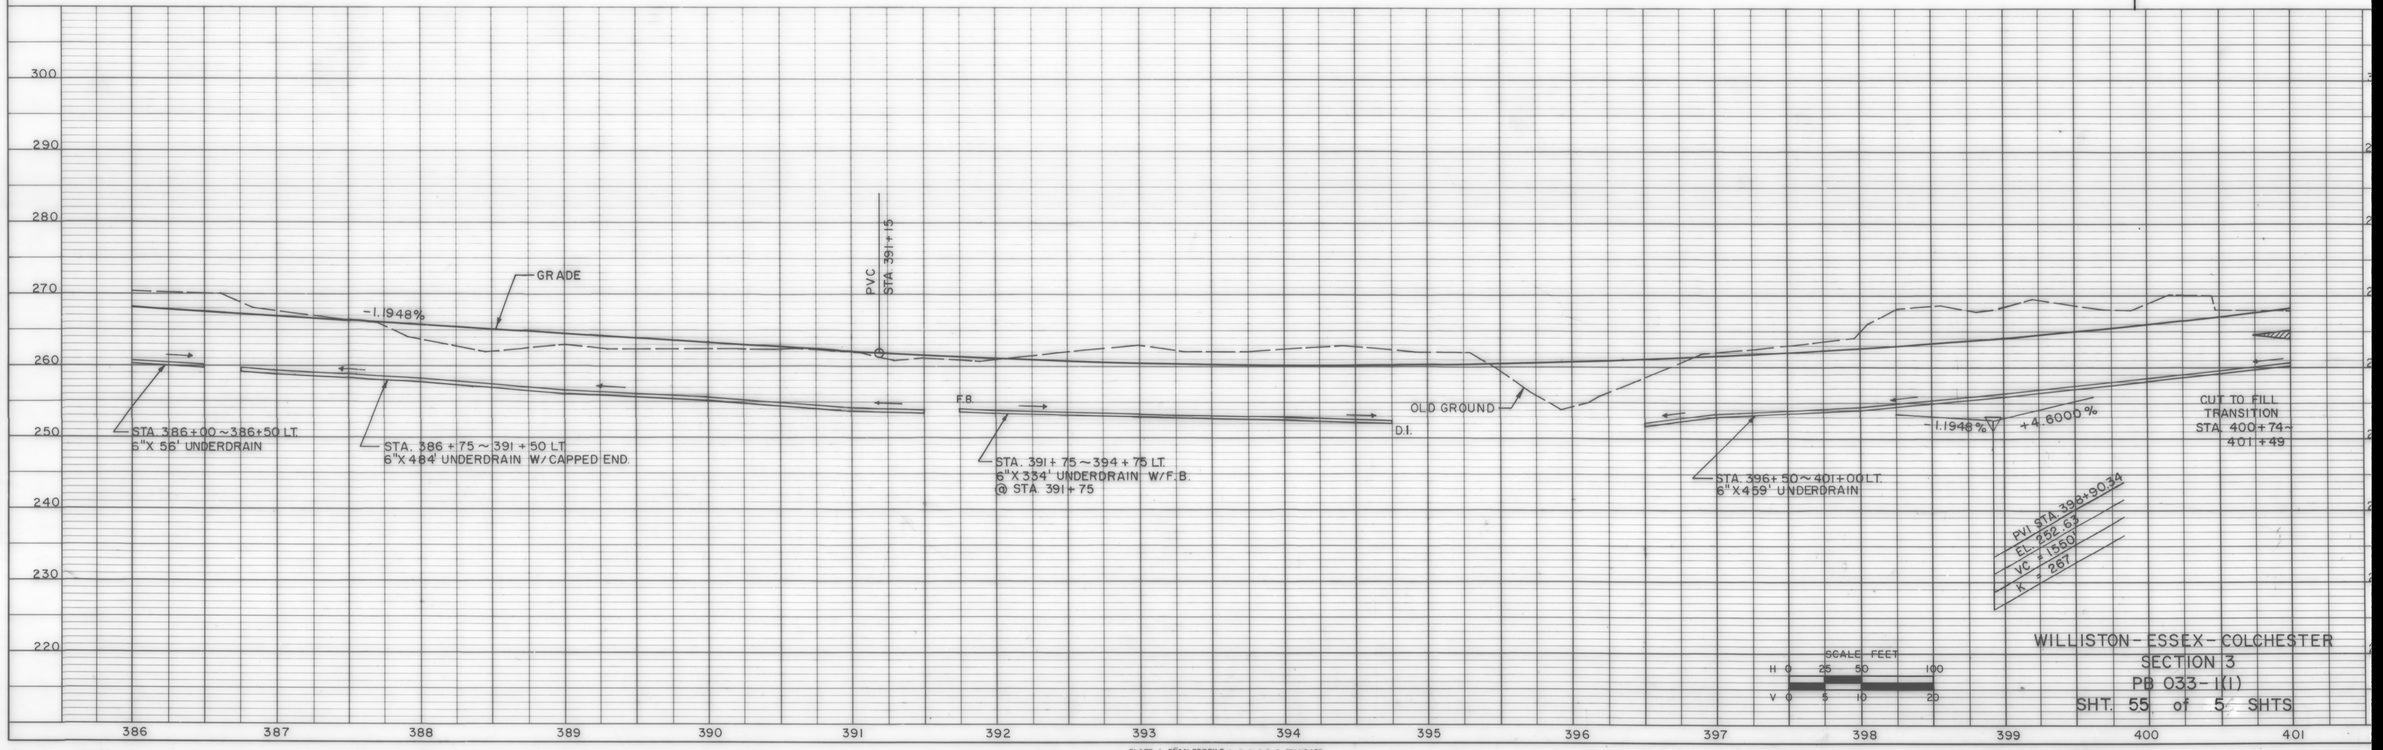


| PROFILE | | BY | DATE |
|---|---|---|---|
| NOTE BOOK No. | SURVEYED<br>PLOTTED<br>GRADES CHECKED<br>B. M.'s NOTED<br>STRUCTURE NOTATIONS CHECKED | | |

WILLISTON-ESSEX-COLCHESTER
SECTION 3
PB 033-1(1)
SHT. 55 of 5[illegible] SHTS.

PLATE 1 PLAN-PROFILE O. P. R. & R. E. STANDARD
DIETZGEN CORPORATION