


PROFILE
SURVEYED
PLOTTED
NOTE BOOK GRADES CHECKED
B.M. = ℄ NOTED
NO. STRUCTURE NOTATIONS CHKD
BY
DATE

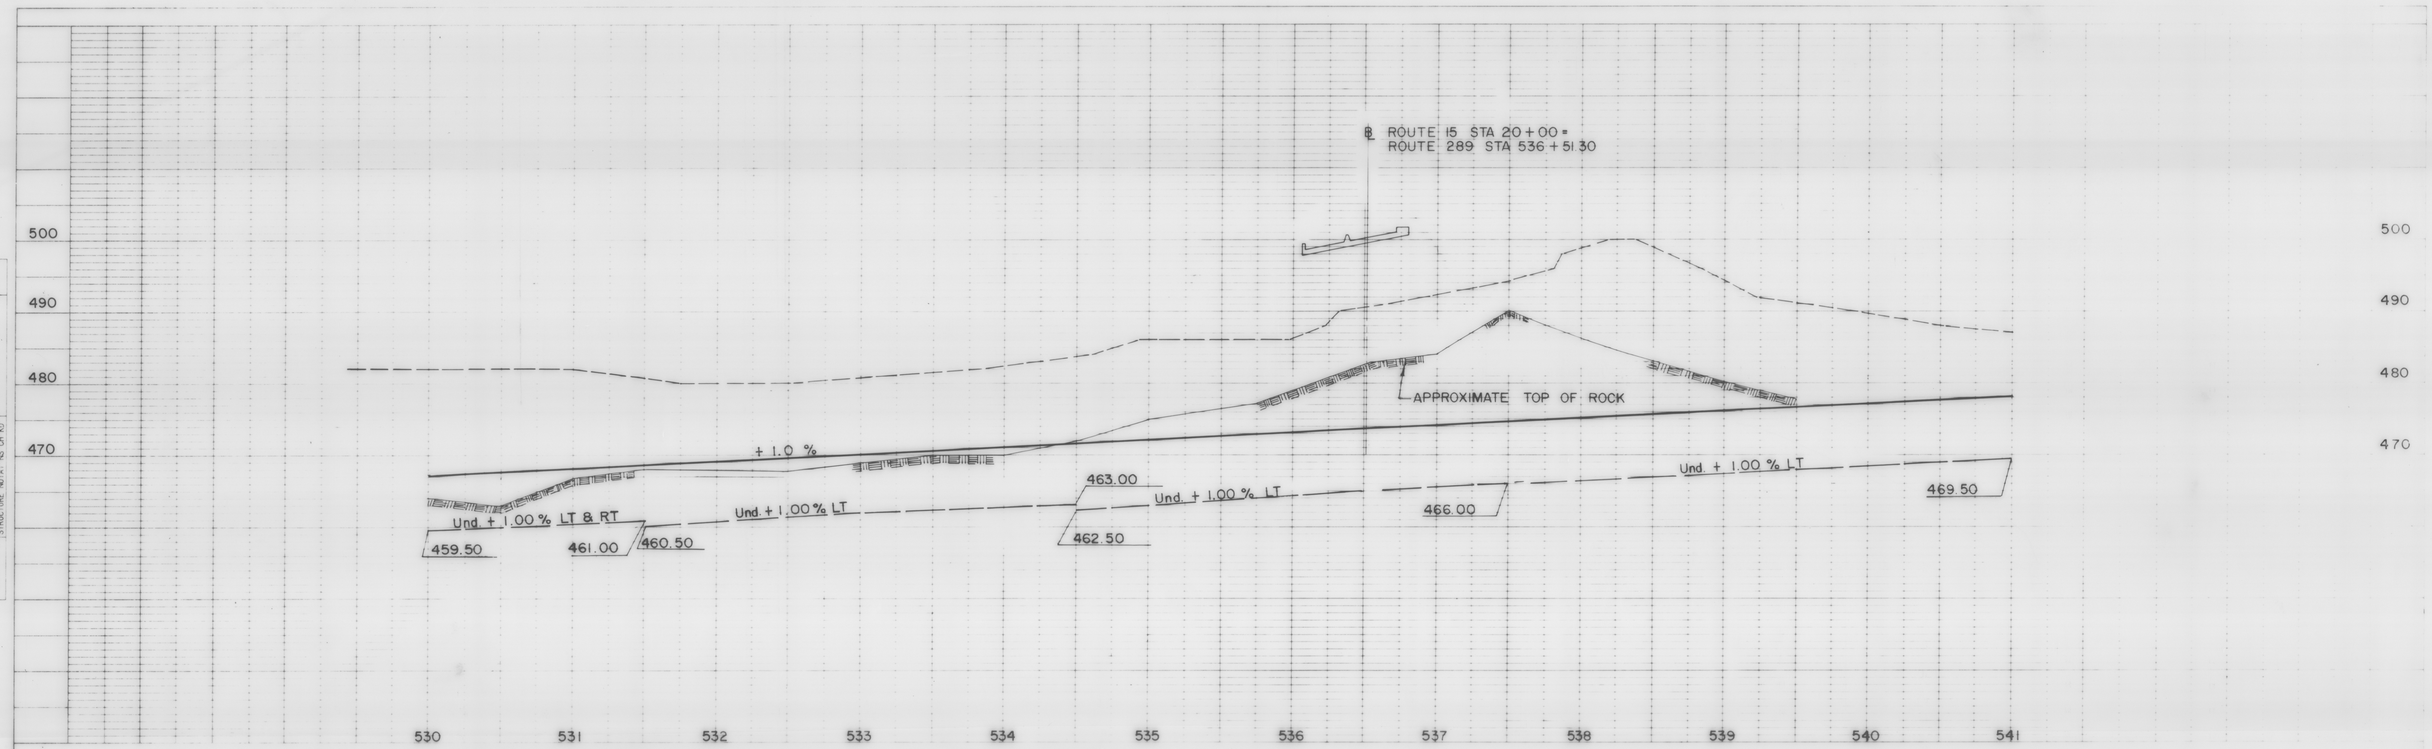


PROFILE
SURVEYED
PLOTTED
NOTE BOOK GRADES CHECKED
B.M. = ℄ NOTED
No. STRUCTURE NOTATIONS CHECKED
BY
DATE

0 25 50
SCALE IN FEET
10
5
0

SURVEYED BY PINKHAM ENG. DATE 4/87
DRAWN BY R.A.L. DATE 8/87
TRACED BY J.F.D. DATE 10/87

VERMONT ROUTE 289 (F.A.P.)
TOWN OF ESSEX

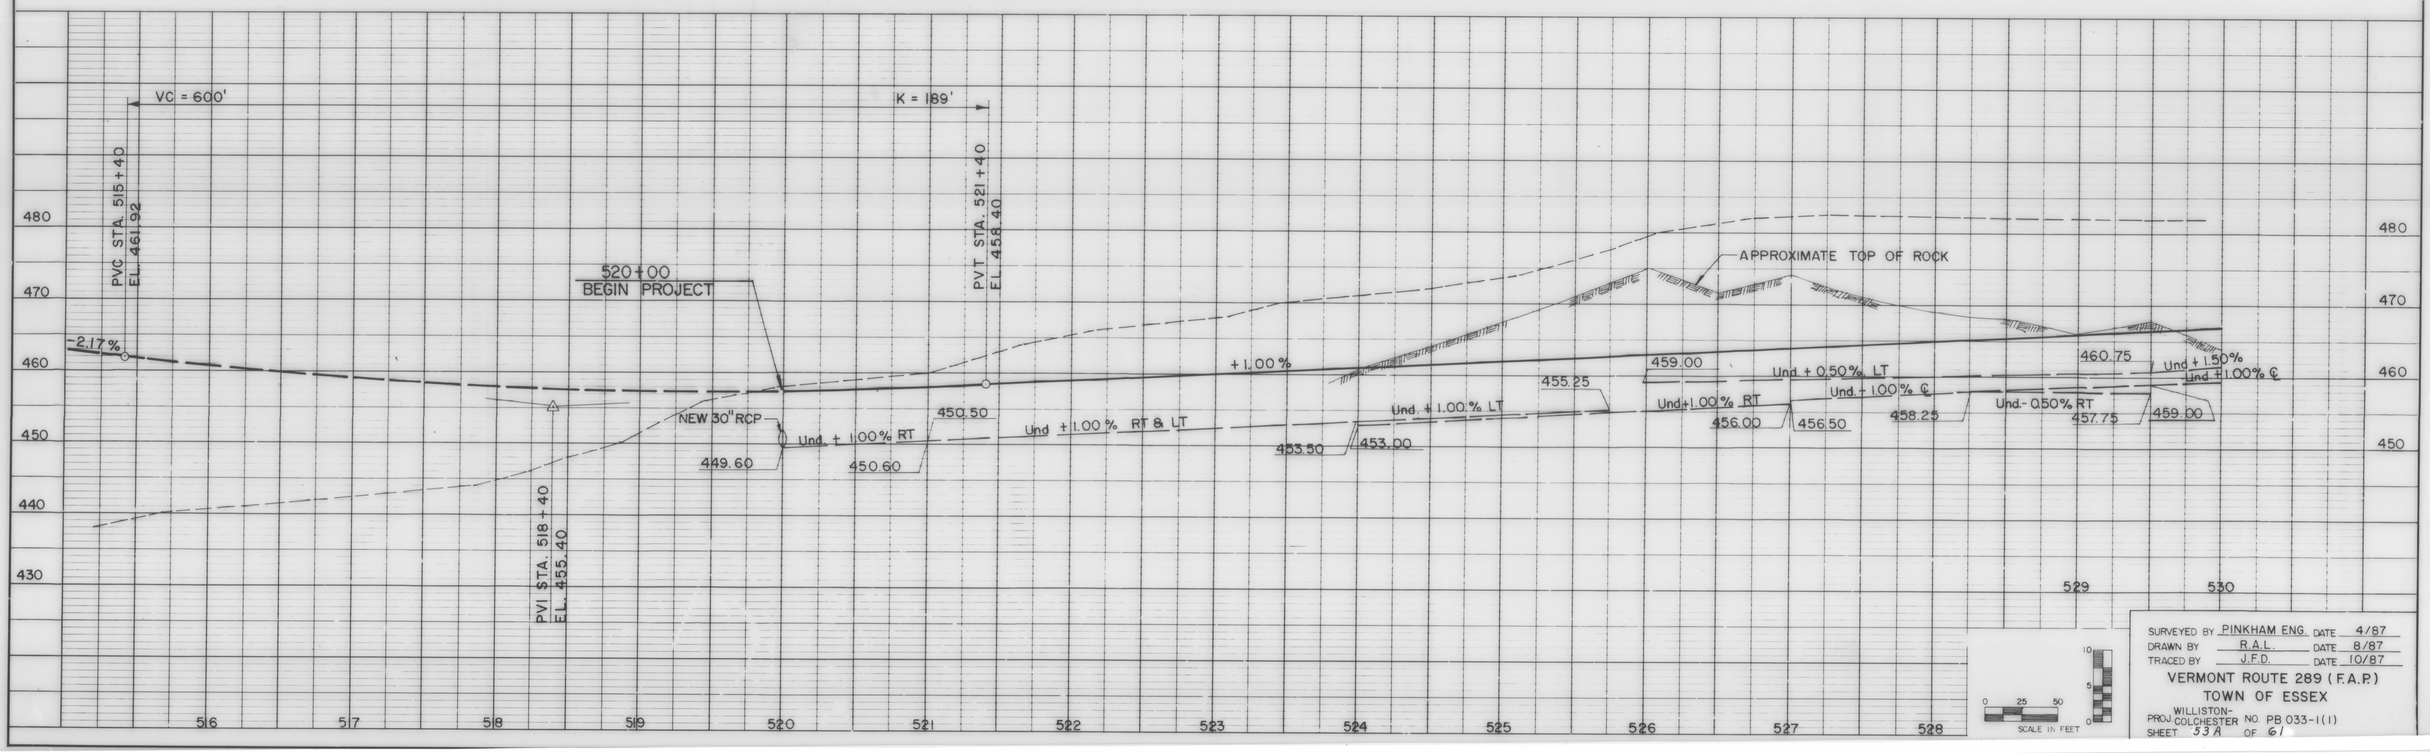PROJ. WILLISTON-COLCHESTER NO. PB 033-1(1)
SHEET 53A OF 61