SEE SHEET 2

# STATE OF VERMONT
# AGENCY OF TRANSPORTATION

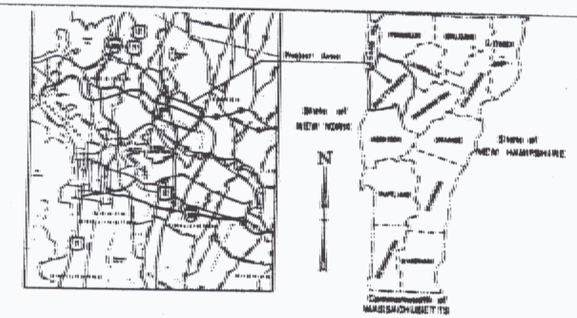


PROJECT DESCRIPTION:
[redacted] OF 1.580 MILES OF VT 289. TO INCLUDE RECONSTRUCTION OF 0.460 MILES OF VT 15, [redacted] OF TWO - TWO SPAN STEEL MULTI-GIRDER BRIDGES, THREE PLATE-TYPE STRUCTURES, [redacted] VERTICAL DRAINS, GRADING, EROSION CONTROL, DRAINAGE, SUBBASE, PAVING, [redacted], SIGNAGE, AND RELATED ITEMS.

PROJECT LOCATION:
[redacted] APPROXIMATELY 1,800 FEET EASTERLY OF THE CROSSING OF VERMONT ROUTE 2A, AND [redacted] EASTERLY 1.580 MILES TO APPROXIMATELY 500 FEET WESTERLY OF THE CROSSING OF VERMONT ROUTE 15.

## PROPOSED IMPROVEMENT
## TOWN OF ESSEX
## COUNTY OF CHITTENDEN
## PROJECT NO. PB 033-1(2)

Dated: AUG 1 1991

R.S. Audley, Inc.
Contractor

R.S. Audley
Signature

President
Title

Transportation Secretary's Signature

## CHITTENDEN COUNTY CIRCUMFERENTIAL HIGHWAY
## RTE. 289

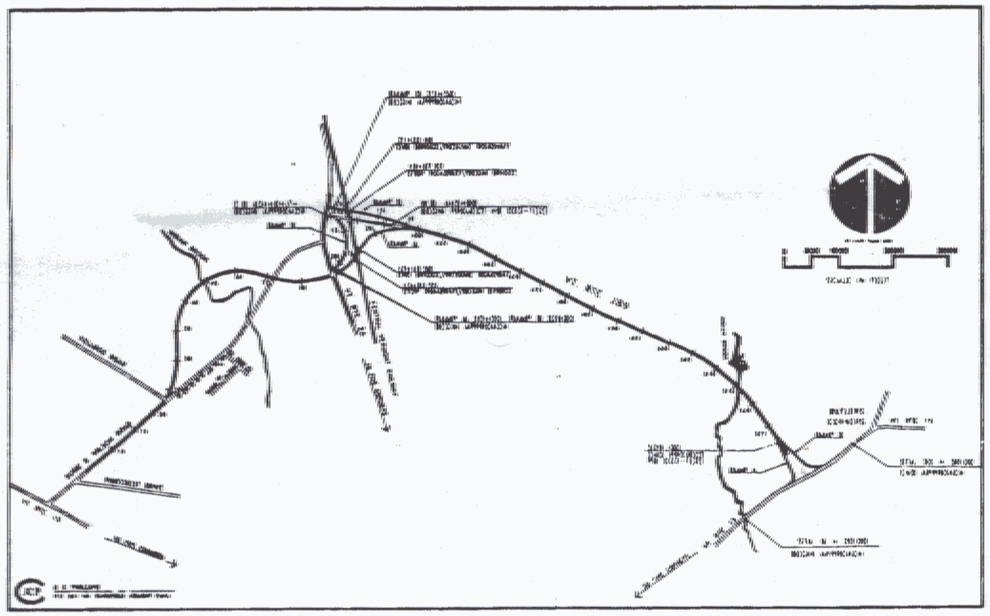

CONVENTIONAL SIGNS

DATUM
VERTICAL
HORIZONTAL

THESE PLANS ARE SUBJECT TO SUCH ENGINEERING CHANGES AS MAY BE REQUIRED BY THE FEDERAL HIGHWAY ADMINISTRATION OR THE LOCAL ENGINEER.
CONSTRUCTION IS TO BE CARRIED ON IN ACCORDANCE WITH THESE PLANS AND THE STANDARD SPECIFICATIONS FOR CONSTRUCTION (BATTER 6.5%) AS APPROVED BY THE FEDERAL HIGHWAY ADMINISTRATION.
FOR USE ON THIS PROJECT, INCLUDING ALL SUBSEQUENT REVISIONS AND SUCH REVISED SPECIFICATIONS AND SPECIAL PROVISIONS AS ARE INCORPORATED ON THESE PLANS.

THIS PROJECT DESIGNED
UNDER CONTRACT PB 033-1(1)

SUBMITTED BY: [illegible] THE DIV. TRANSPORTATION BOARD
APPROVED: [illegible] DATE 5/15/91
PROJECT MANAGER
DEPARTMENT OF TRANSPORTATION
FEDERAL HIGHWAY ADMINISTRATION
APPROVED: DIVISION ADMINISTRATOR DATE
PROJECT [redacted] NO. PB [redacted]
SHEET 1 OF [redacted] SHEETS

9 | B 112 Pin II
Essex
PB 033-1(2)
VT 289 Circ Completed