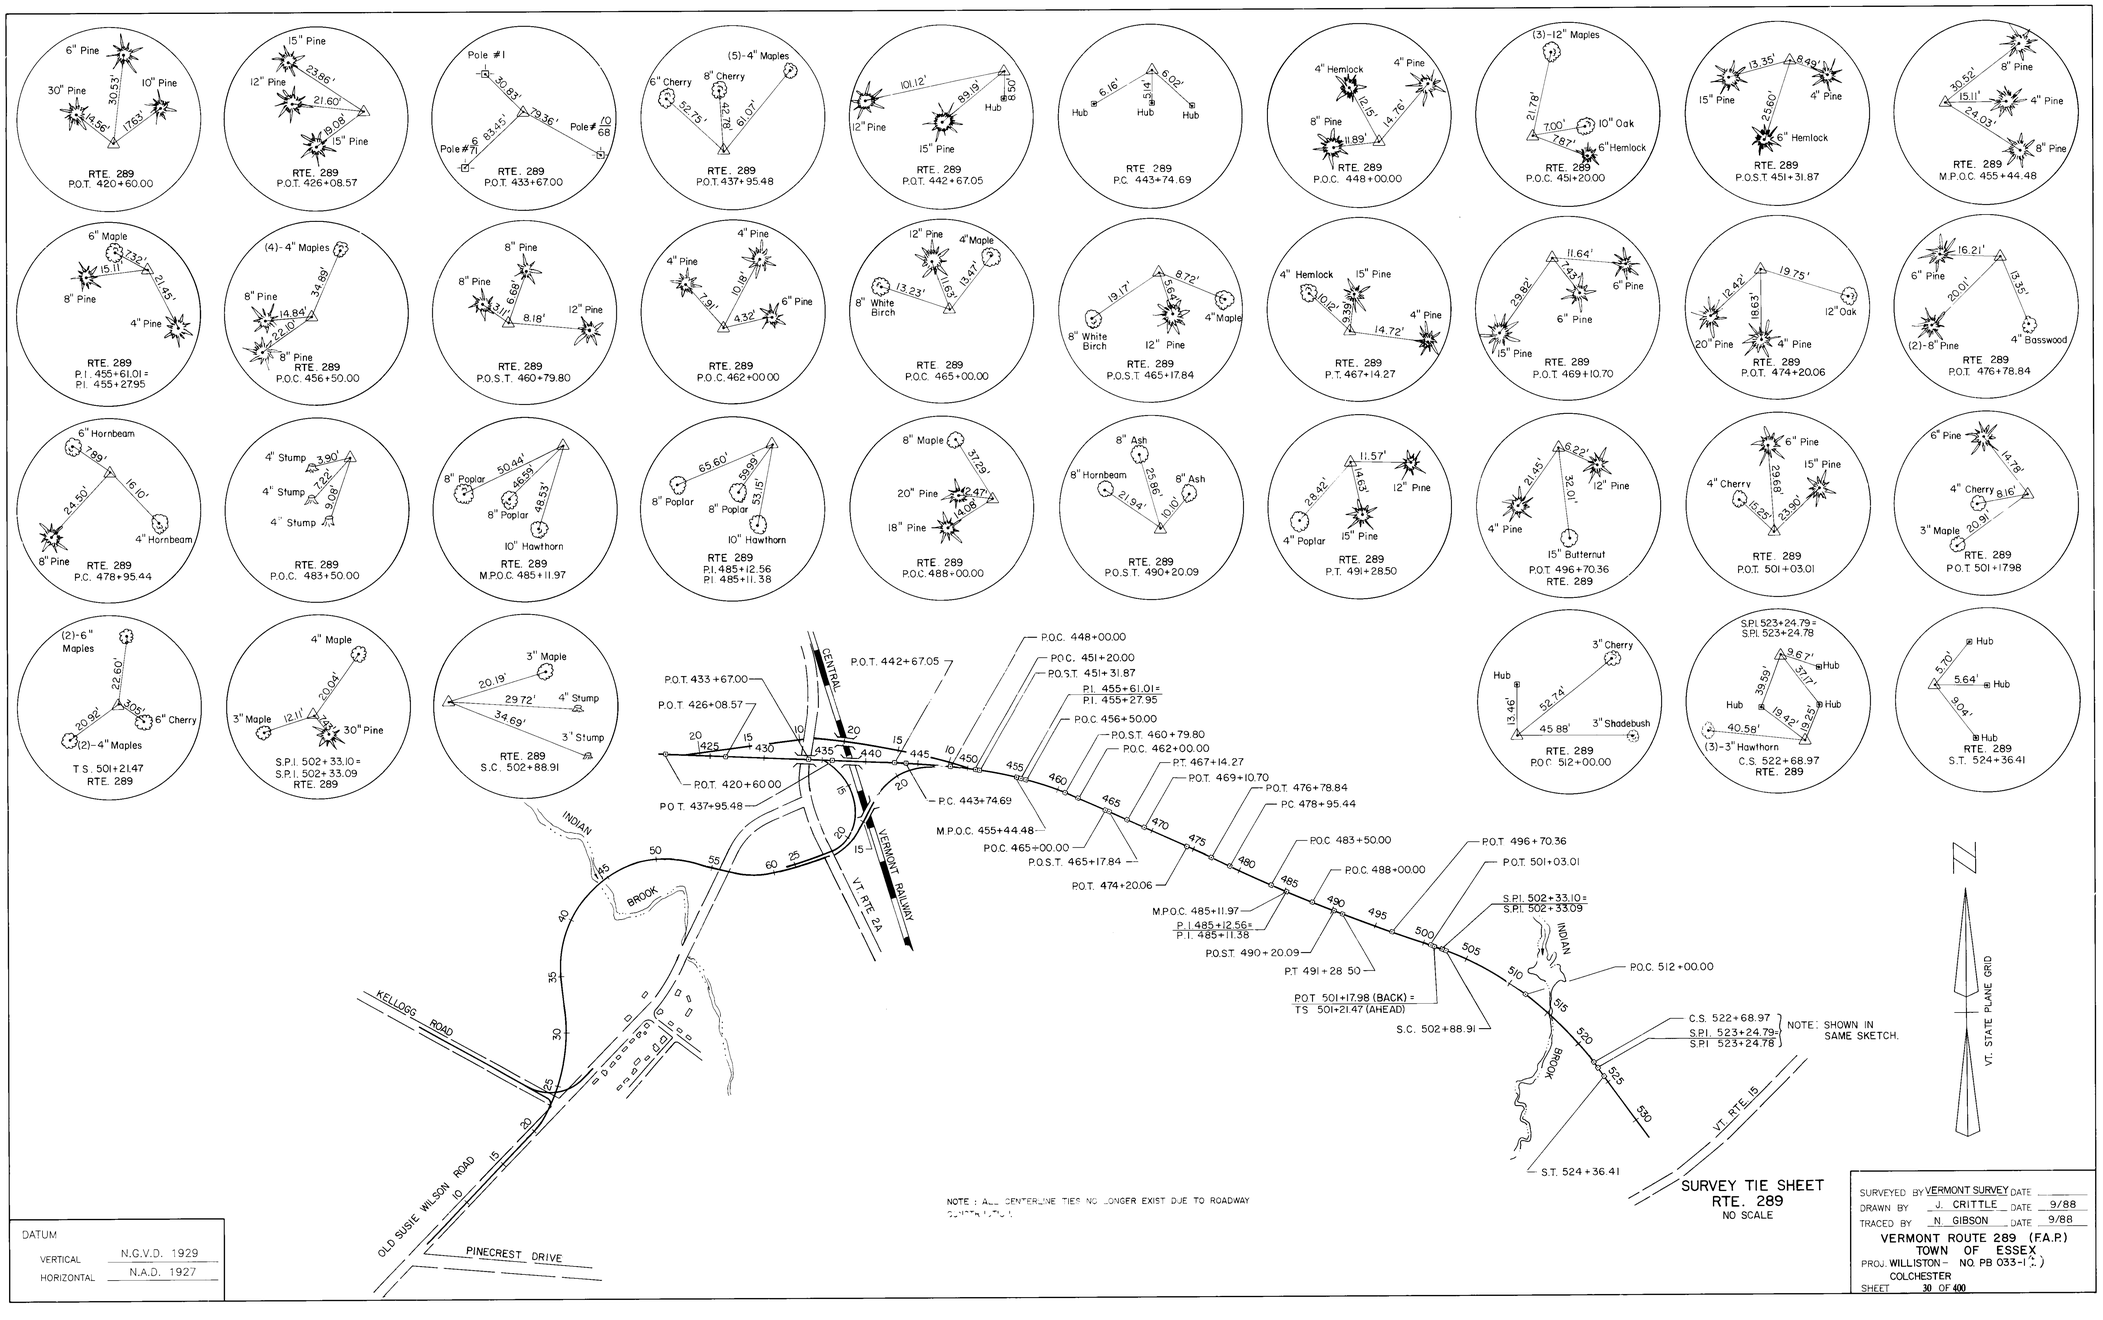

NOTE: ALL CENTERLINE TIES NO LONGER EXIST DUE TO ROADWAY CONSTRUCTION.

DATUM

VERTICAL	N.G.V.D. 1929
HORIZONTAL	N.A.D. 1927

SURVEY TIE SHEET
RTE. 289
NO SCALE

SURVEYED BY VERMONT SURVEY DATE
DRAWN BY J. CRITTLE DATE 9/88
TRACED BY N. GIBSON DATE 9/88

VERMONT ROUTE 289 (F.A.P.)
TOWN OF ESSEX
PROJ. WILLISTON – NO. PB 033-1( )
COLCHESTER
SHEET 30 OF 400