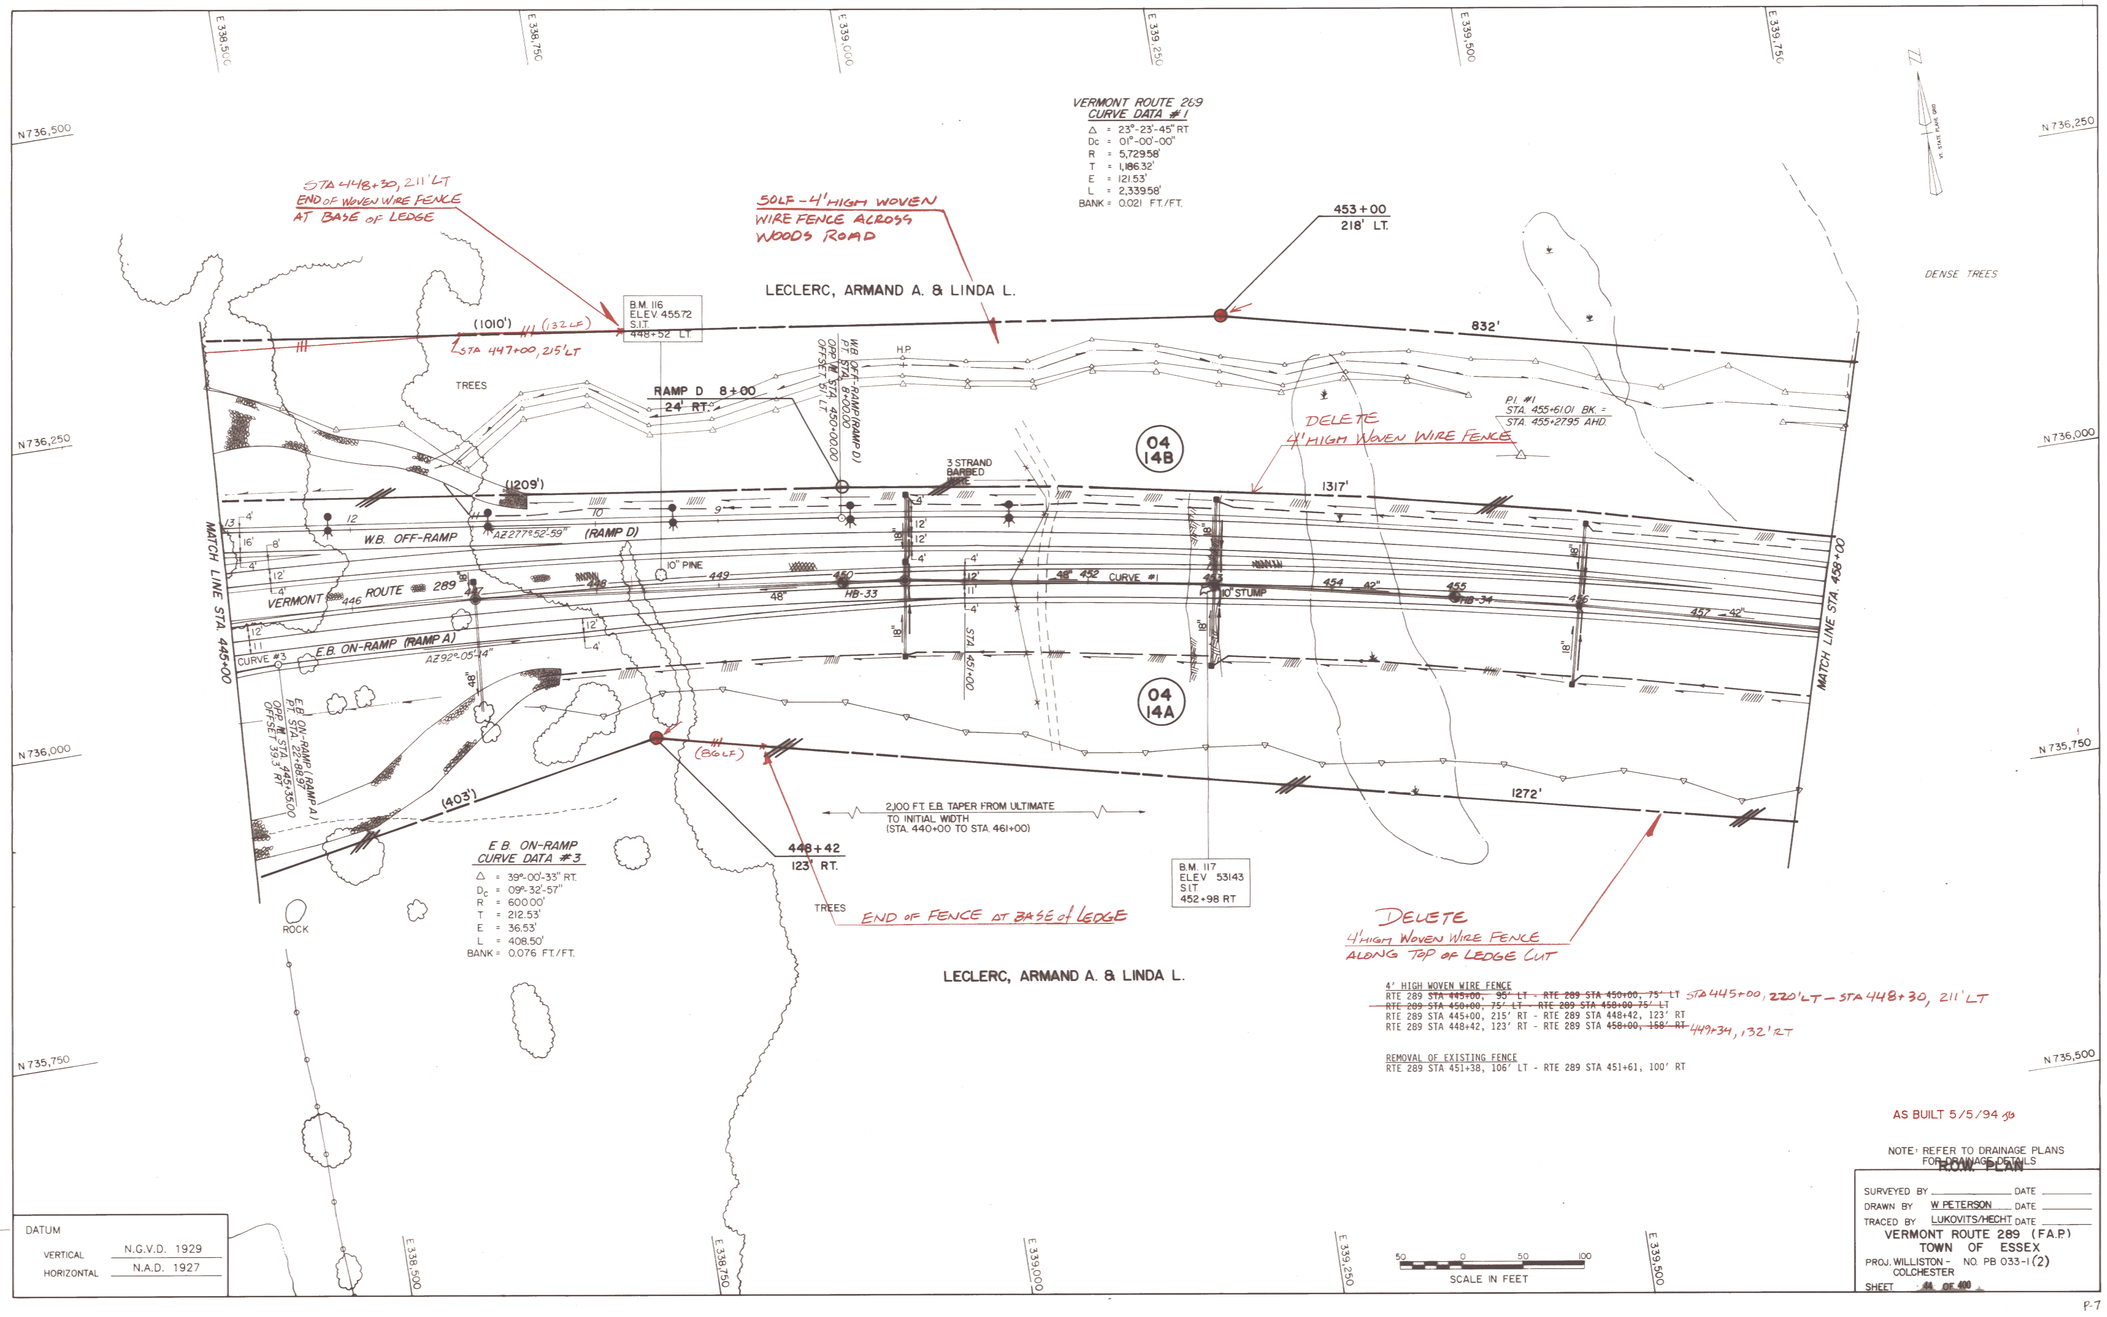

4' HIGH WOVEN WIRE FENCE
RTE 289 ~~STA 445+00, 95' LT - RTE 289 STA 450+00, 75' LT~~ STA 445+00, 220' LT – STA 448+30, 211' LT
~~RTE 289 STA 450+00, 75' LT - RTE 289 STA 458+00 75' LT~~
RTE 289 STA 445+00, 215' RT - RTE 289 STA 448+42, 123' RT
RTE 289 STA 448+42, 123' RT - RTE 289 STA ~~458+00, 158' RT~~ 449+34, 132' RT

REMOVAL OF EXISTING FENCE
RTE 289 STA 451+38, 106' LT - RTE 289 STA 451+61, 100' RT

AS BUILT 5/5/94 JG

NOTE: REFER TO DRAINAGE PLANS FOR DRAINAGE DETAILS

ROW PLAN

SURVEYED BY		DATE	
DRAWN BY	W. PETERSON	DATE	
TRACED BY	LUKOVITS/HECHT	DATE	

VERMONT ROUTE 289 (F.A.P.)
TOWN OF ESSEX
PROJ. WILLISTON - COLCHESTER NO. PB 033-1(2)
SHEET 44 OF 400

DATUM	
VERTICAL	N.G.V.D. 1929
HORIZONTAL	N.A.D. 1927