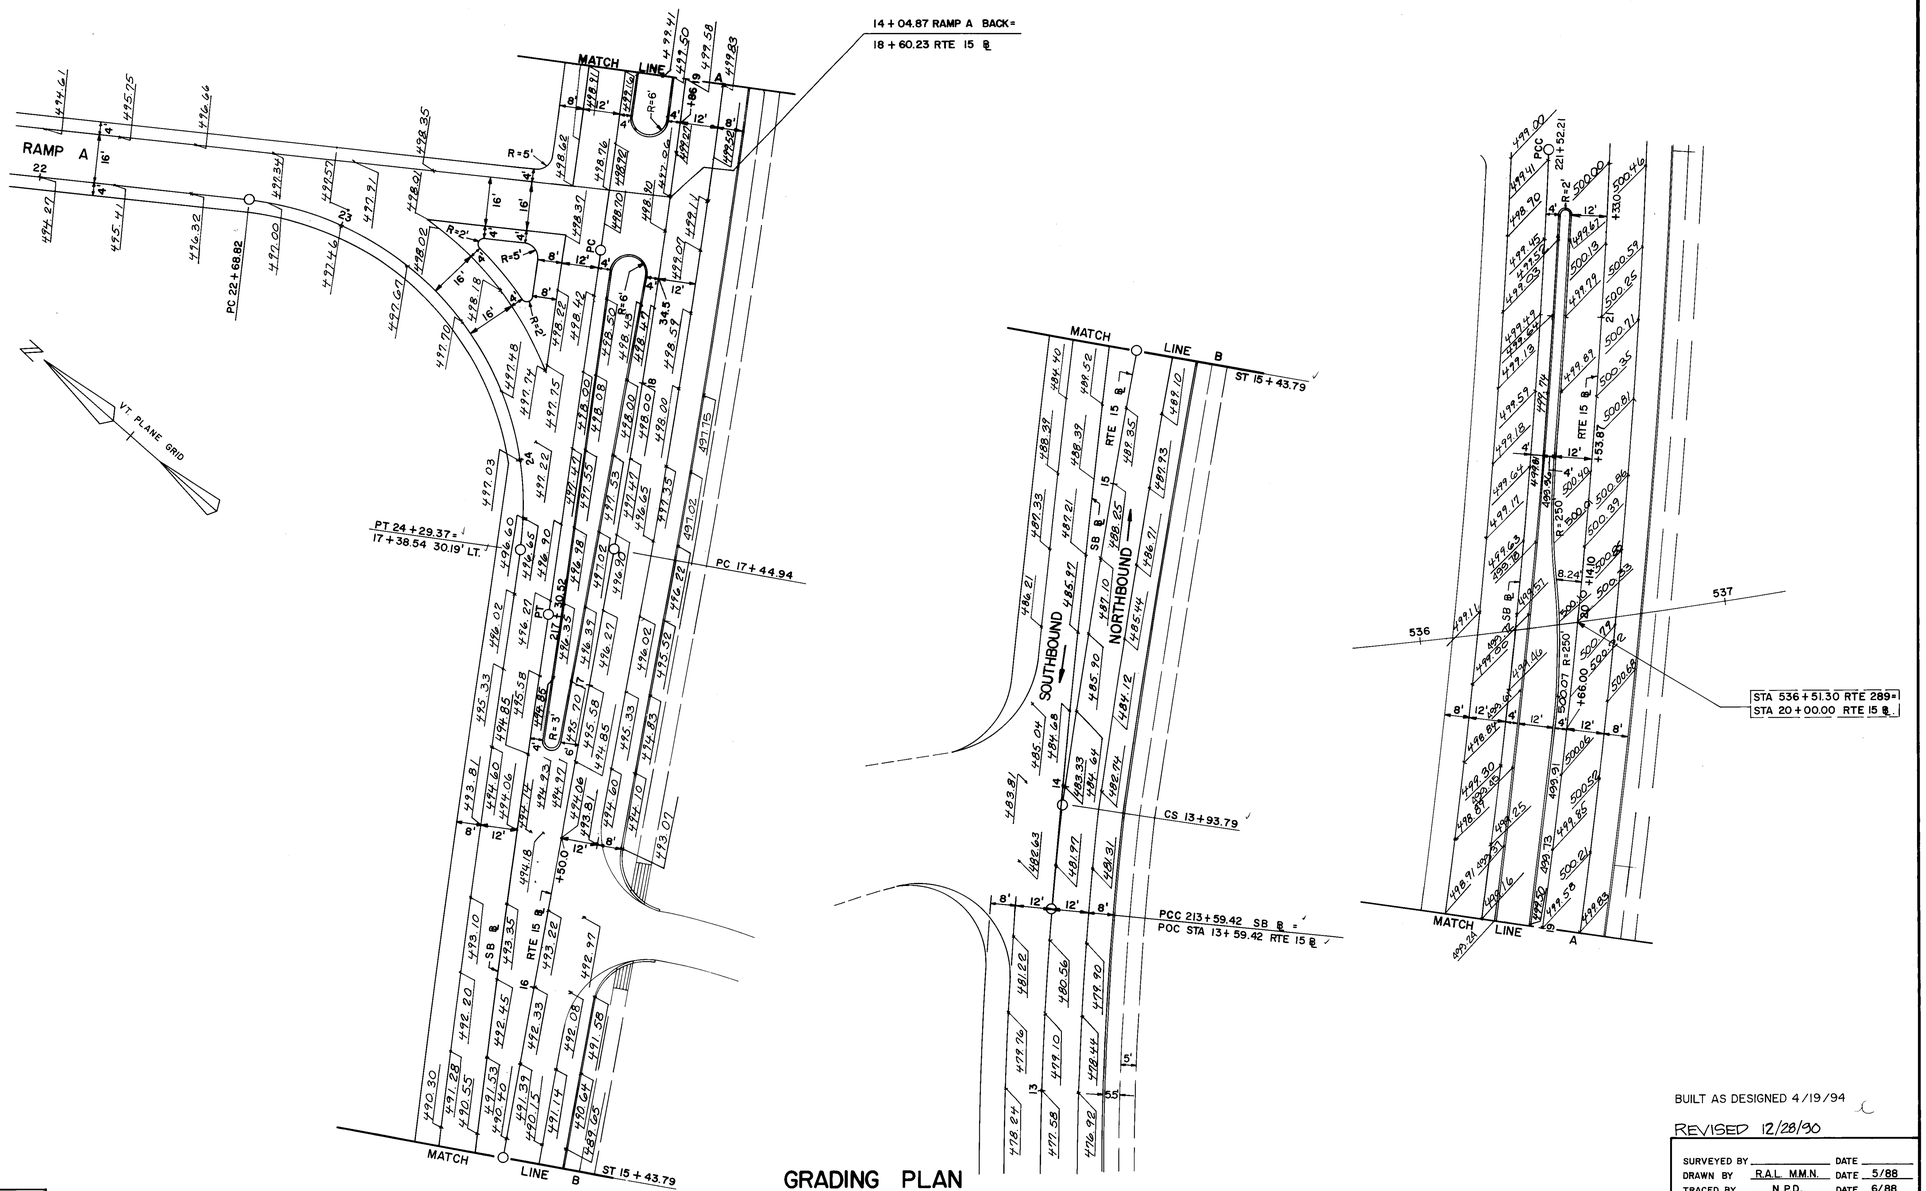

GRADING PLAN
ROUTE 15 - RAMP A

DATUM
VERTICAL _____
HORIZONTAL _____

BUILT AS DESIGNED 4/19/94

REVISED 12/28/90

SURVEYED BY _____ DATE _____
DRAWN BY R.A.L. M.M.N. DATE 5/88
TRACED BY N.P.D. DATE 6/88

VERMONT ROUTE 289 (F.A.P.)
TOWN OF ESSEX
PROJ WILLISTON COLCHESTER NO. PB 033-1 (2)
SHEET 93 OF 400