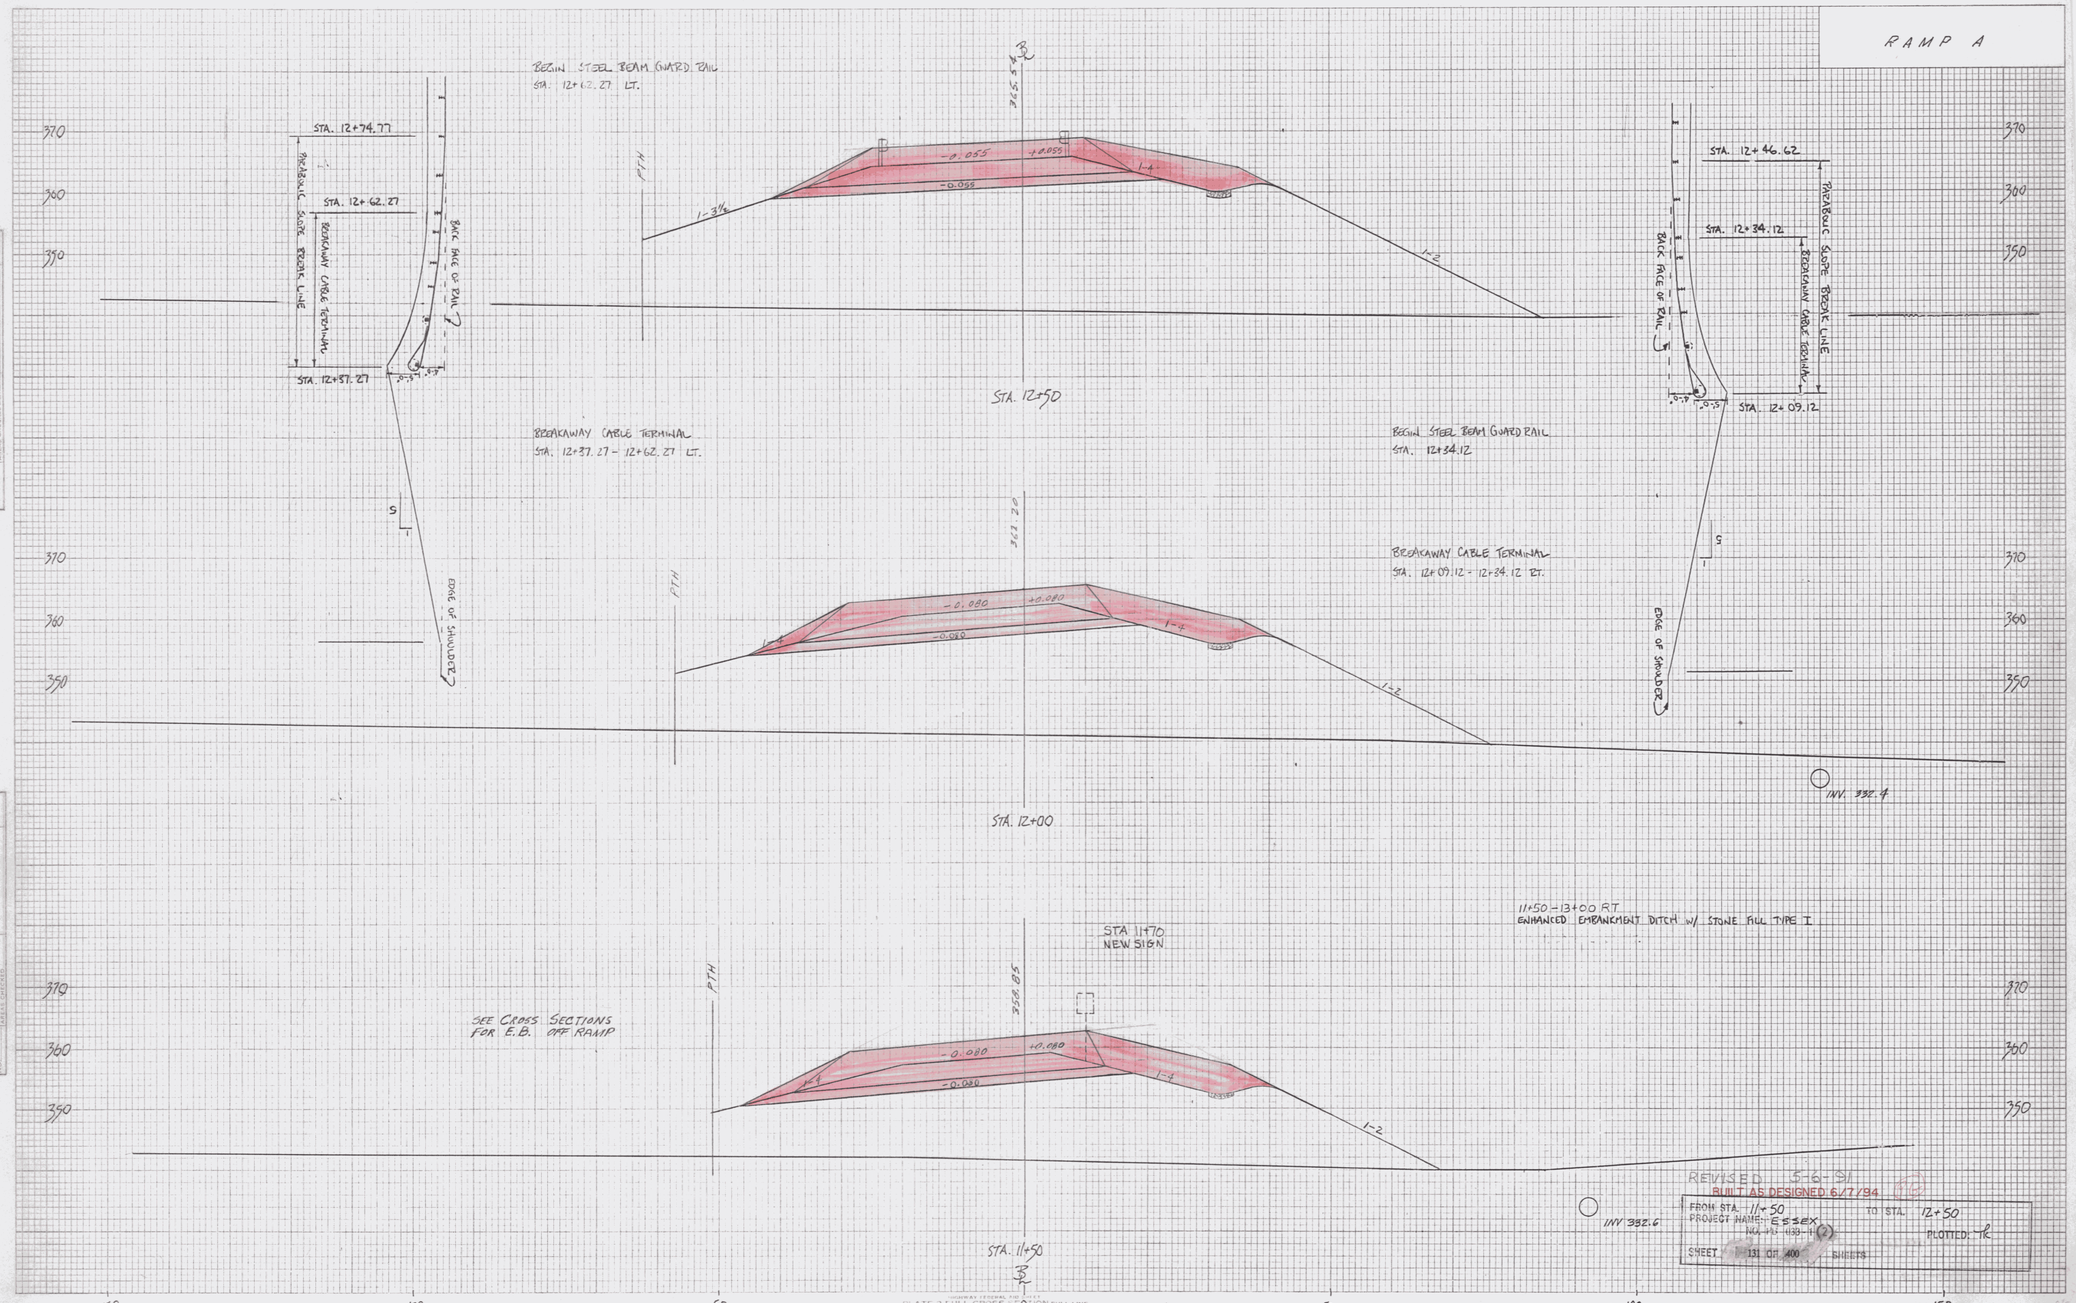
RAMP A
BEGIN STEEL BEAM GUARD RAIL
STA. 12+62.27 LT.
STA. 12+74.77
STA. 12+62.27
STA. 12+37.27
PARABOLIC SLOPE BREAK LINE
BREAKAWAY CABLE TERMINAL
BACK FACE OF RAIL
EDGE OF SHOULDER
PTH
STA. 12+50
BREAKAWAY CABLE TERMINAL
STA. 12+37.27 - 12+62.27 LT.
BEGIN STEEL BEAM GUARD RAIL
STA. 12+34.12
STA. 12+46.62
STA. 12+34.12
STA. 12+09.12
BREAKAWAY CABLE TERMINAL
STA. 12+09.12 - 12+34.12 RT.
INV. 382.4
STA. 12+00
11+50 - 13+00 RT.
ENHANCED EMBANKMENT DITCH W/ STONE FILL TYPE I
STA. 11+70
NEW SIGN
SEE CROSS SECTIONS
FOR E.B. OFF RAMP
INV. 382.6
STA. 11+50
REVISED 5-6-91
BUILT AS DESIGNED 6/7/94
FROM STA. 11+50
TO STA. 12+50
PROJECT NAME: ESSEX
PLOTTED: rk
SHEET 131 OF 400 SHEETS
PLATE 3-FULL CROSS SECTION-FULL LINE