RAMP A

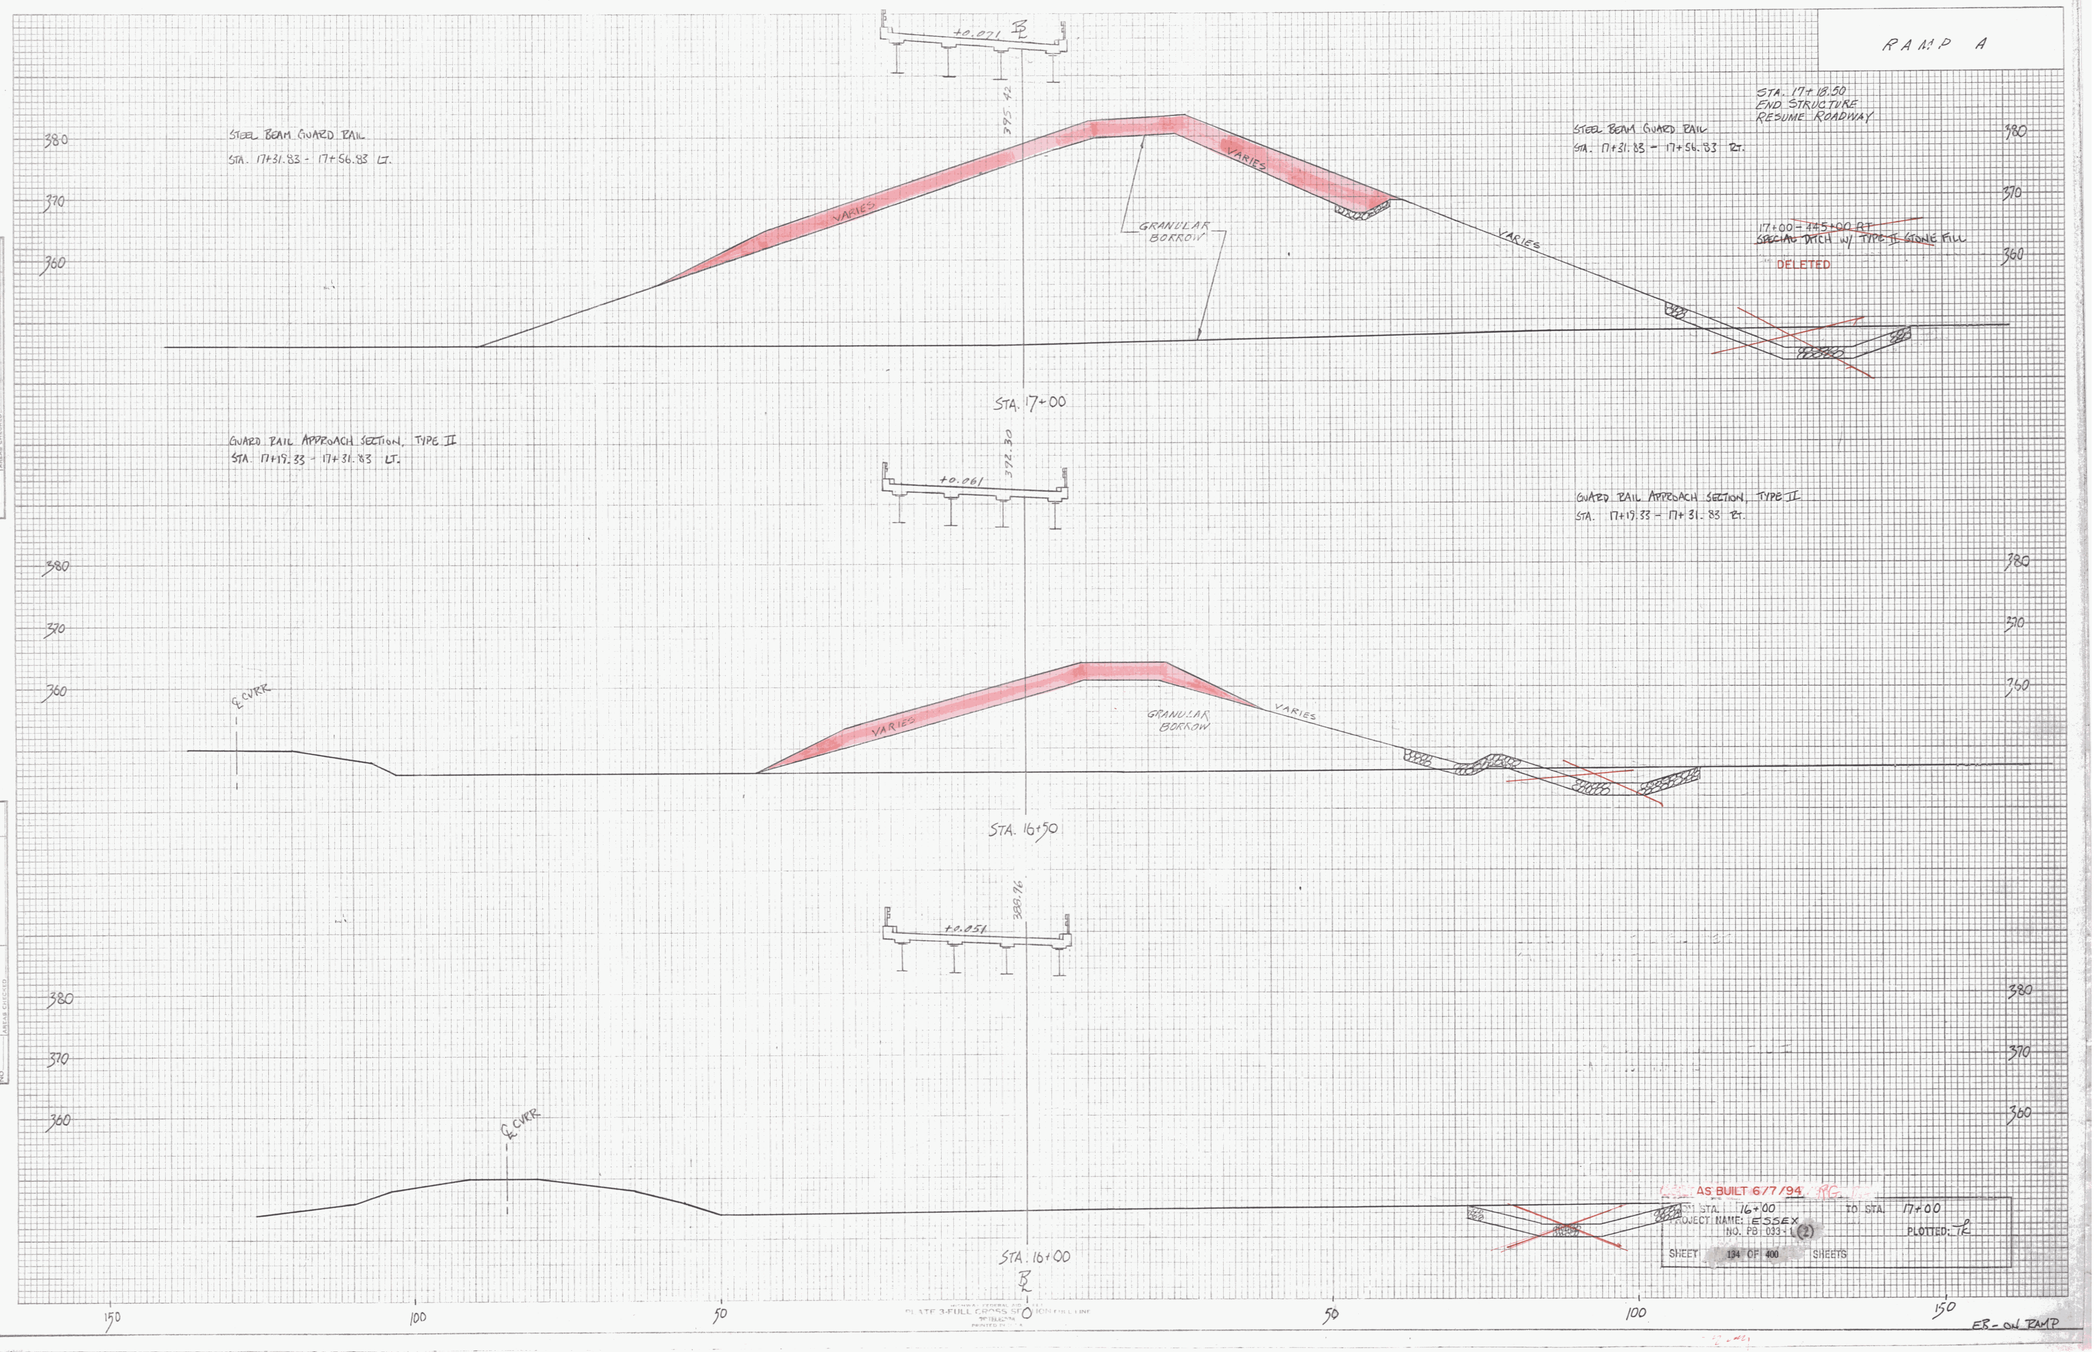

FINAL SURVEY — DATE — BY — SURVEYED — PLOTTED — TEMPLATE — AREAS — AREAS CHECKED — NOTE BOOK — NO.

ORIGINAL SURVEY — DATE — BY — SURVEYED — PLOTTED — TEMPLATE — AREAS — AREAS CHECKED — NOTE BOOK — NO.

AS BUILT 6/7/94 HC

STA. 16+00 TO STA. 17+00

PROJECT NAME: ESSEX

NO. FS 033-1 (2)

PLOTTED: R

SHEET 134 OF 400 SHEETS

PLATE 3-FULL CROSS SECTION FILL LINE

ER-ON RAMP