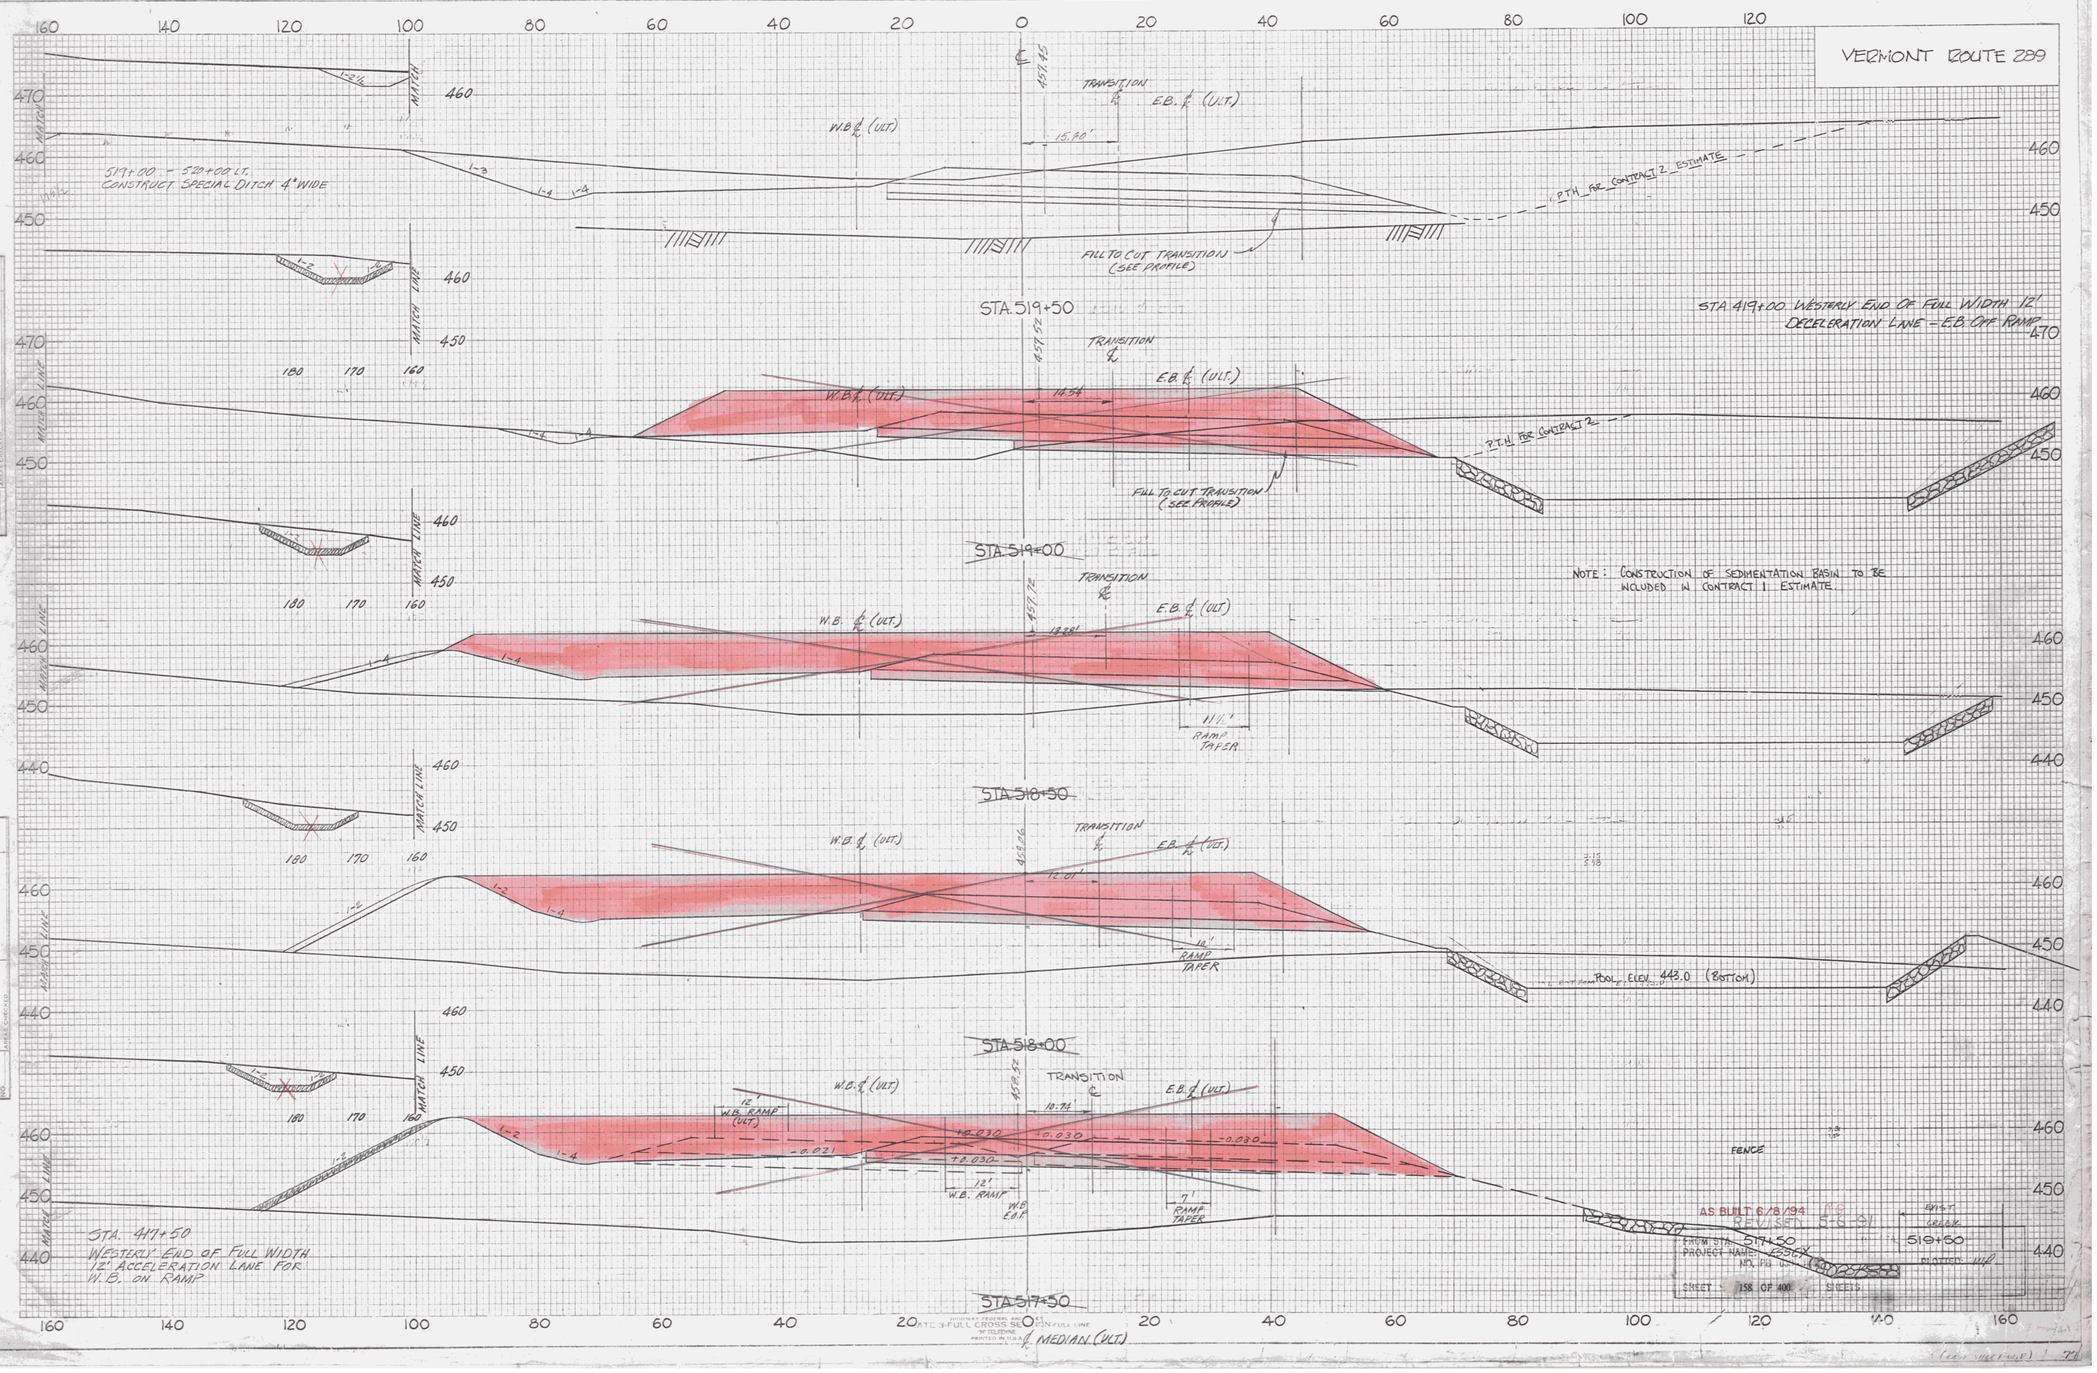
VERMONT ROUTE 289
STA. 519+00 - 520+00 LT.
CONSTRUCT SPECIAL DITCH 4' WIDE
TRANSITION
E.B. ℄ (ULT.)
W.B. ℄ (ULT.)
15.80'
P.T.H. FOR CONTRACT 2 ESTIMATE
FILL TO CUT TRANSITION (SEE PROFILE)
STA. 519+50
STA. 419+00 WESTERLY END OF FULL WIDTH 12' DECELERATION LANE - E.B. OFF RAMP
14.54
STA. 519+00
NOTE: CONSTRUCTION OF SEDIMENTATION BASIN TO BE INCLUDED IN CONTRACT 1 ESTIMATE.
13.88'
11½' RAMP TAPER
STA. 518+50
12.01'
10' RAMP TAPER
POOL, ELEV. 443.0 (BOTTOM)
STA. 518+00
W.B. RAMP (ULT.)
10.74'
12' W.B. RAMP
7' RAMP TAPER
FENCE
STA. 417+50
WESTERLY END OF FULL WIDTH 12' ACCELERATION LANE FOR W.B. ON RAMP
STA. 517+50
MATCH LINE
℄ MEDIAN (ULT.)
AS BUILT 6/8/94
SHEET 158 OF 400 SHEETS