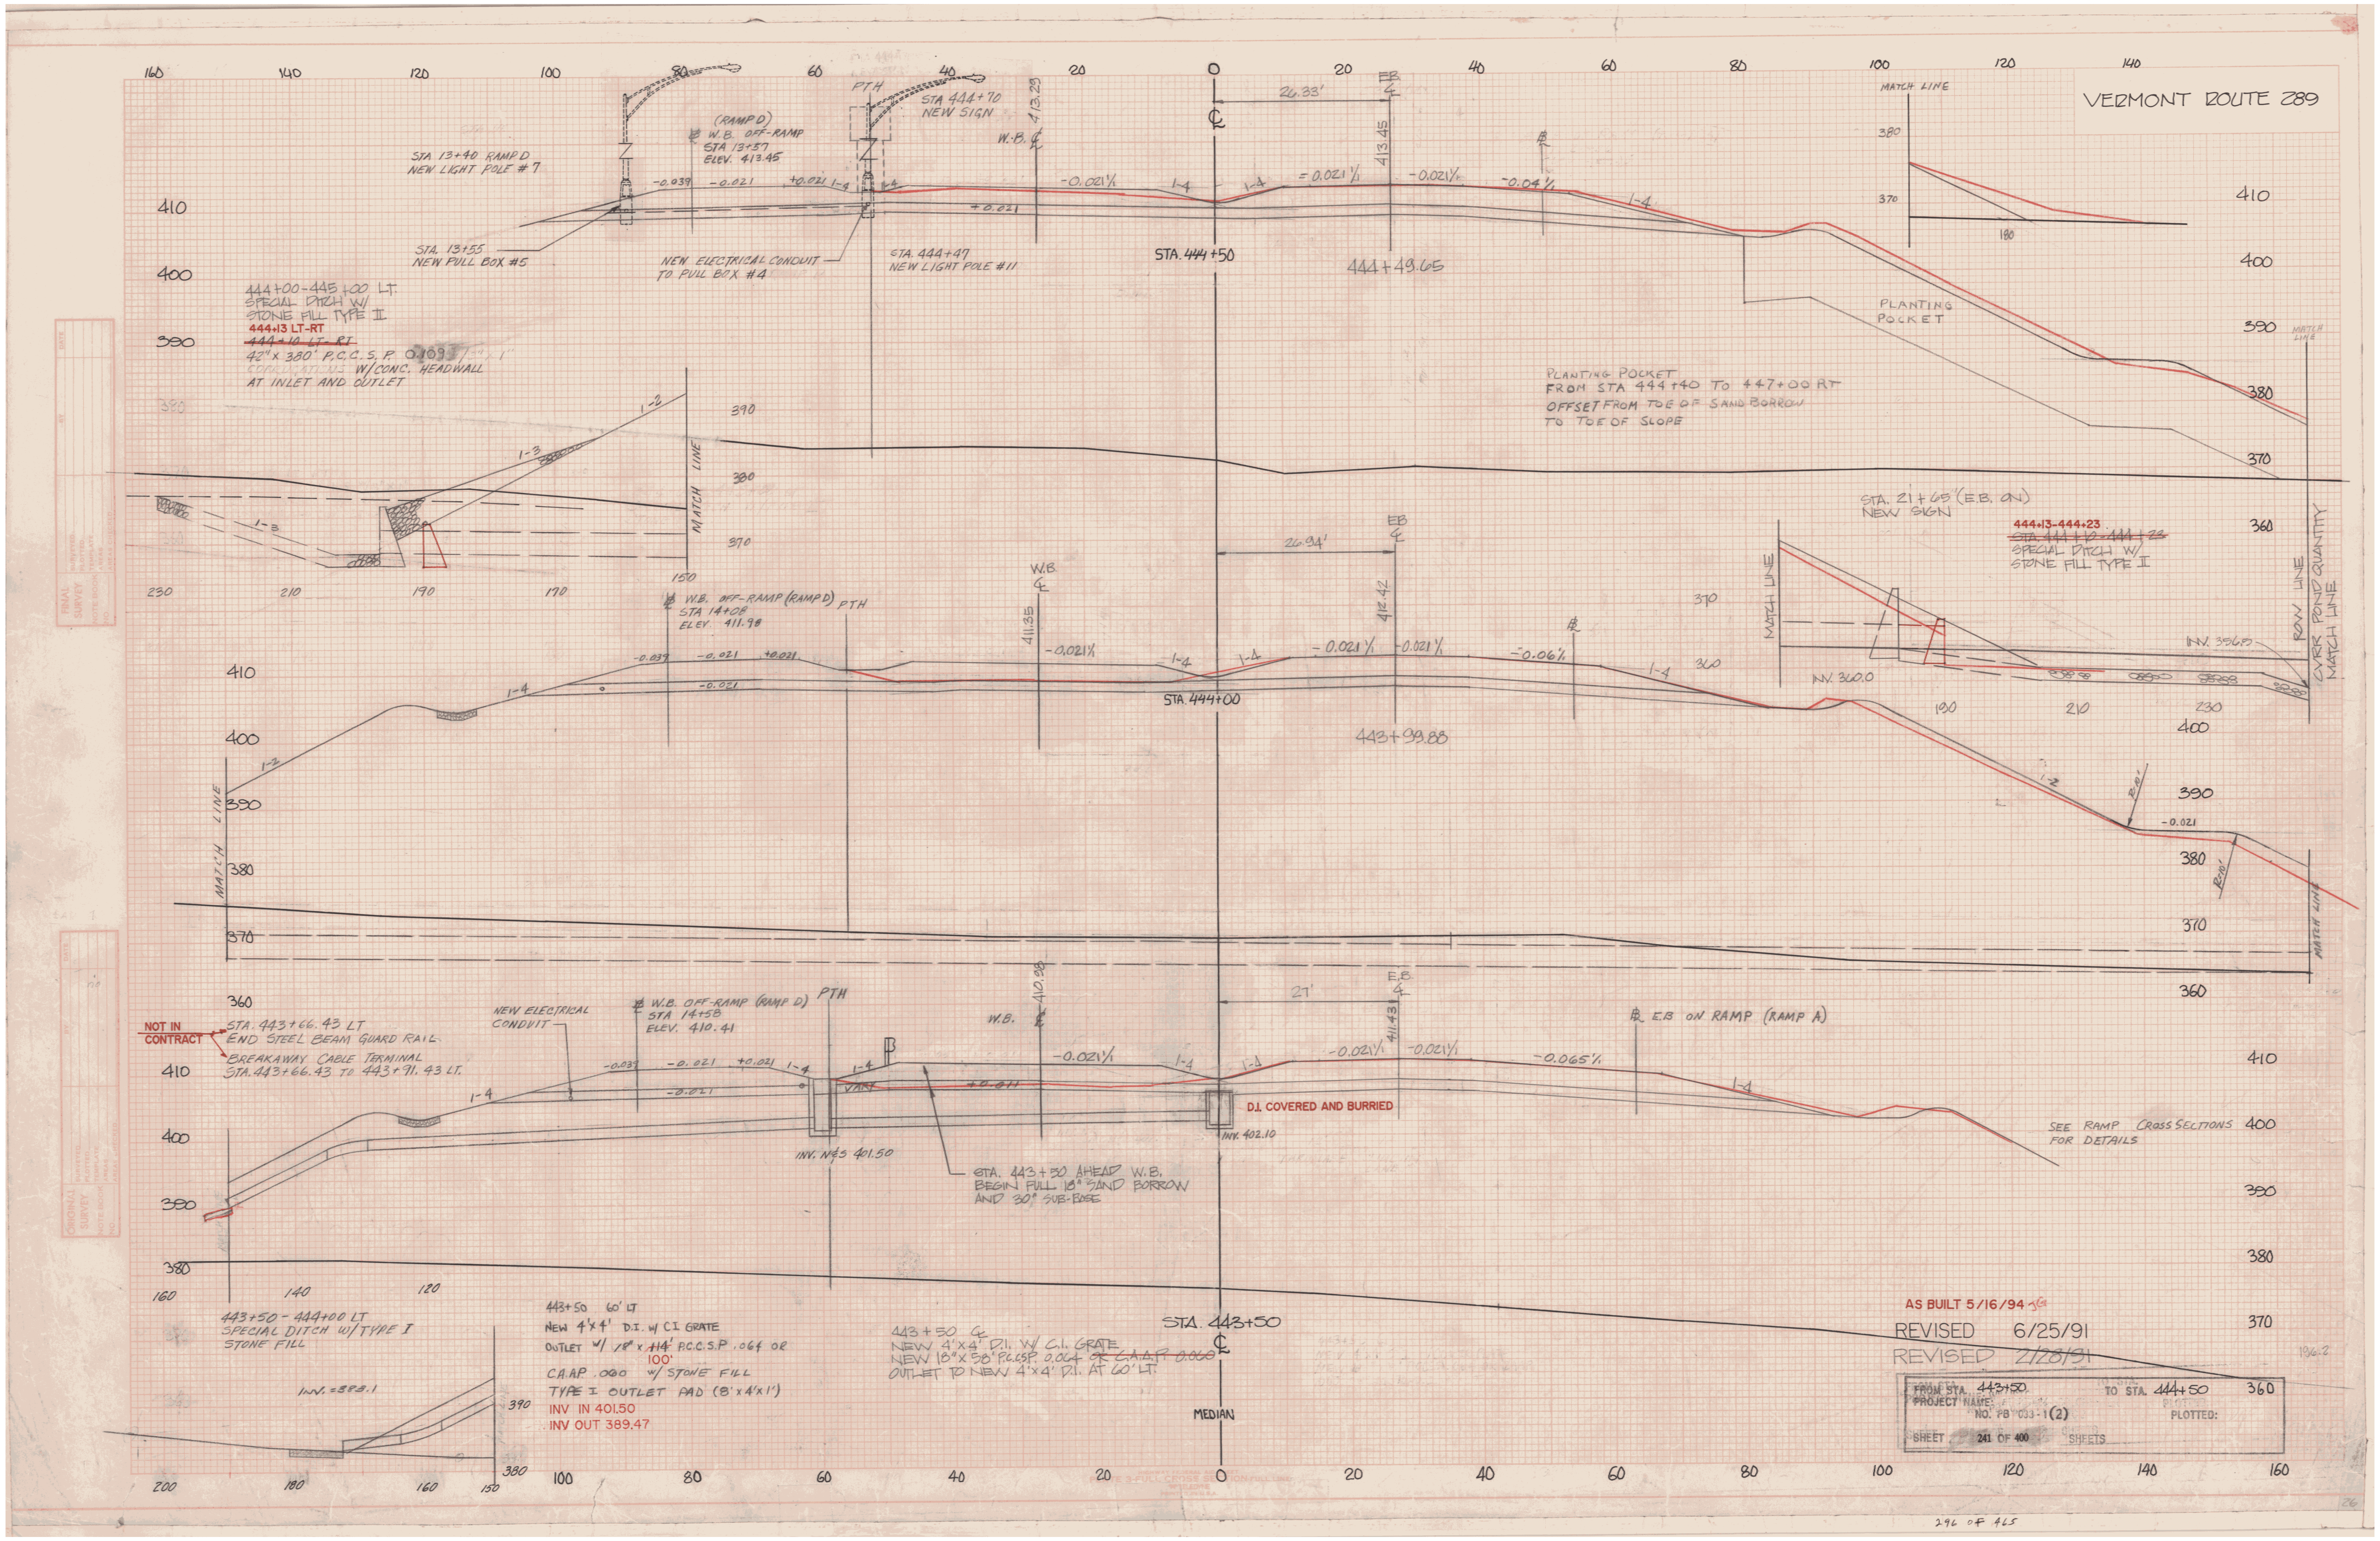
VERMONT ROUTE 289
STA 13+40 RAMP D
NEW LIGHT POLE #7
(RAMP D)
W.B. OFF-RAMP
STA 13+57
ELEV. 413.45
STA 444+70
NEW SIGN
PTH
W.B.
STA. 13+55
NEW PULL BOX #5
NEW ELECTRICAL CONDUIT
TO PULL BOX #4
STA. 444+47
NEW LIGHT POLE #11
STA. 444+50
444+49.65
26.33'
-0.021%
-0.04%
1-4
444+00-445+00 LT.
SPECIAL DITCH W/
STONE FILL TYPE II
444+13 LT-RT
42" x 380' P.C.C.S.P. 0.109
W/CONC. HEADWALL
AT INLET AND OUTLET
PLANTING POCKET
PLANTING POCKET
FROM STA. 444+40 TO 447+00 RT
OFFSET FROM TOE OF SAND BORROW
TO TOE OF SLOPE
MATCH LINE
STA. 21+65 (E.B. ON)
NEW SIGN
444+13-444+23
SPECIAL DITCH W/
STONE FILL TYPE II
INV. 362.0
INV. 356.5
ROW LINE
CURB POND QUANTITY
MATCH LINE
W.B. OFF-RAMP (RAMP D)
STA 14+08
ELEV. 411.98
24.94'
E.B.
STA 444+00
443+99.88
-0.06%
NOT IN
CONTRACT
STA. 443+66.43 LT
END STEEL BEAM GUARD RAIL
BREAKAWAY CABLE TERMINAL
STA. 443+66.43 TO 443+91.43 LT.
NEW ELECTRICAL
CONDUIT
W.B. OFF-RAMP (RAMP D)
STA 14+58
ELEV. 410.41
27'
E.B. ON RAMP (RAMP A)
-0.065%
D.I. COVERED AND BURRIED
INV. 402.10
INV. N.S 401.50
STA. 443+50 AHEAD W.B.
BEGIN FULL 18" SAND BORROW
AND 30" SUB-BASE
SEE RAMP CROSS SECTIONS
FOR DETAILS
443+50 - 444+00 LT
SPECIAL DITCH W/ TYPE I
STONE FILL
443+50 60' LT
NEW 4'x4' D.I. W/ C.I. GRATE
OUTLET W/ 18" x 114' P.C.C.S.P. .064 OR
100'
C.A.A.P. .080 W/ STONE FILL
TYPE I OUTLET PAD (8' x 4' x 1')
INV IN 401.50
INV OUT 389.47
443+50 ℄
NEW 4'x4' D.I. W/ C.I. GRATE
NEW 18" x 58' P.C.C.S.P. 0.064
OUTLET TO NEW 4'x4' D.I. AT 60' LT.
STA. 443+50
MEDIAN
AS BUILT 5/16/94
REVISED 6/25/91
REVISED 2/28/91
FROM STA. 443+50
TO STA. 444+50
PROJECT NAME:
NO. PB 033-1(2)
PLOTTED:
SHEET 241 OF 400 SHEETS
246 OF 465