RAMP A

RTE 2A

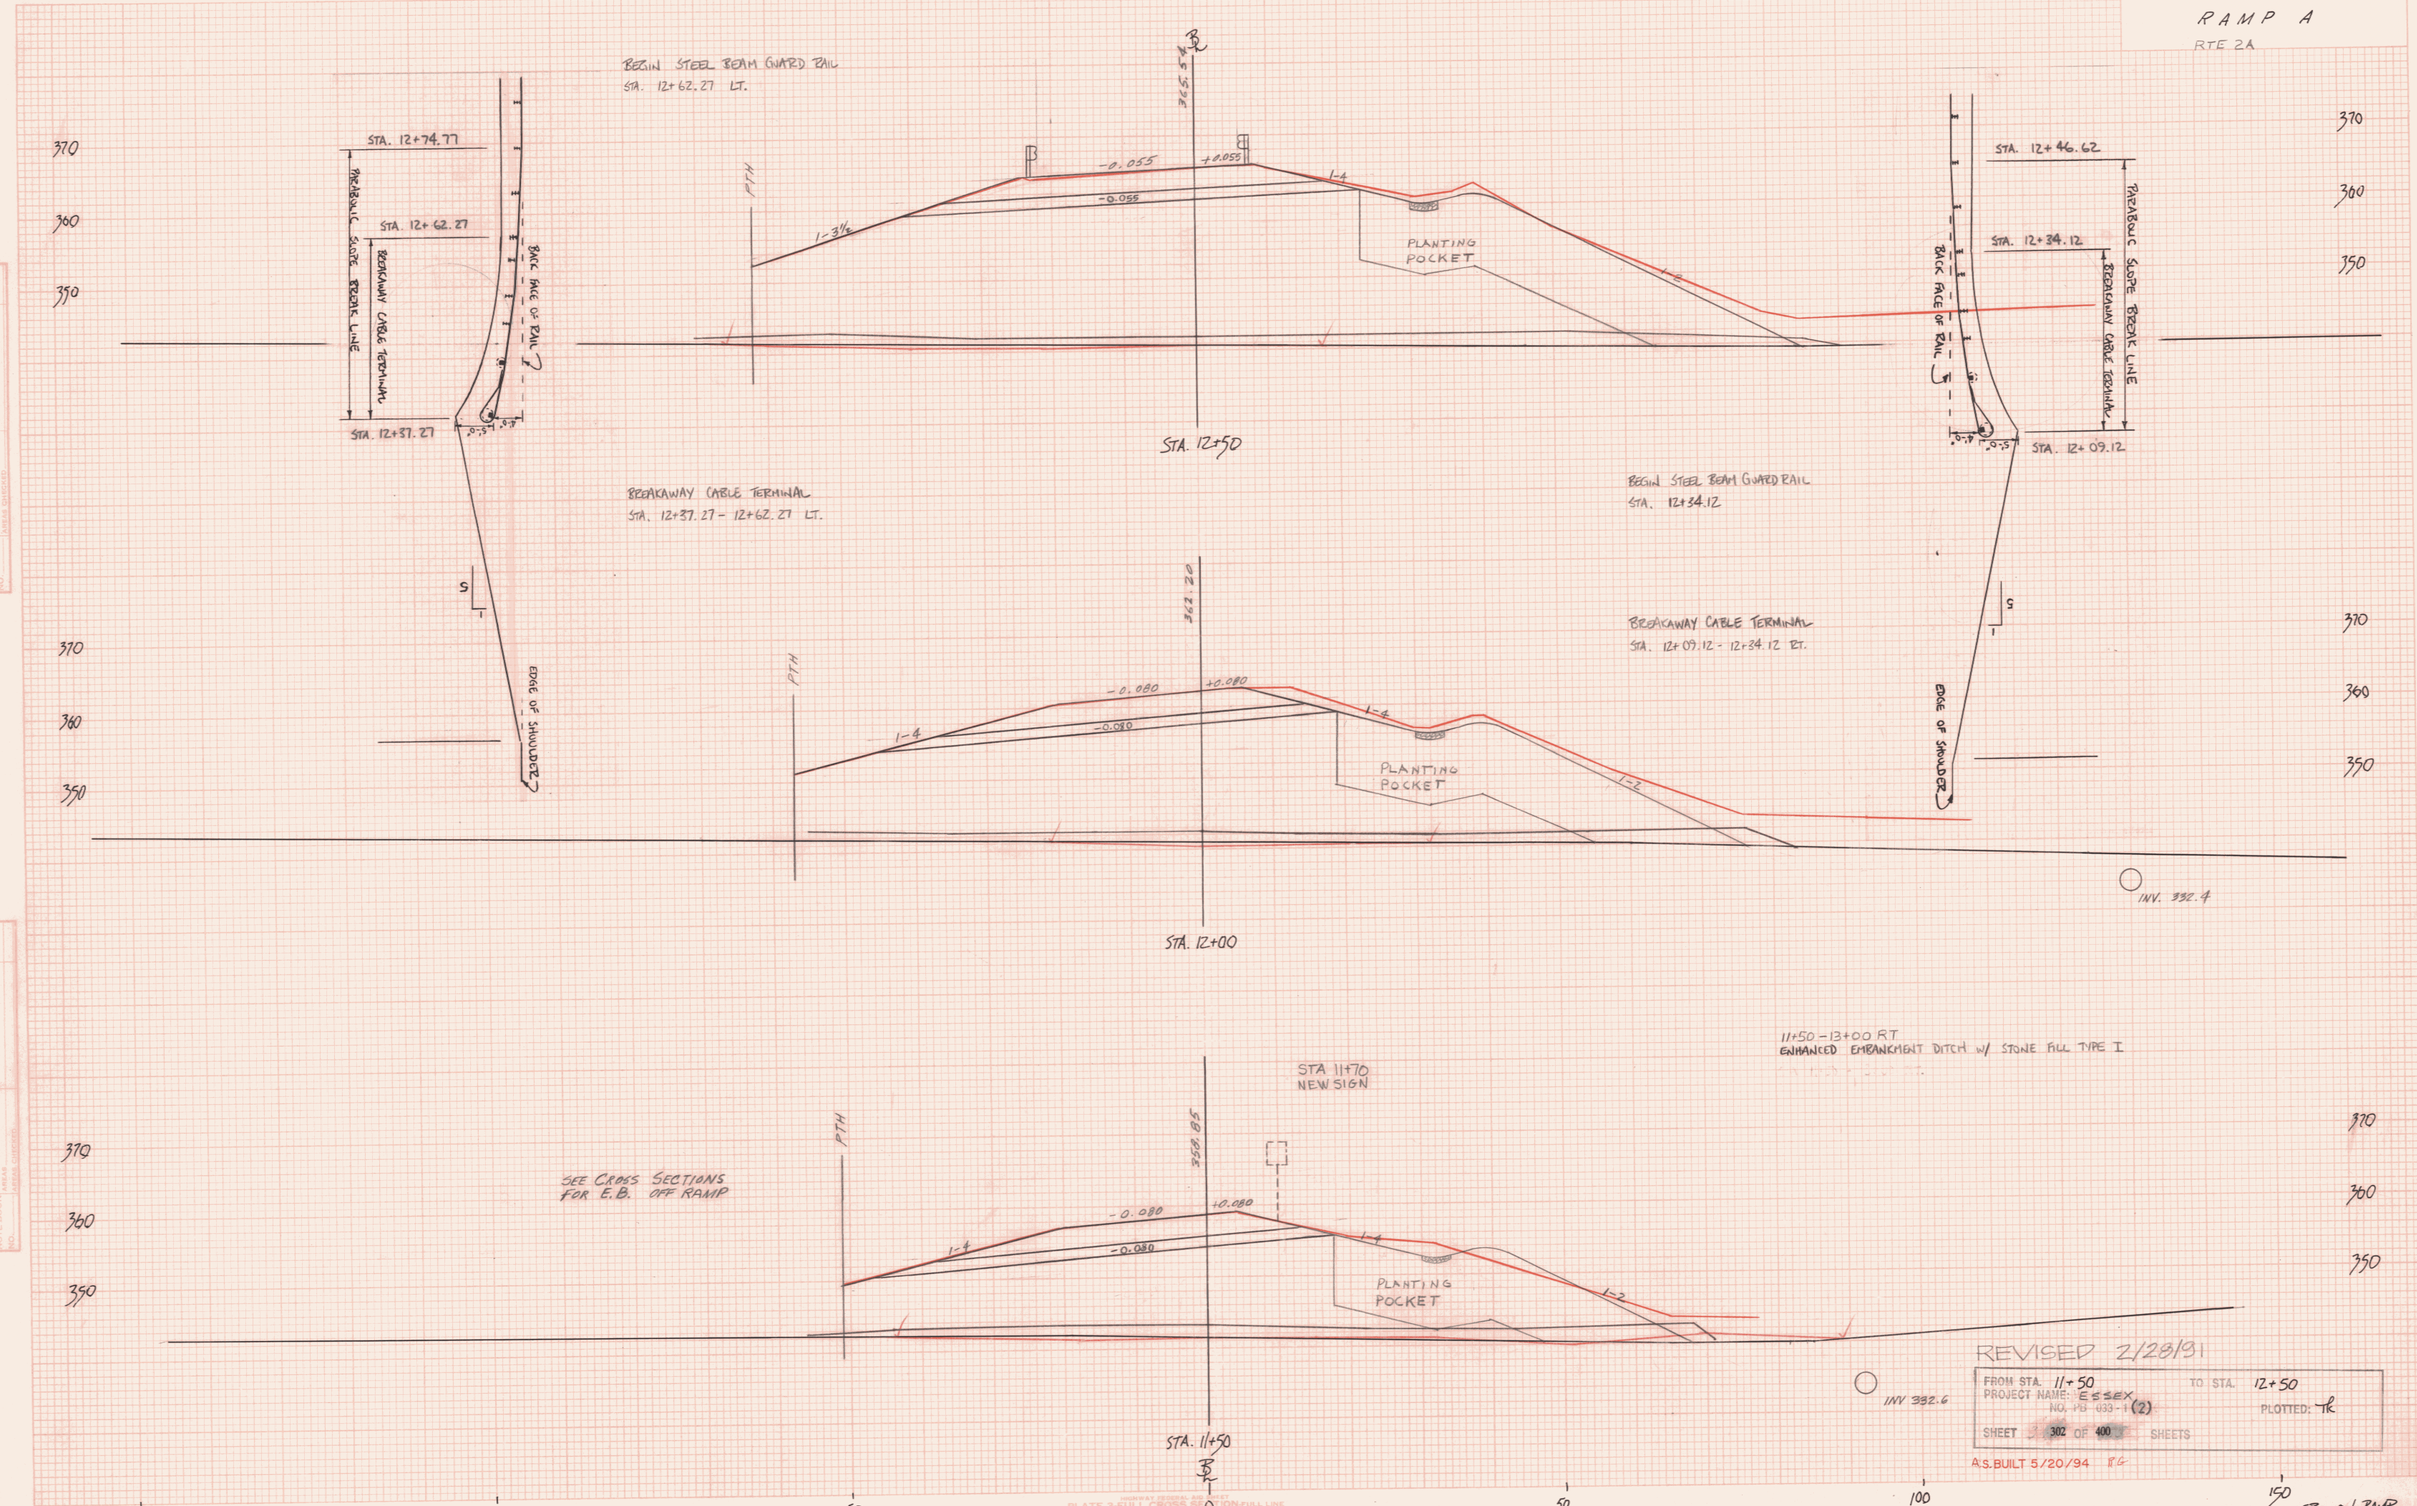

REVISED 2/28/91

FROM STA. 11+50 TO STA. 12+50

PROJECT NAME: ESSEX

NO. PB 033-1 (2)

PLOTTED: TR

SHEET 302 OF 400 SHEETS

A.S.BUILT 5/20/94 RG

FINAL SURVEY — SURVEYED, PLOTTED, TEMPLATE, AREAS, AREAS DISPOSED; NOTE BOOK NO.; BY; DATE

ORIGINAL SURVEY — SURVEYED, PLOTTED, TEMPLATE, AREAS, AREAS DISPOSED; NOTE BOOK NO.; BY; DATE

HARRY J. GERAL INC. NEW YORK
PLATE 3-FULL CROSS SECTION-FULL LINE
4" ELEVATE
PRINTED IN U.S.A.