RAMP A
RTE 2A

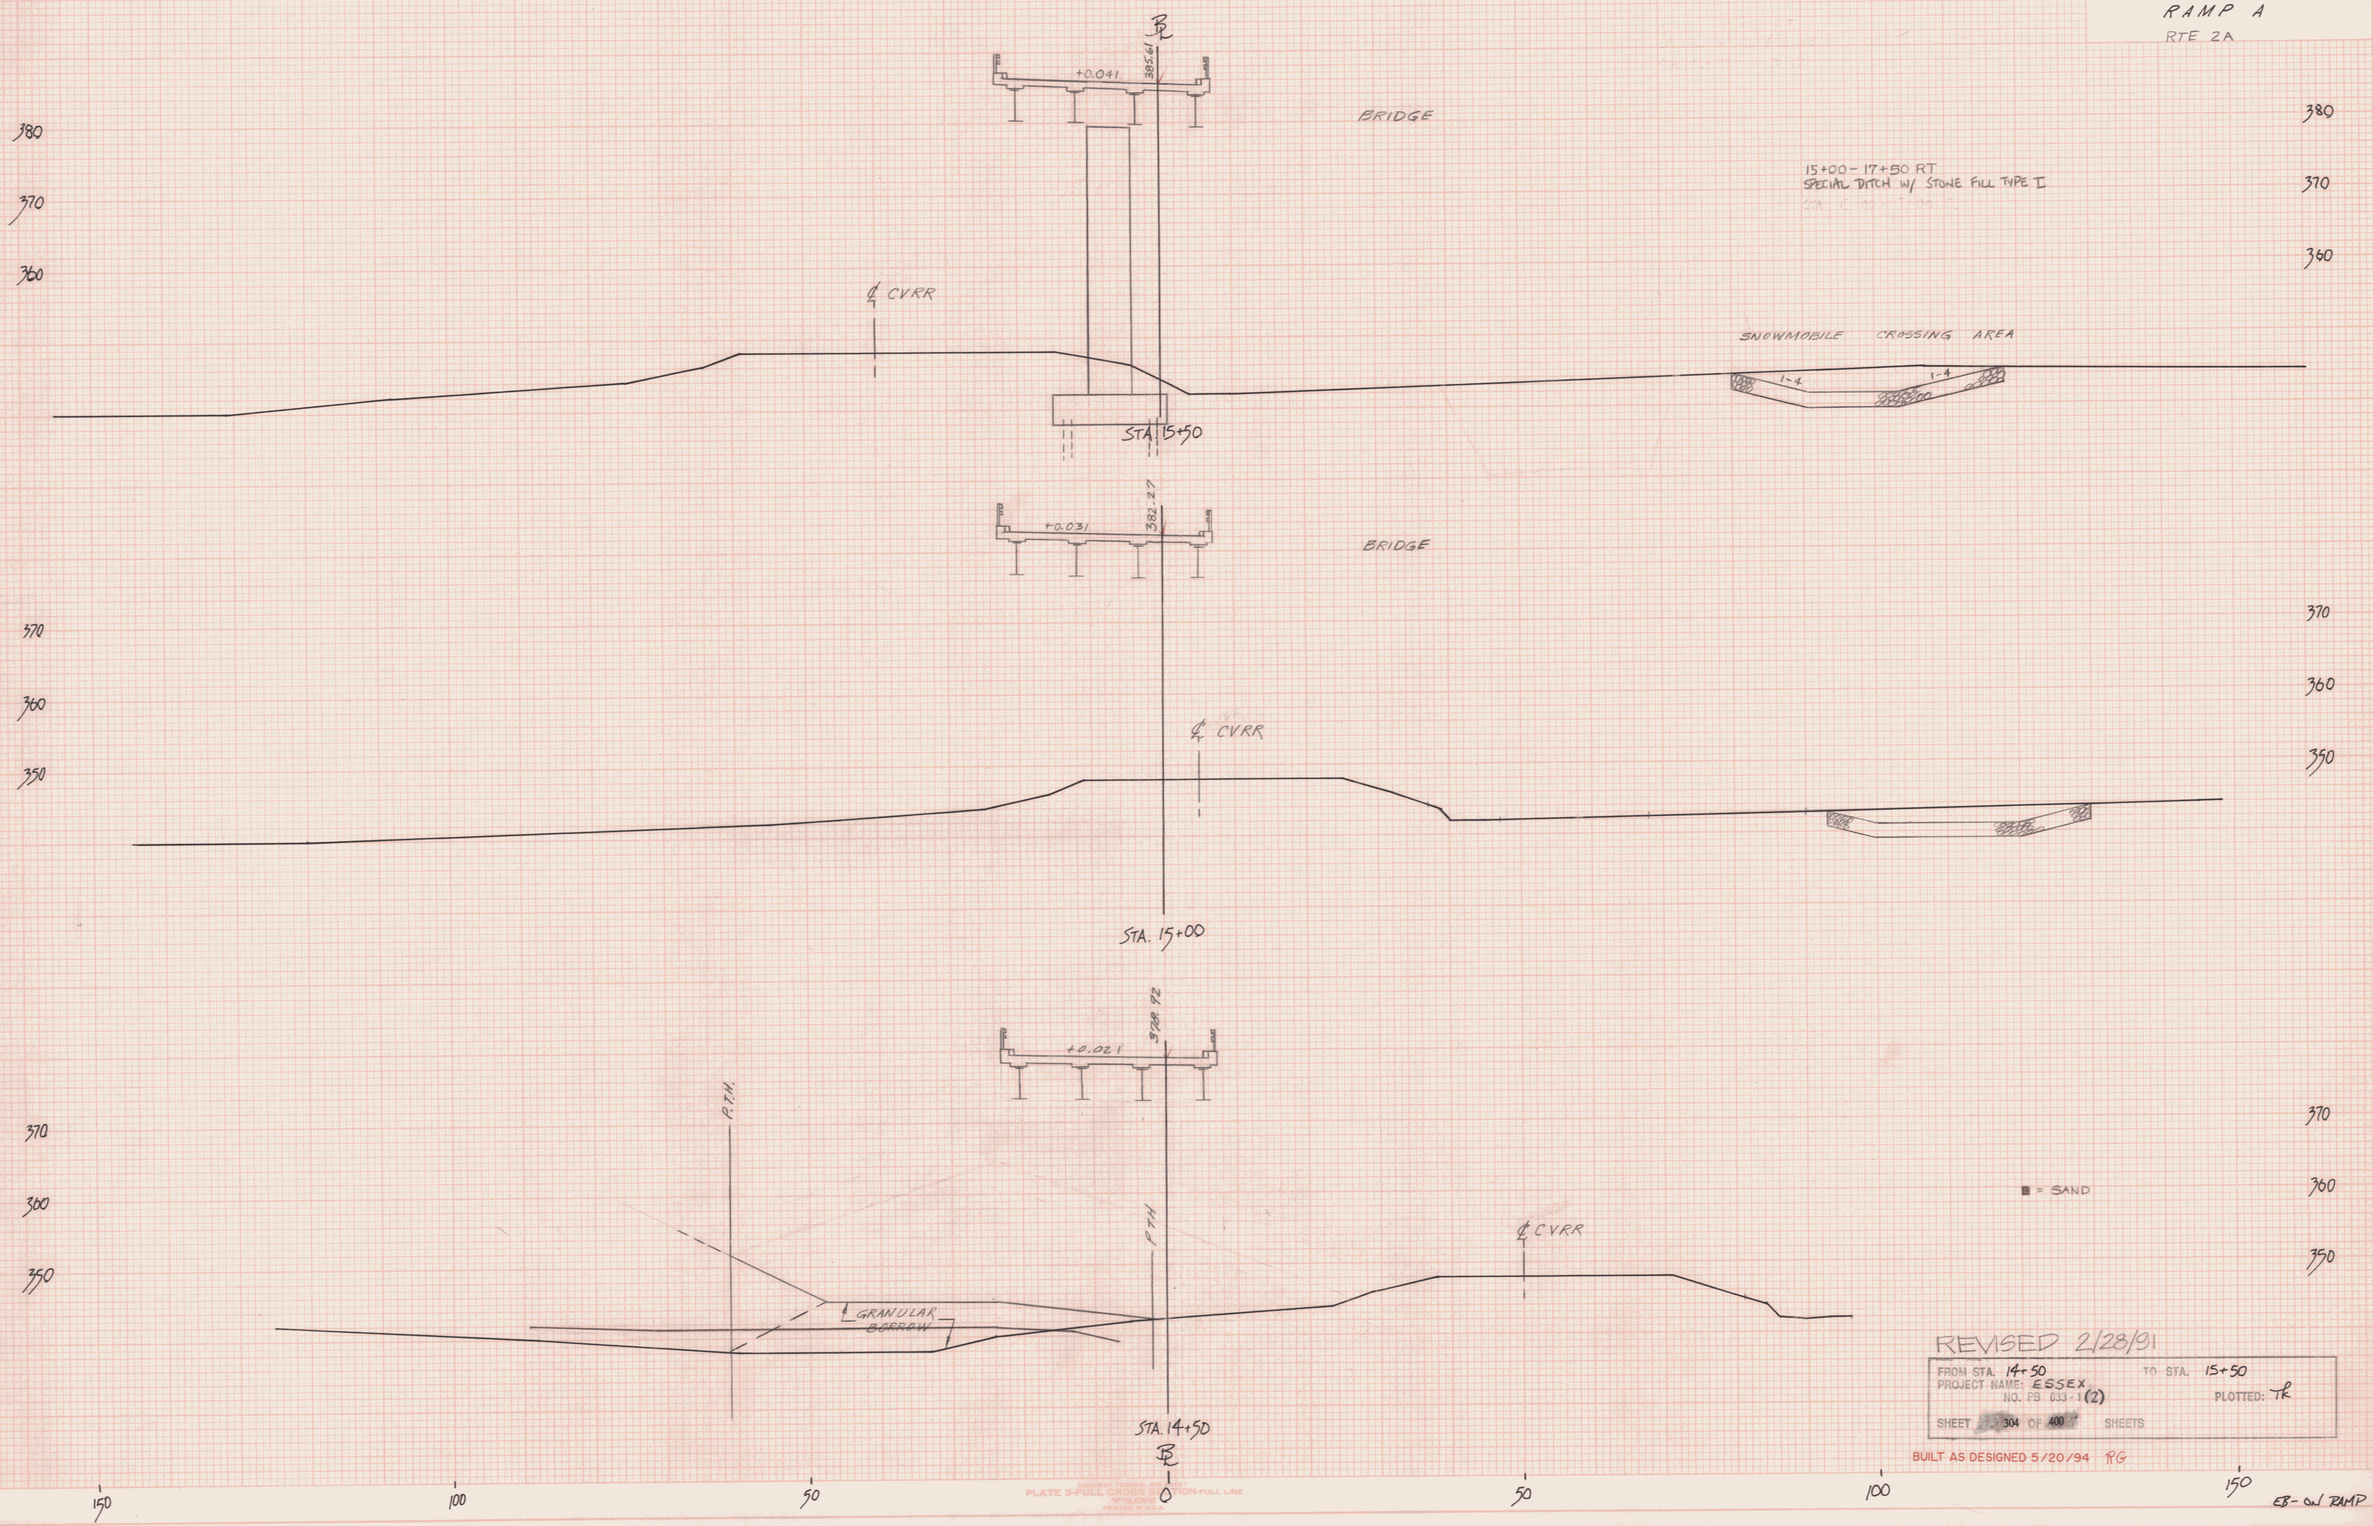

REVISED 2/28/91

FROM STA. 14+50	TO STA. 15+50
PROJECT NAME: ESSEX	
NO. FB 033-1(2)	PLOTTED: TR
SHEET 304 OF 400 SHEETS	

BUILT AS DESIGNED 5/20/94 RG

EB-ON RAMP