


RAMP D
RTE 2A

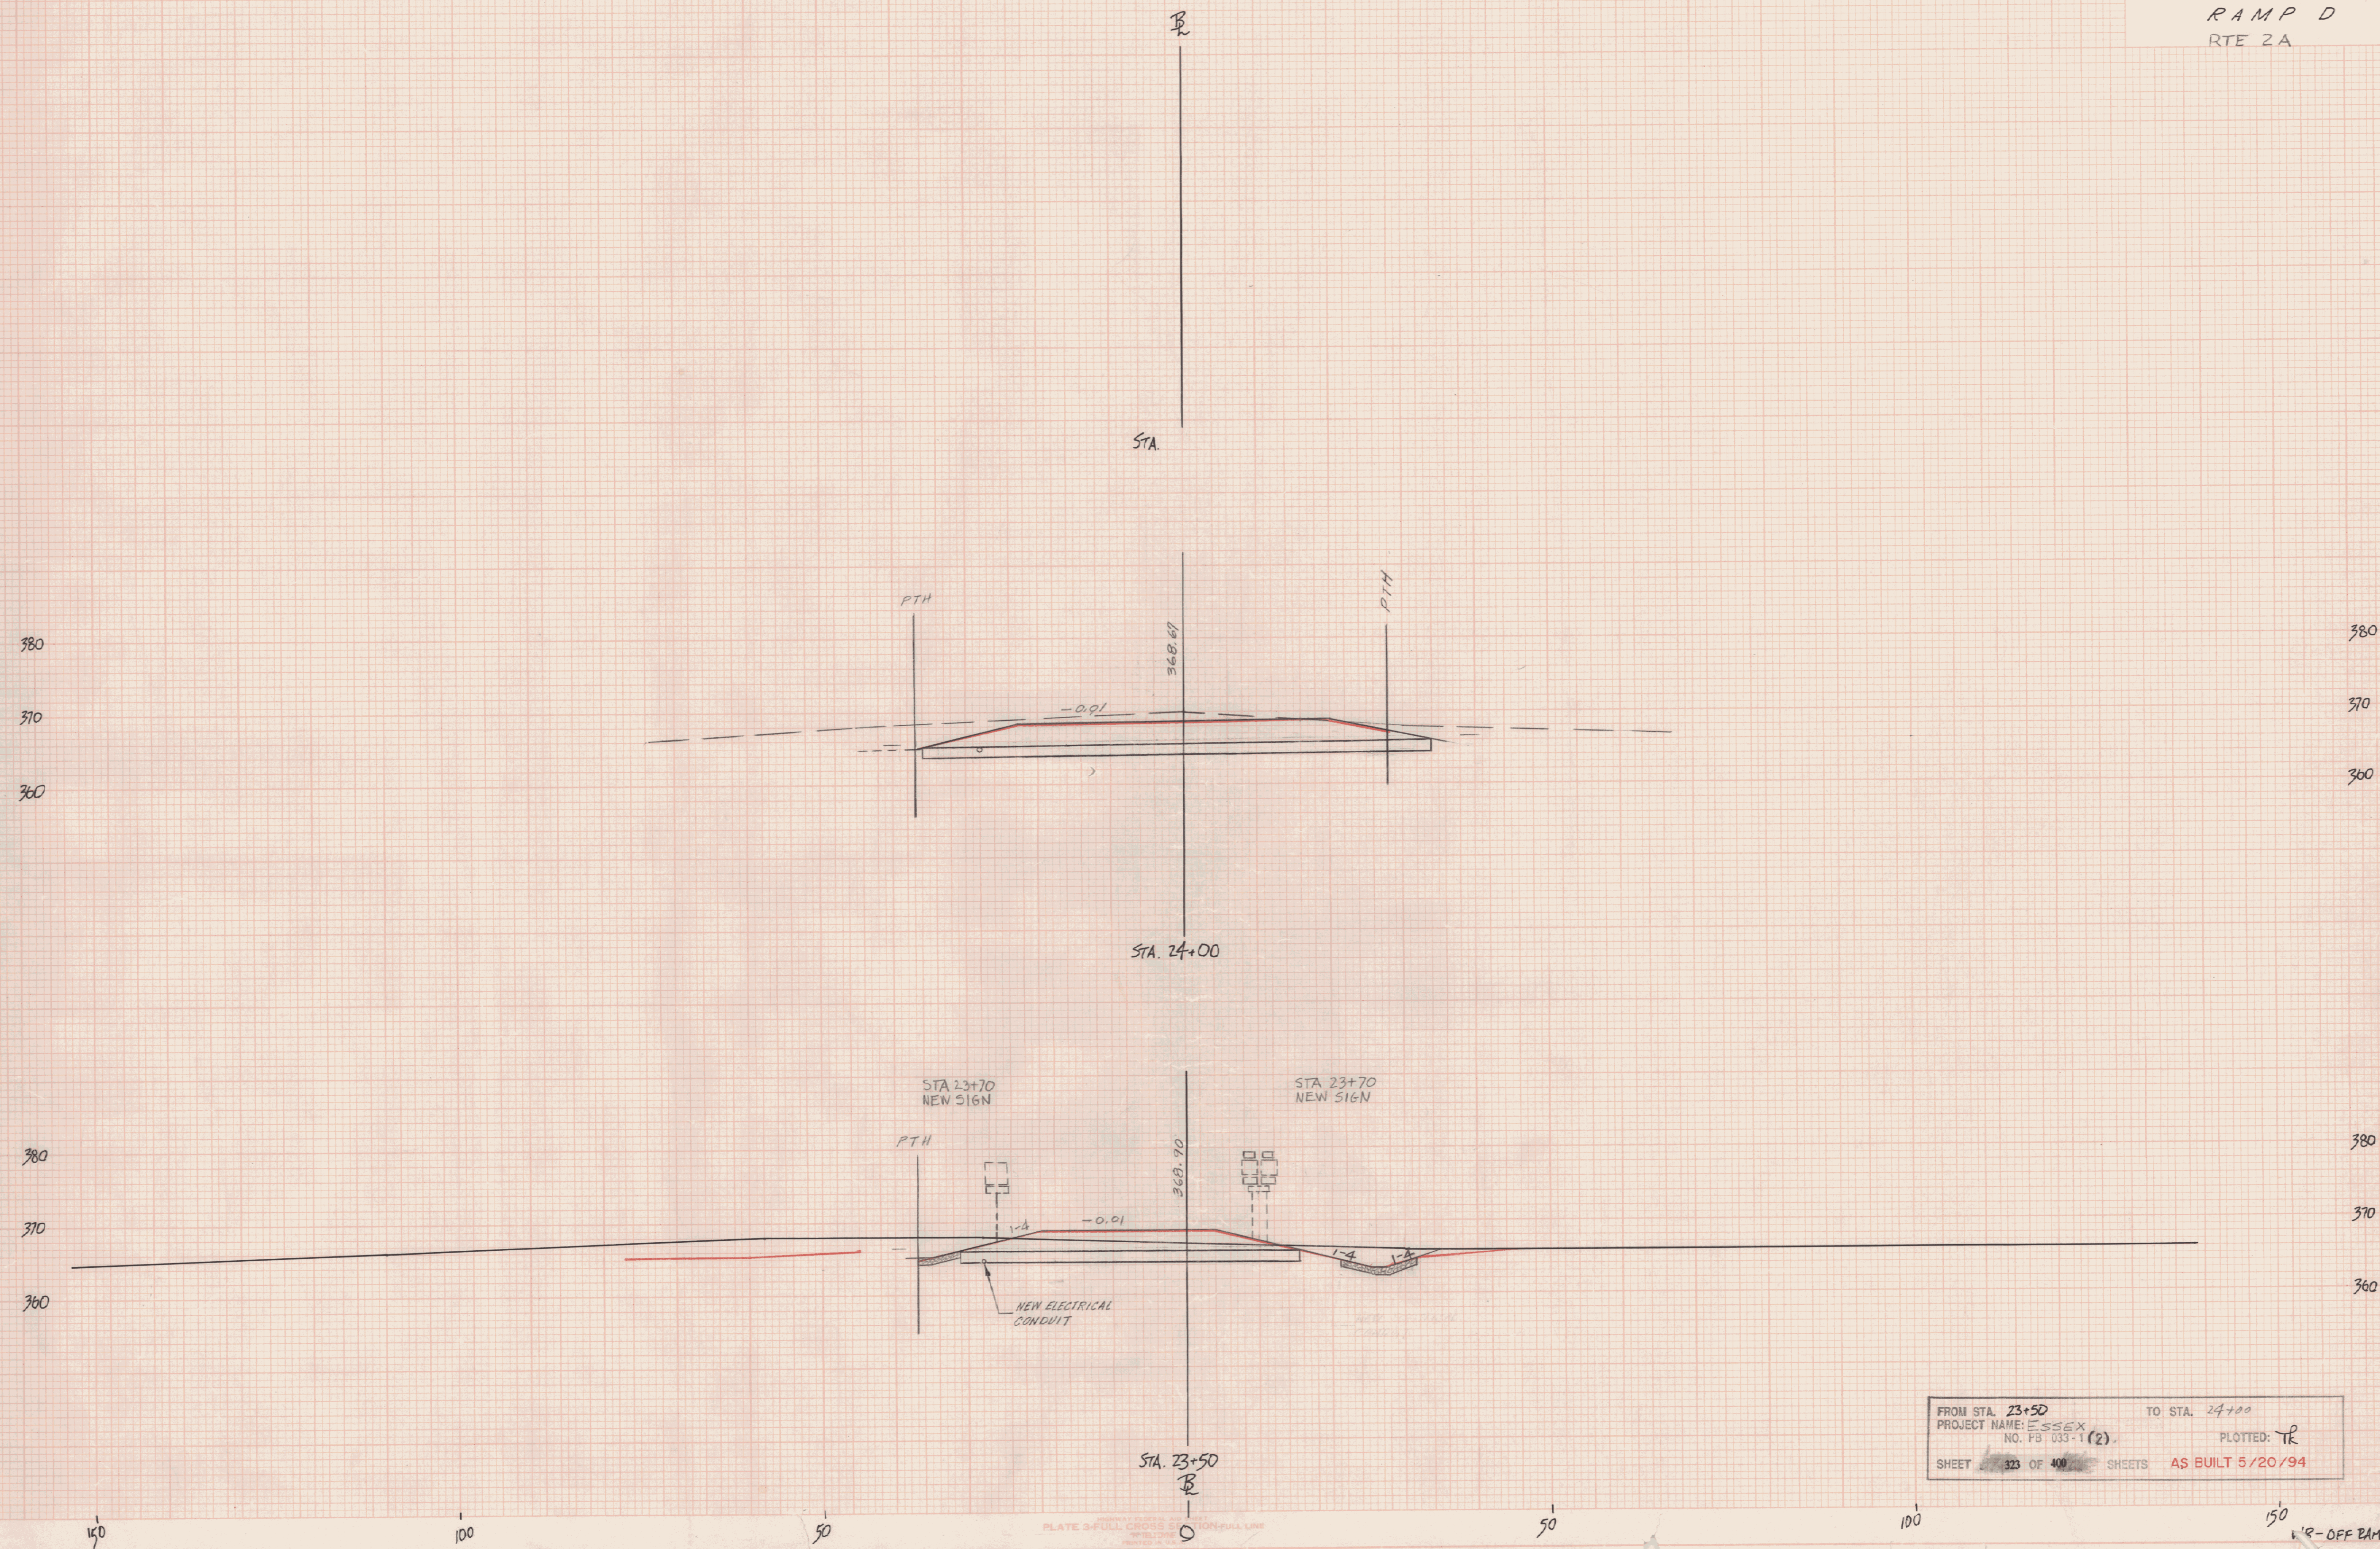

WR-OFF RAMP