


ORIGINAL SURVEY	BY	DATE
SURVEYED		
PLOTTED		
TEMPLEATE		
AREAS		
AREAS CHECKED		

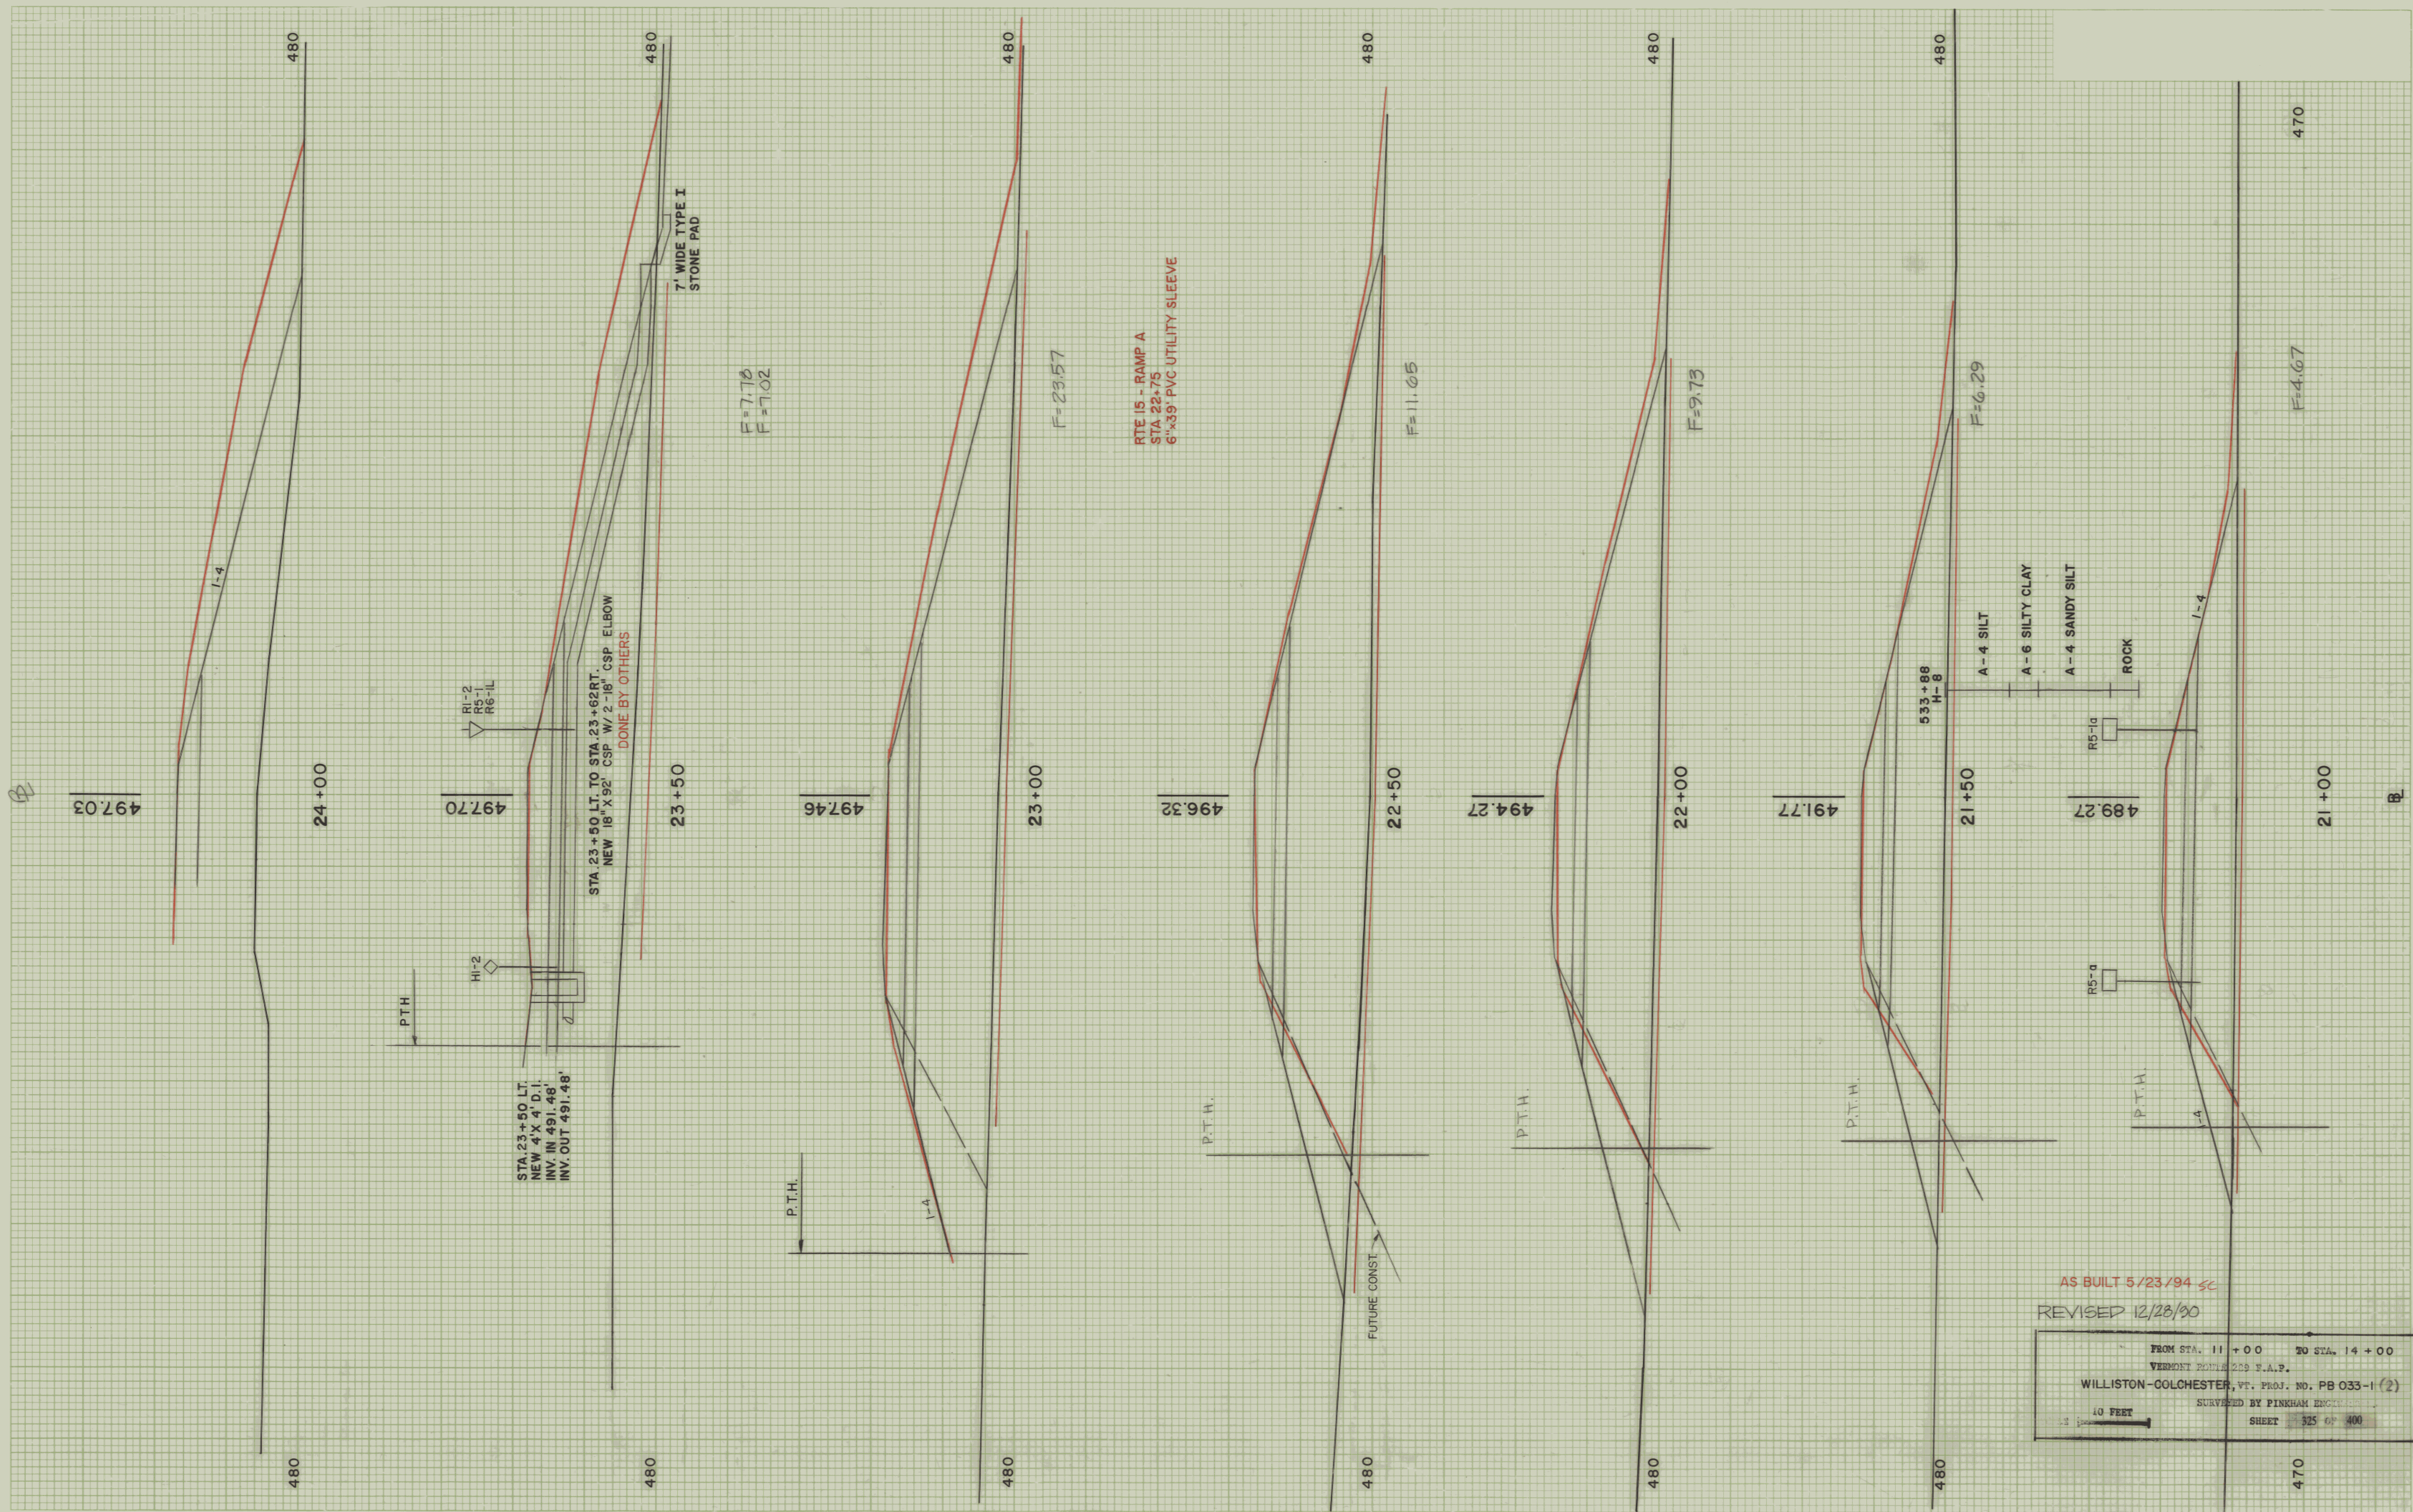

RTE 15 RAMP "A"