CENTRAL VERMONT RAILROAD

150 100 50 ℄ 50 100 150

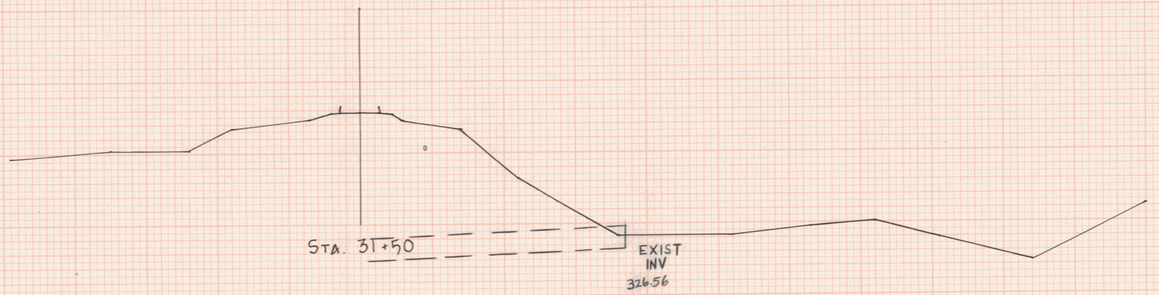

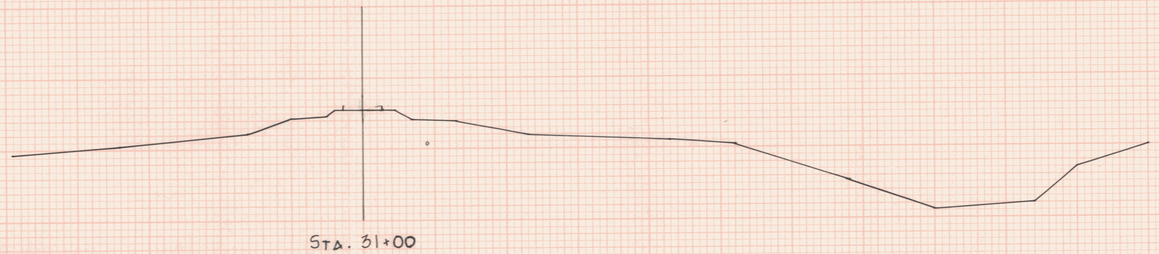

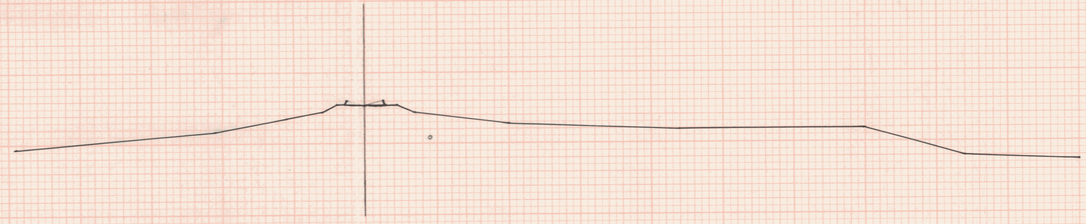

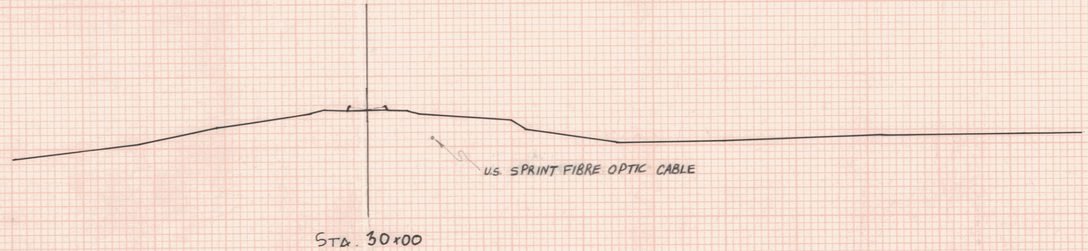

BUILT AS DESIGNED 5/24/94 RG

FROM STA. 30+00 TO STA. 31+50
PROJECT NAME: ESSEX
NO. PB 033-1(2) PLOTTED:
SHEET 336 OF 400 SHEETS

150 100 50 ℄ 50 100 150

PLATE 3-FULL CROSS SECTION-FULL LINE

336 OF 465