STRUCTURE NO. 10
OUTLET CROSS-SECTIONS
STA 9+0 TO 9+10

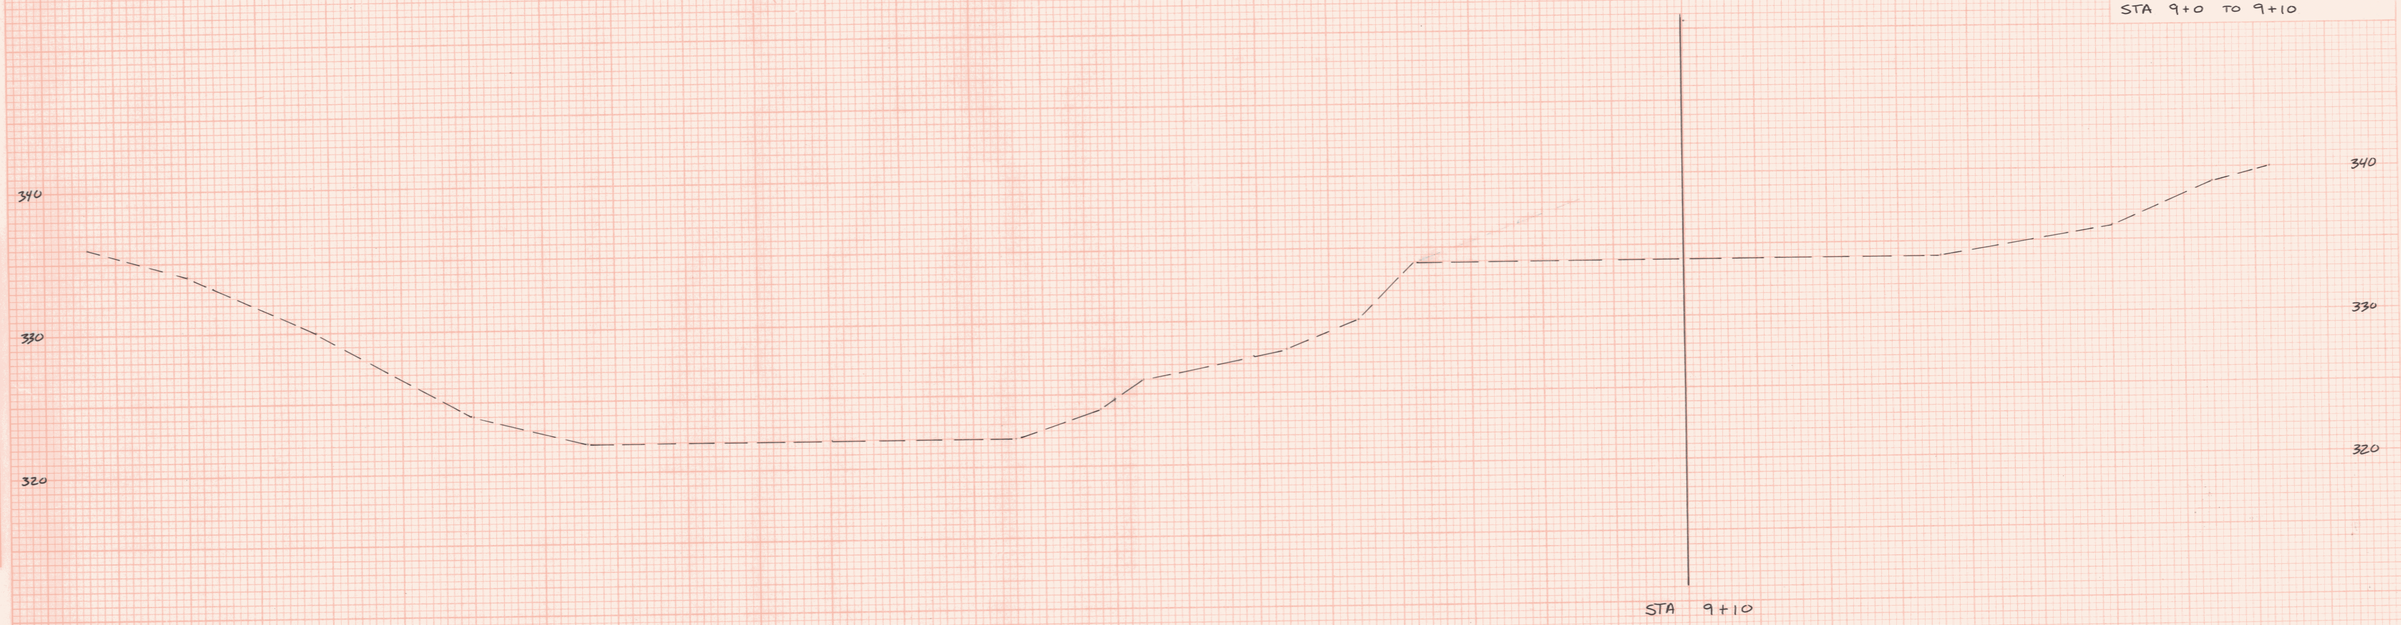

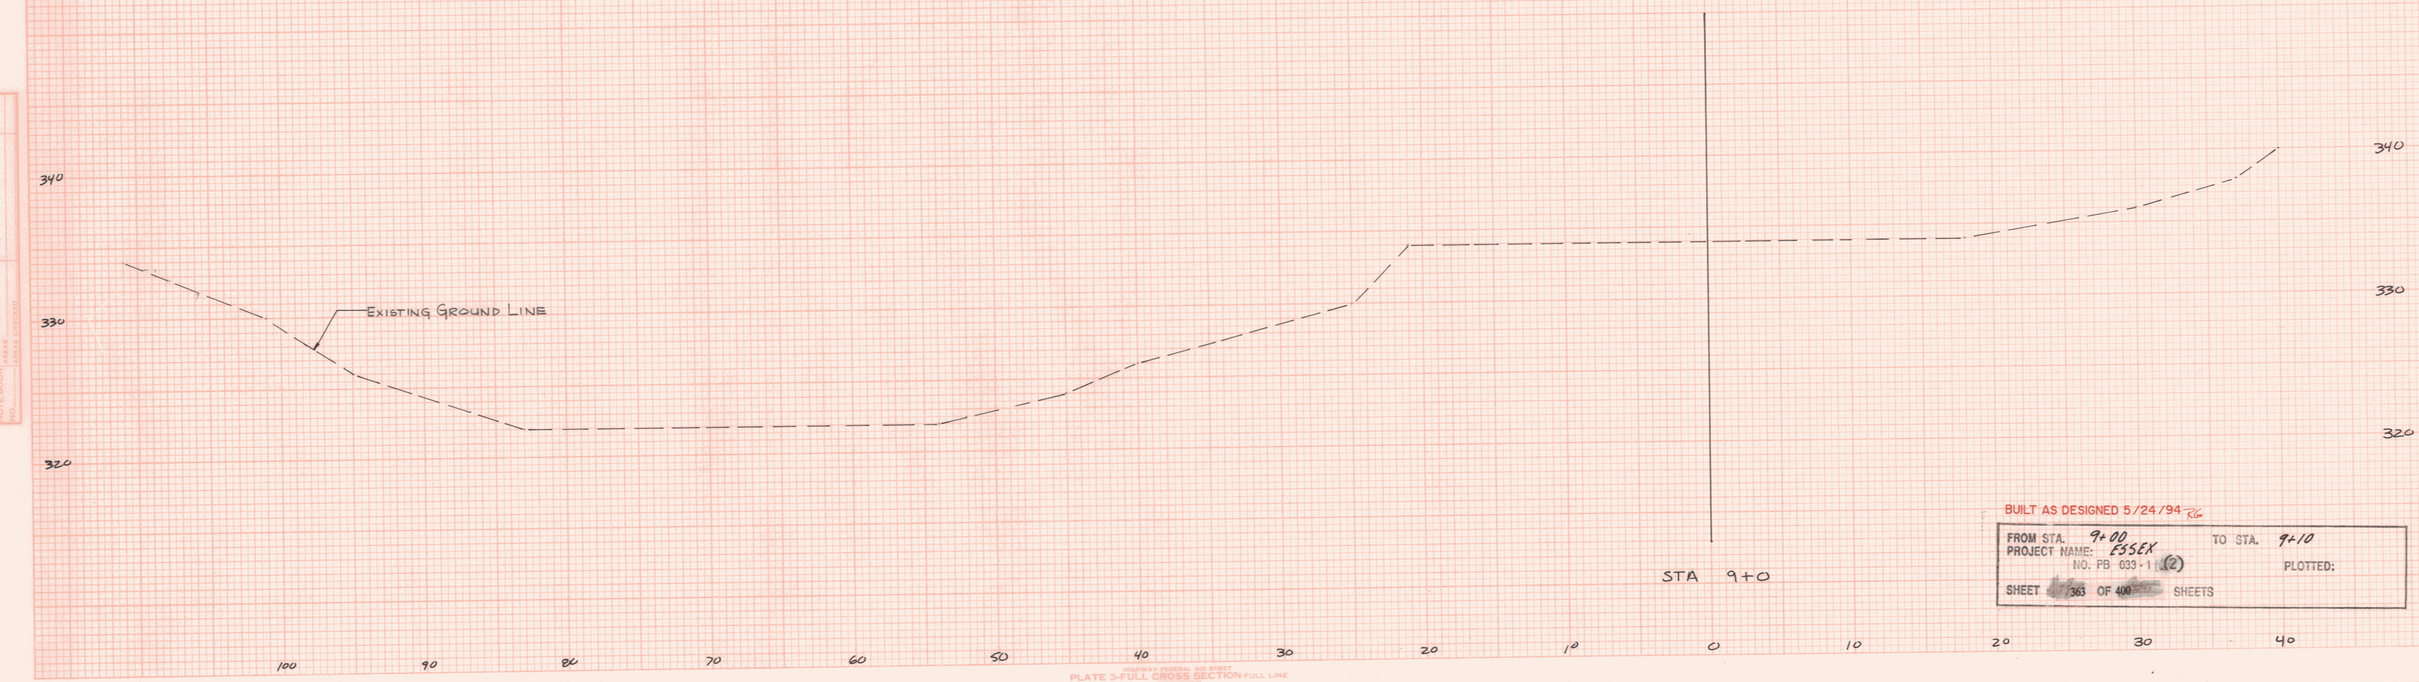

BUILT AS DESIGNED 5/24/94 RG

FROM STA. 9+00	TO STA. 9+10
PROJECT NAME: ESSEX NO. PB 033-1(2)	PLOTTED:
SHEET 363 OF 400 SHEETS	

HIGHWAY FEDERAL AID SHEET
PLATE 3-FULL CROSS SECTION-FULL LINE
W-TELEDYNE
PRINTED IN U.S.A.