STRUCTURE NO. 10
OUTLET CROSS-SECTIONS

STA 9+60 TO 9+70

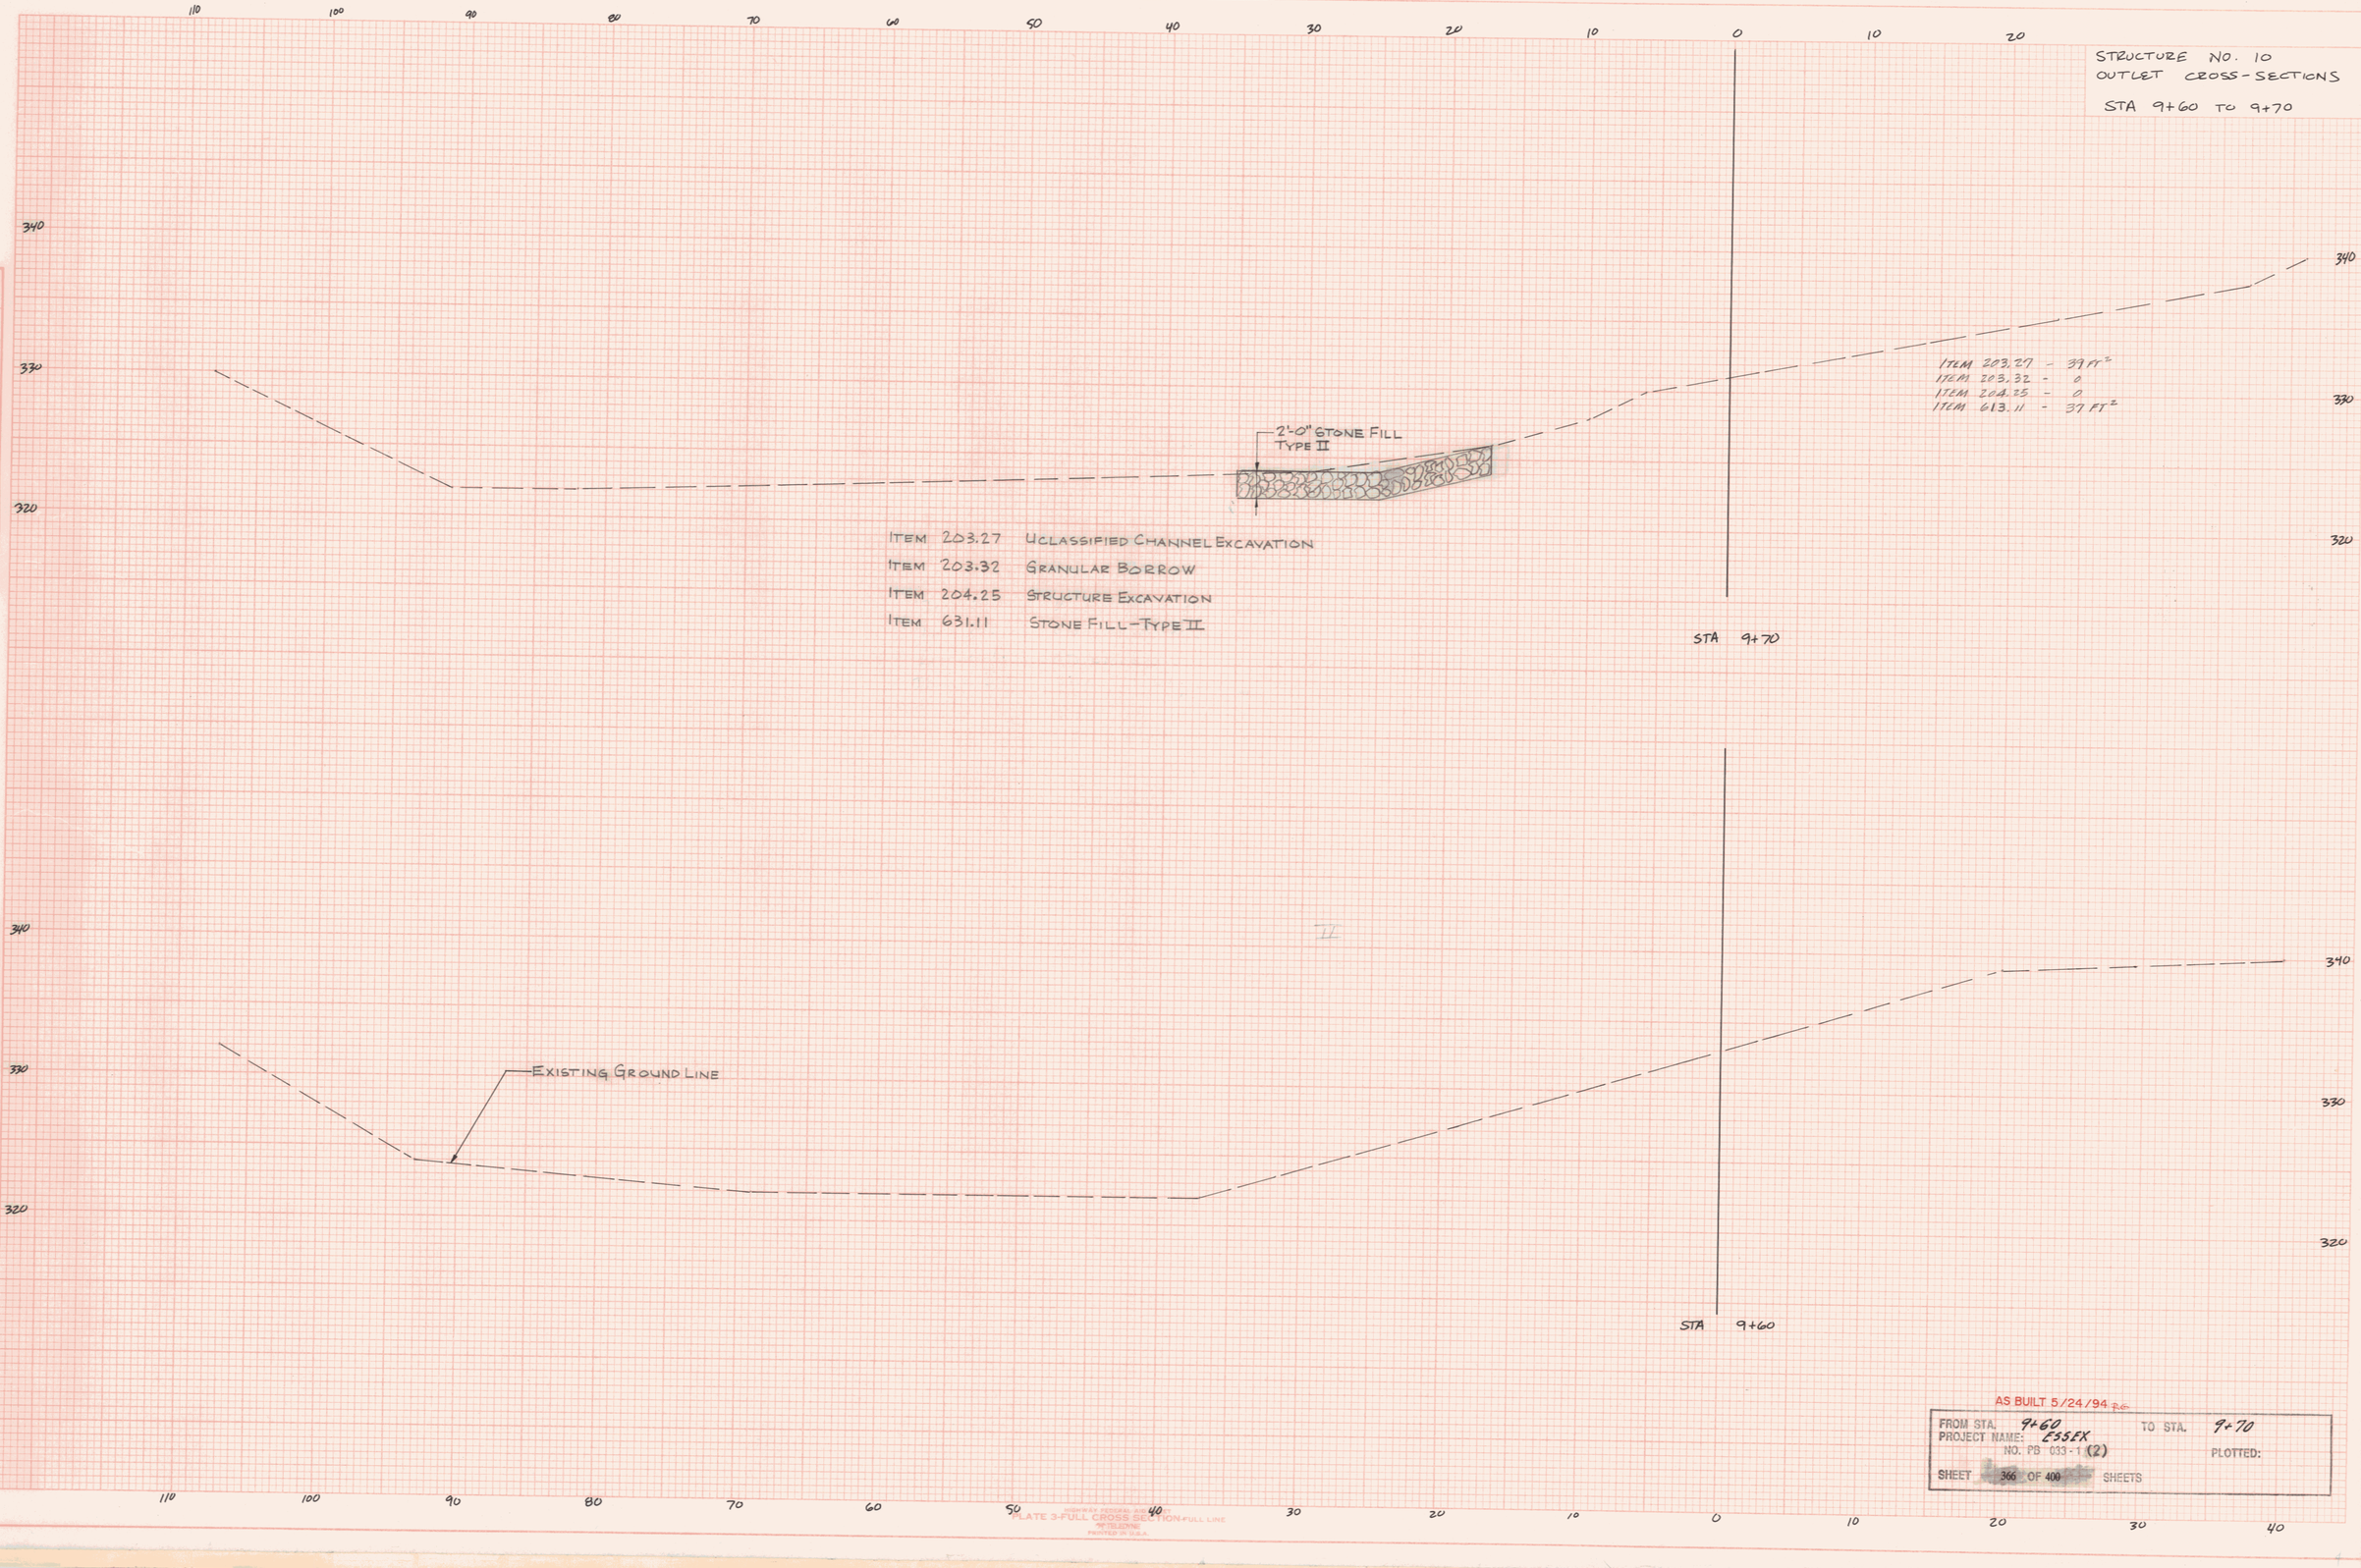

ITEM 203.27 UCLASSIFIED CHANNEL EXCAVATION
ITEM 203.32 GRANULAR BORROW
ITEM 204.25 STRUCTURE EXCAVATION
ITEM 631.11 STONE FILL-TYPE II

AS BUILT 5/24/94 RC

FROM STA. 9+60 TO STA. 9+70
PROJECT NAME: ESSEX
NO. PB 033-1 (2) PLOTTED:
SHEET 366 OF 400 SHEETS

FINAL SURVEY — DATE, BY, SURVEYED, PLOTTED, TEMPLATE, AREAS, AREAS CHECKED, NOTE BOOK, NO.

ORIGINAL SURVEY — DATE, BY, SURVEYED, PLOTTED, TEMPLATE, AREAS, AREAS CHECKED, NOTE BOOK, NO.

HIGHWAY DESIGN AID
PLATE 3-FULL CROSS SECTION-FULL LINE
MITELDYNE
PRINTED IN U.S.A.