STRUCTURE NO. 10
PIPE CROSS-SECTIONS
STA 11+0 TO 11+50

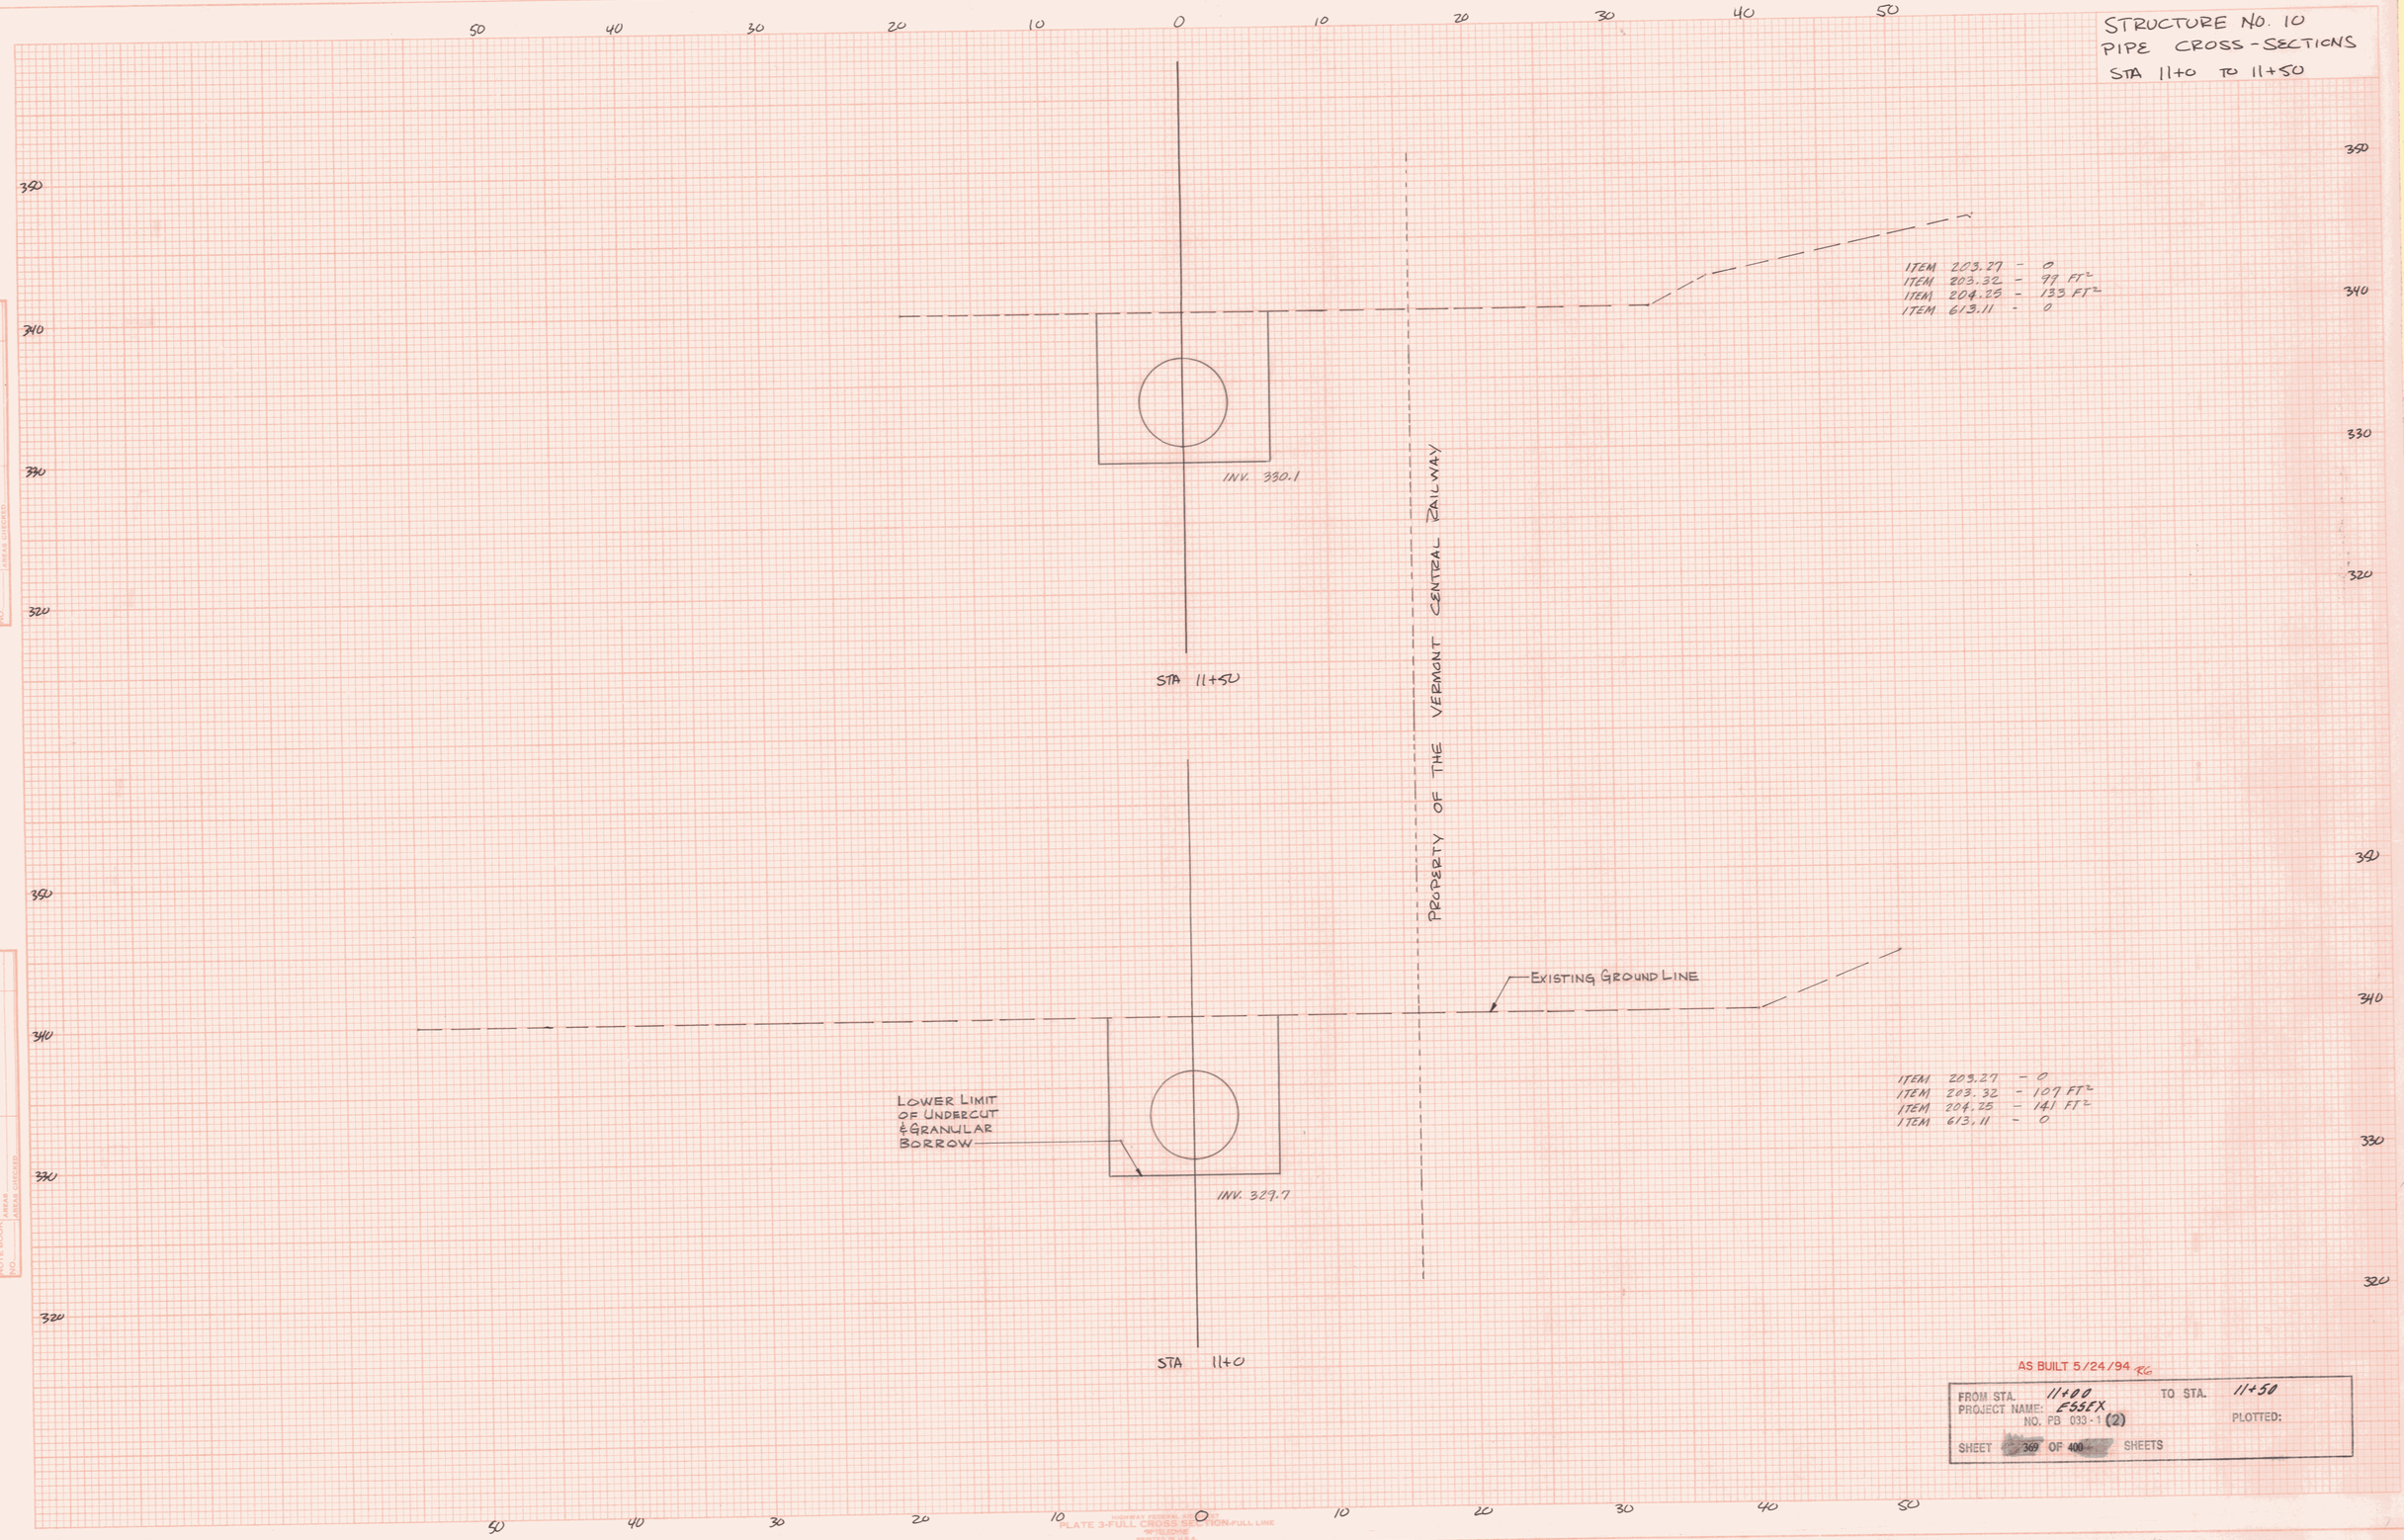

FINAL SURVEY — DRAWN, PLOTTED, TEMPLATE, AREAS, CROSS CHECKED, NOTE BOOK, NO., BY, DATE

ORIGINAL SURVEY — DRAWN, PLOTTED, TEMPLATE, AREAS, CROSS CHECKED, NOTE BOOK, NO., BY, DATE

AS BUILT 5/24/94 RG

FROM STA. 11+00 TO STA. 11+50
PROJECT NAME: ESSEX
NO. PB 033-1 (2) PLOTTED:
SHEET 369 OF 400 SHEETS

PLATE 3-FULL CROSS SECTION-FULL LINE
PRINTED IN U.S.A.