STRUCTURE NO. 10
PIPE CROSS-SECTIONS
STA 12+00 TO 12+50

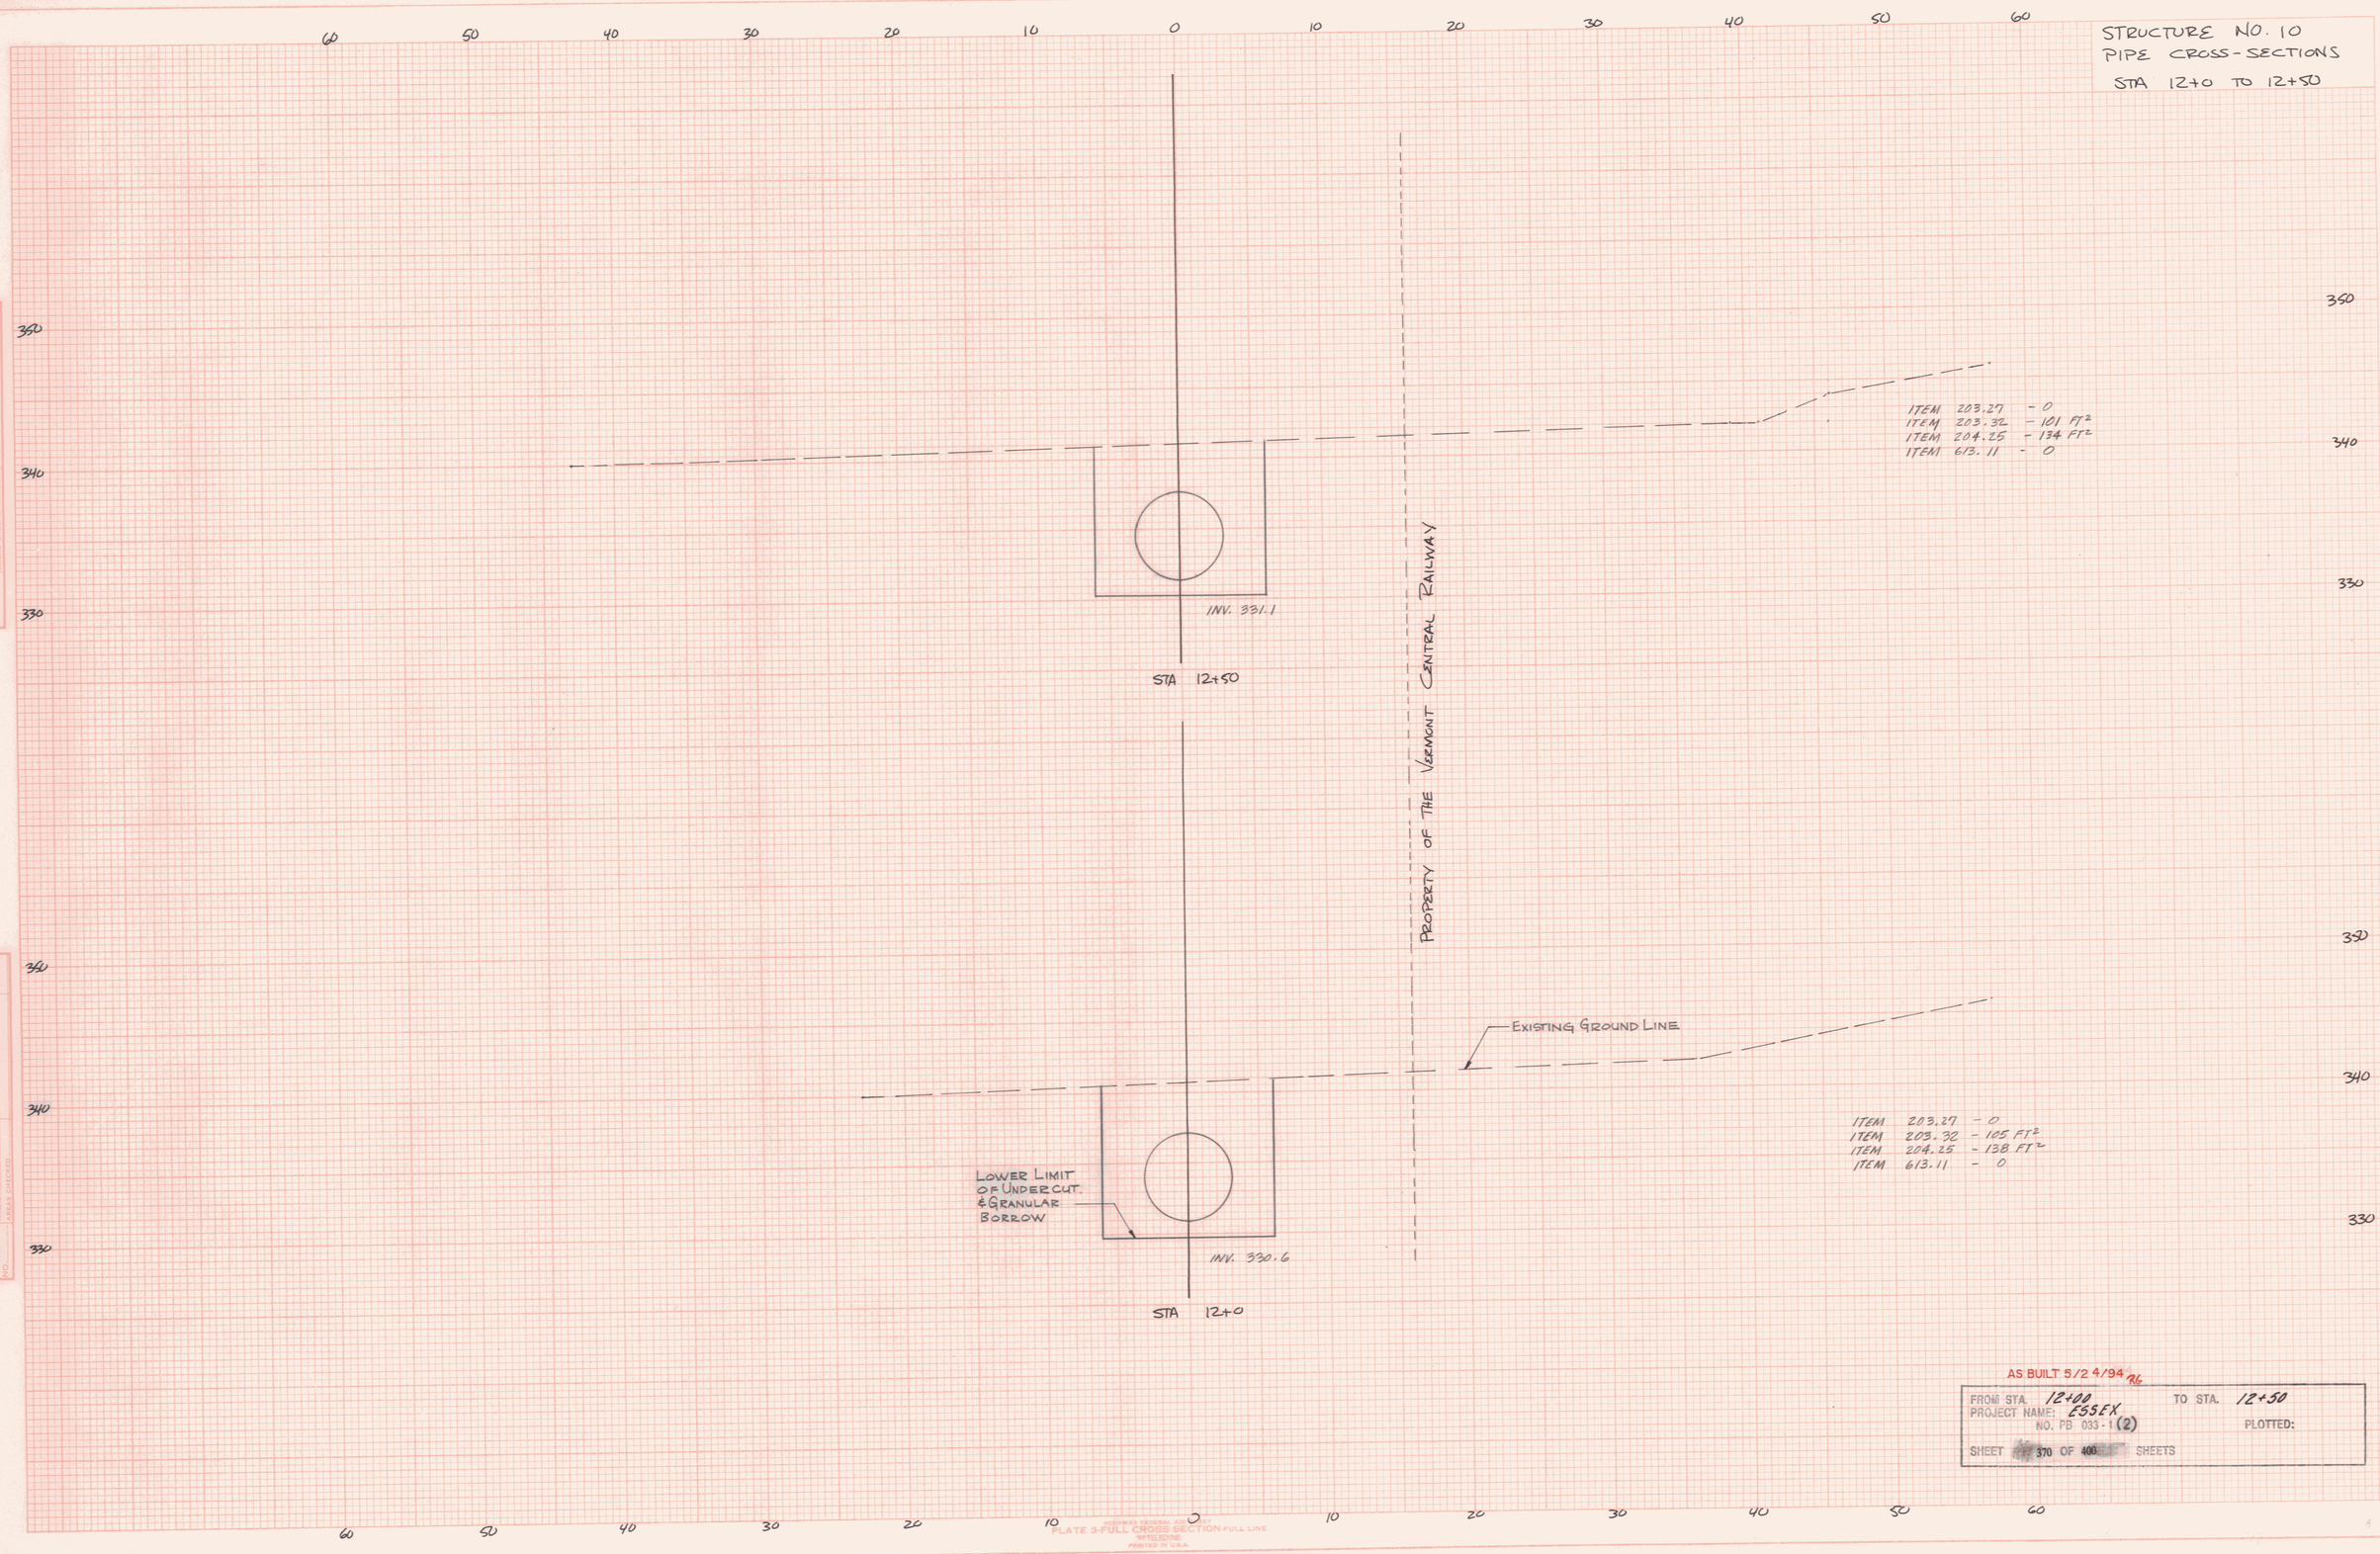

FINAL SURVEY — SURVEYED, PLOTTED, TEMPLATE, NOTE BOOK, AREAS, CHECKED, DATE, BY, NO.

ORIGINAL SURVEY — SURVEYED, PLOTTED, TEMPLATE, NOTE BOOK, AREAS, CHECKED, DATE, BY, NO.

AS BUILT 5/24/94 RL

FROM STA. 12+00 TO STA. 12+50
PROJECT NAME: ESSEX
NO. PB 033-1(2) PLOTTED:
SHEET 370 OF 400 SHEETS

All Of 465