STRUCTURE NO. 10
INLET CROSS-SECTIONS
STA 14+95 TO 15+05

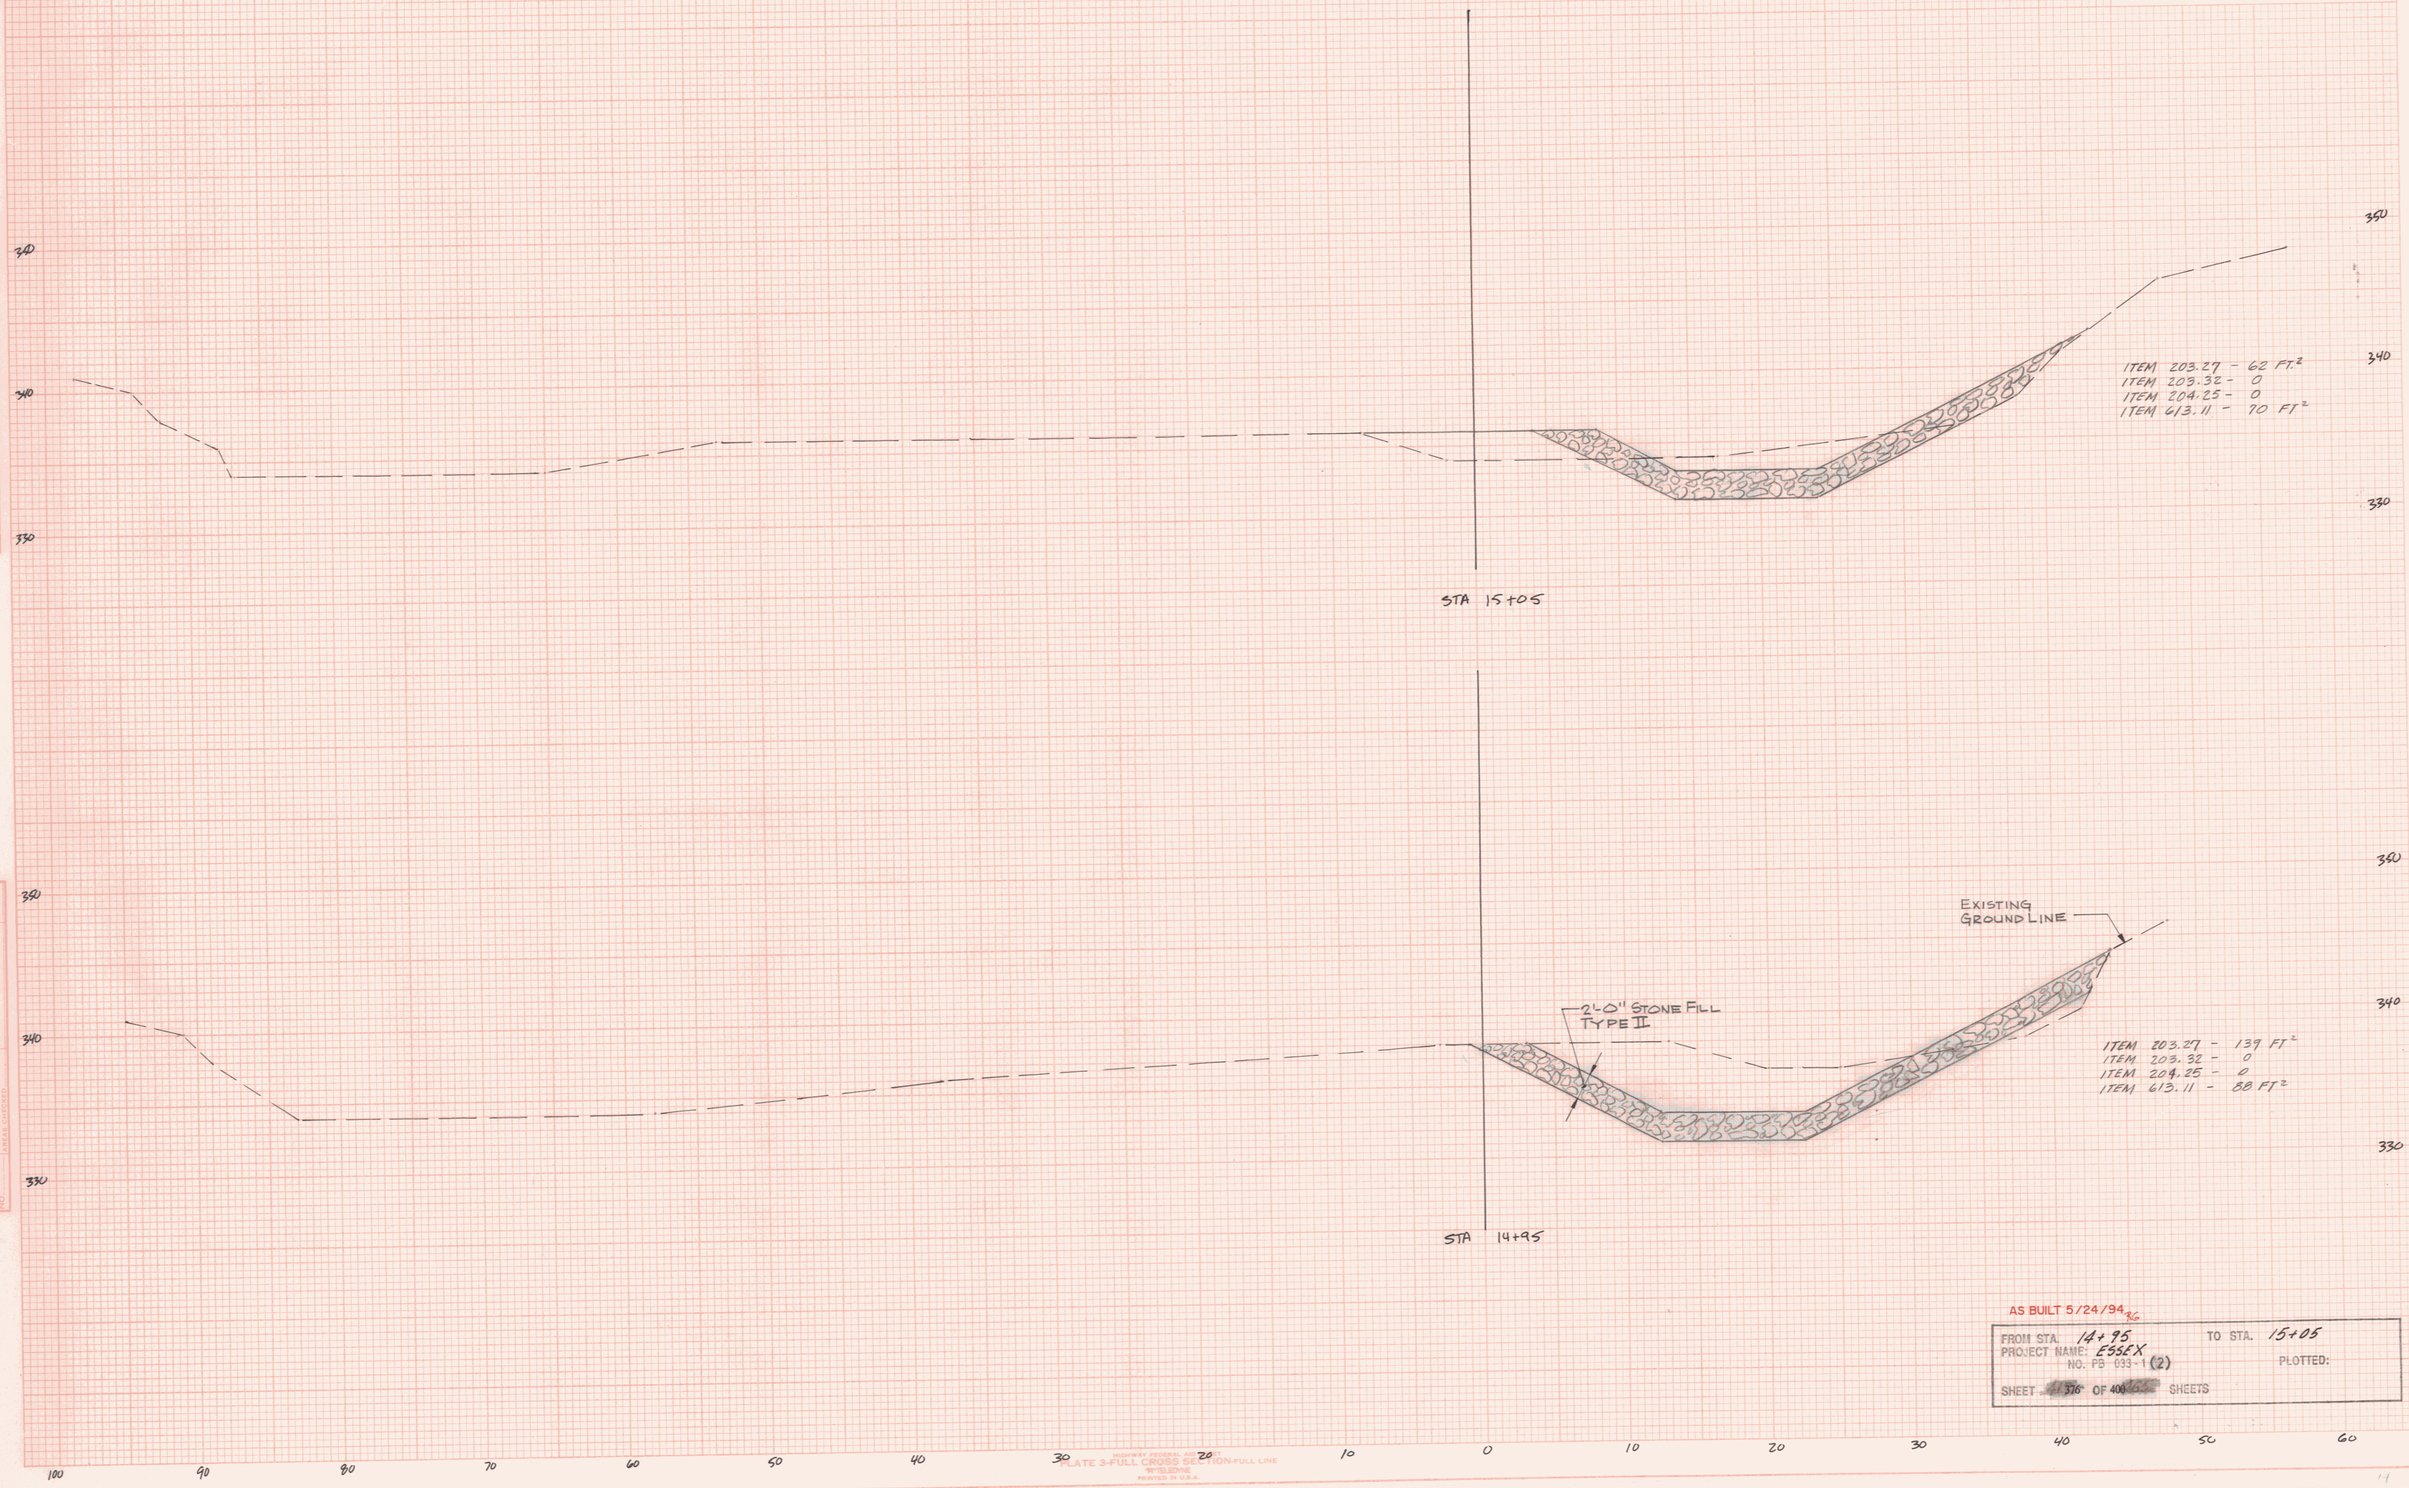

FINAL SURVEY
DATE
BY
SURVEYED
PLOTTED
TEMPLATE
NOTE BOOK
AREAS
NO.
AREAS CHECKED

ORIGINAL SURVEY
PLOTTED
TEMPLATE
NOTE BOOK
AREAS
NO.
AREAS CHECKED

AS BUILT 5/24/94 JG

FROM STA. 14+95 TO STA. 15+05
PROJECT NAME: ESSEX
NO. PB-033-1(2) PLOTTED:
SHEET 376 OF 400 SHEETS

PLATE 3-FULL CROSS SECTION-FULL LINE
PRINTED IN U.S.A.