"PME" = PIECE MARK END
"OPME" = OPPOSITE PIECE MARK END

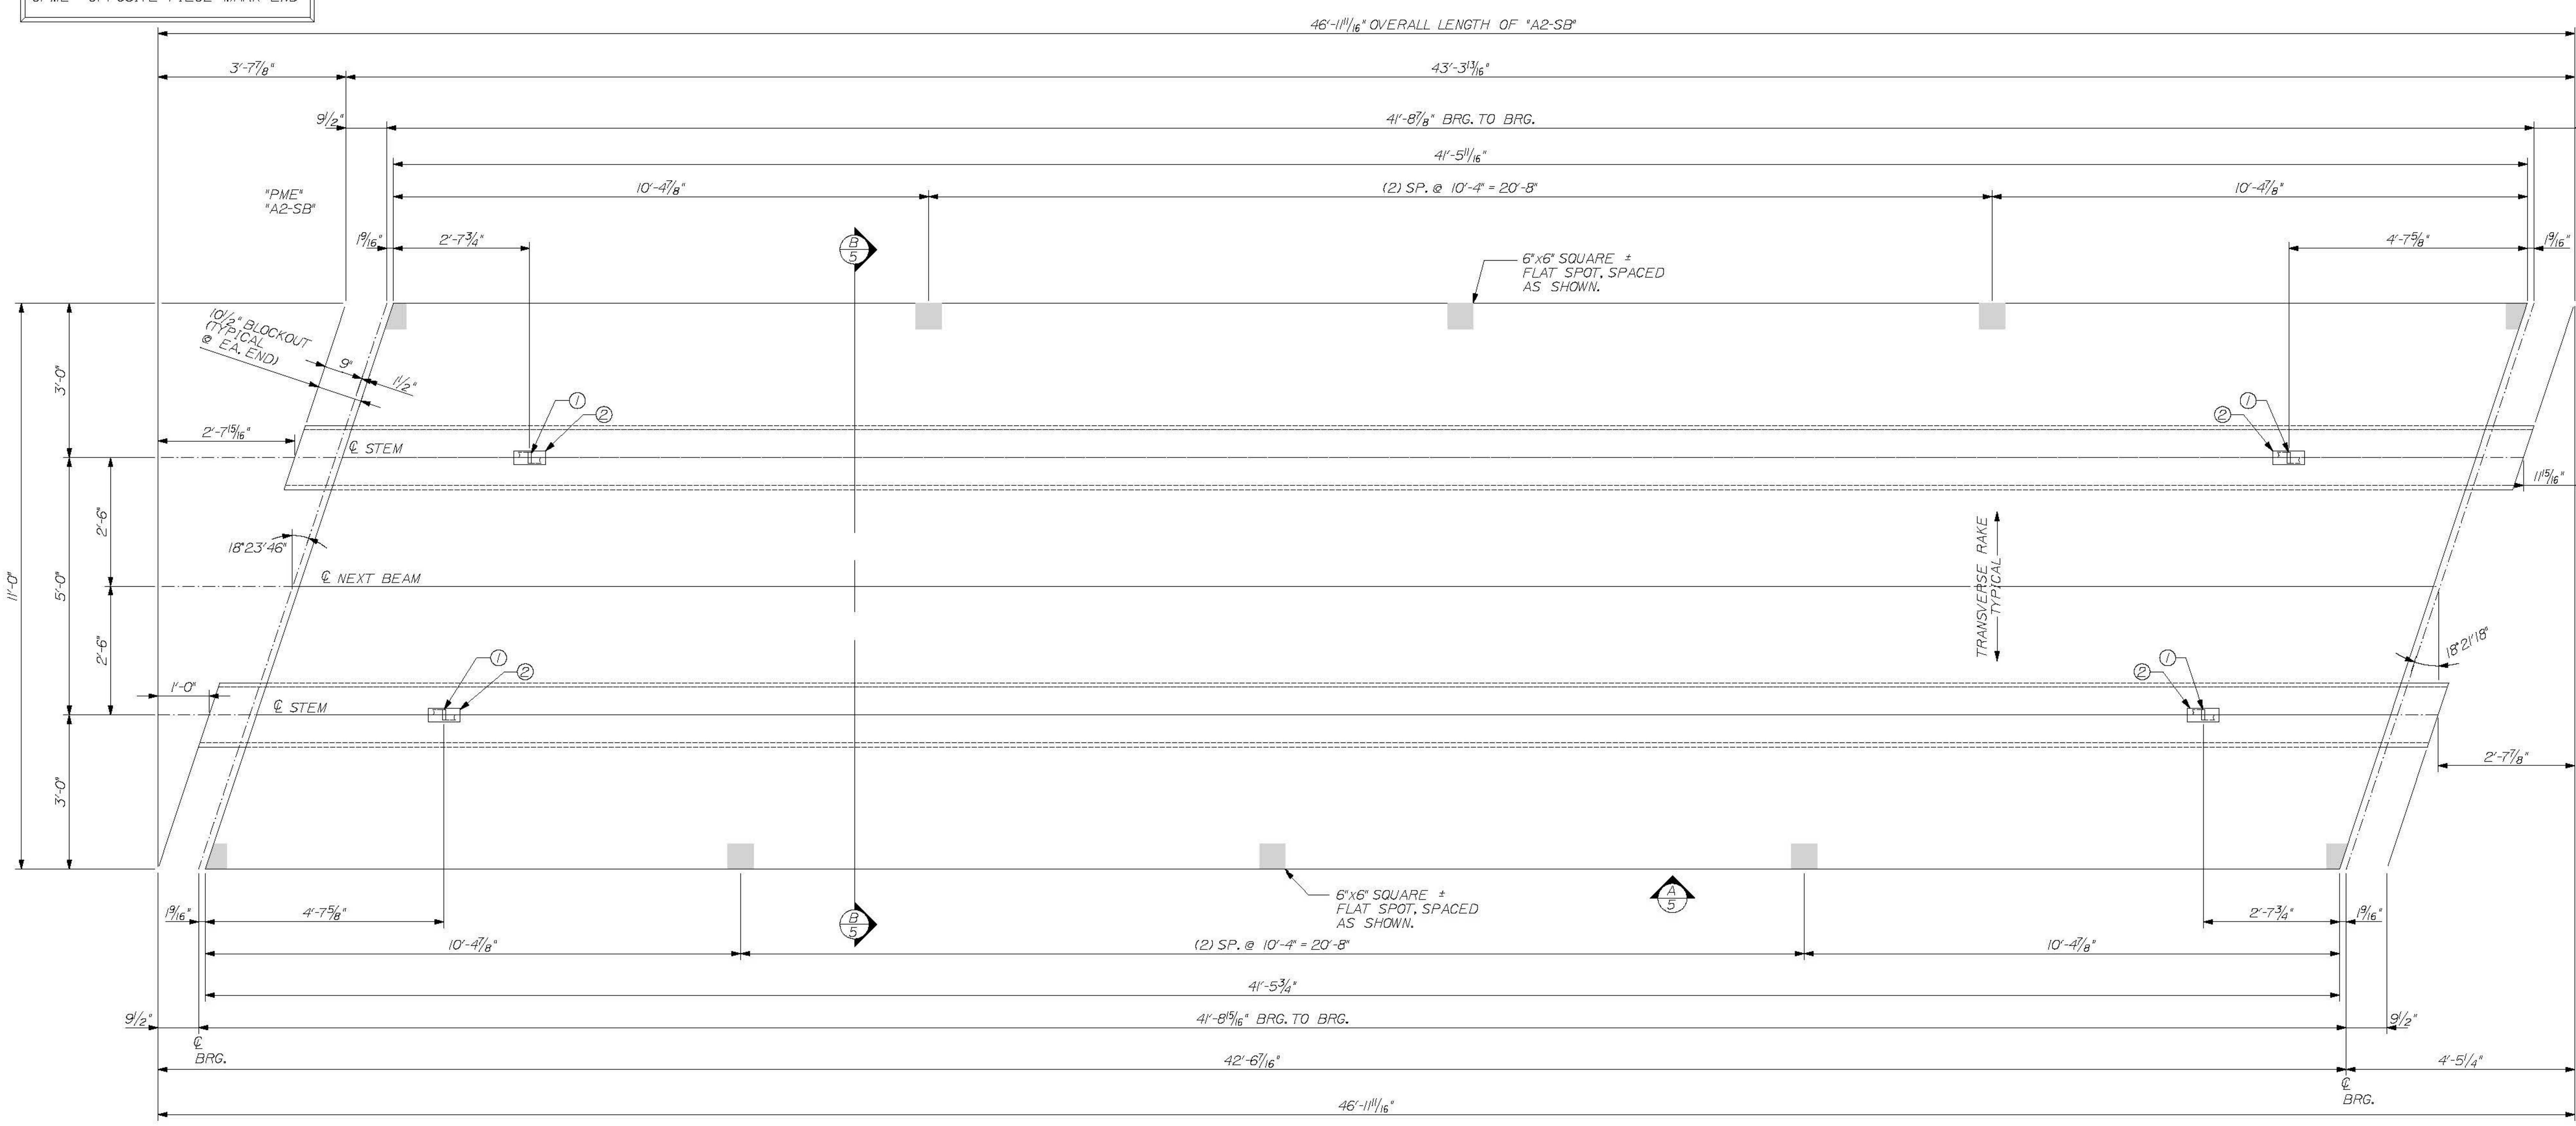

PLAN VIEW ~ BEAM "A2-SB"
SCALE: ½" = 1'-0"

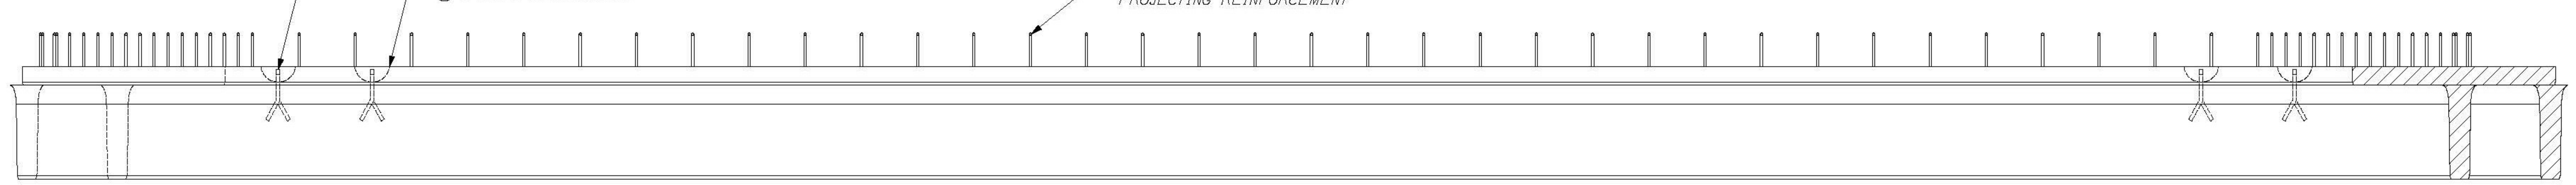

VIEW A ~ TYPICAL BOTH SIDES
SCALE: ½" = 1'-0"

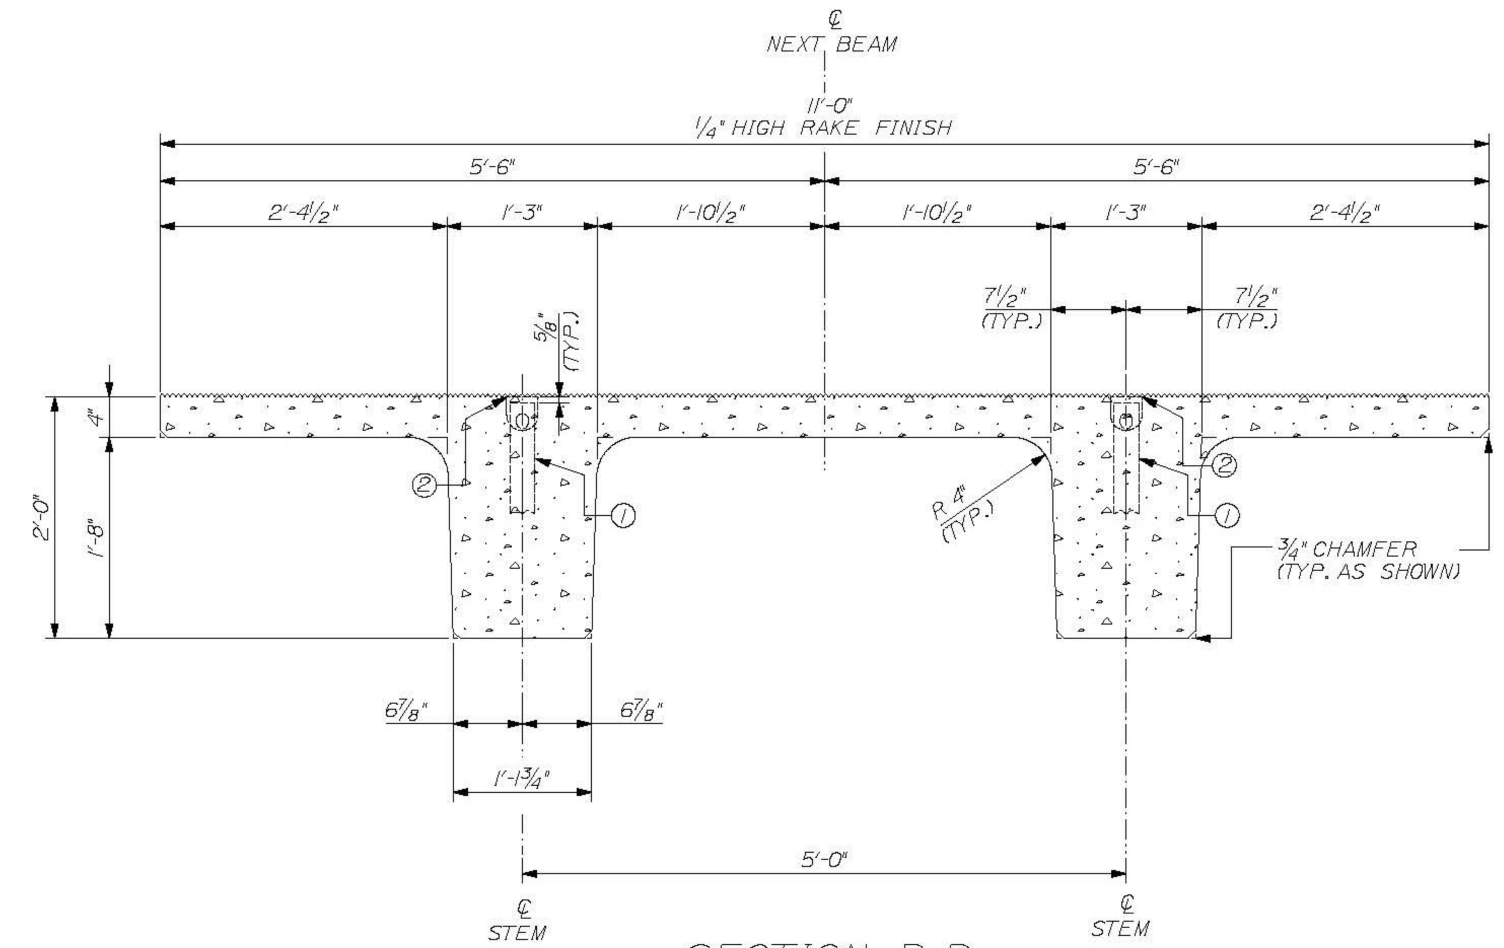

SECTION B-B
SCALE: ¾" = 1'-0"

DESIGN NOTES:

CONCRETE f'_c @ TRANSFER = 6200 PSI
f'_c @ FINAL = 8000 PSI
CAMBER @ DESTRESS = ¹³⁄₁₆ in.
CAMBER @ ERECTION = 1⁷⁄₁₆ in.
FINISH - TOPS OF BEAMS TO RECIEVE RAKE FINISH W/ ¼" AMPLITUDE
PATCH RECESS VOIDS FLUSH WITH SURFACE WITH CEMENT MORTAR
ALL TOLERANCES TO PCI STANDARDS

(1) "A2-SB" DECK BEAMS REQUIRED

SEE SHEET #6 FOR REINFORCING

DUE TO INHERENT VARIABLES, CAMBERS ARE PROVIDED ONLY AS A MEANS OF QUANTIFYING THE CONSISTENCY OF PRODUCTION AND QUALITY CONTROL AND SHOULD NEVER BE CONSIDERED ANY BETTER THAN ESTIMATES.

X No Exception Taken
Make Correction as Noted
Submit Specified Item
Revise and Resubmit as Noted
Rejected

T-Y-LININTERNATIONAL

Checking is for general compliance with the design concept of the project and general compliance with the information given in the contract documents only. Any action shown is not as approval and is subject to the requirements of the plans and specifications. Any action shown on a specific item shall not indicate the checking of an assembly of which the item is a component. Contractor is solely responsible for dimensions which shall be confirmed and correlated at the job site, fabrication processes, techniques of construction, safety precautions, and coordination of its work with that of all other trades and the satisfactory performance of his work.
Reviewed by: Date: June 11, 2012

PRODUCT WEIGHT

PRODUCT	WEIGHT
"A2-SB"	24.4 TONS

BILL OF MATERIALS

REMARKS	#	QTY	TOTAL	DESCRIPTION
SEE SHEET #2	1	4	4	RL-23 SPREAD ANCHOR, 8 TON, (11" LONG), PART# MB79119
	2	4	4	RL-45 REUSABLE RECESS MEMBER, 8TON, PART# MB79121
	3	1	1	12.0 C.Y. CONCRETE MIX

THE PROFESSIONAL ENGINEER'S STAMP CERTIFIES ONLY THAT THESE DRAWINGS WERE PREPARED UNDER THE DIRECT SUPERVISION OF A REGISTERED PROFESSIONAL ENGINEER AND COMPLY WITH THE DESIGN AND DETAILS SHOWN ON THE CONTRACT DRAWING UNLESS REQUESTED OTHERWISE.

CONTRACTOR: BECK & BELLUCCI, INC.
PROJECT: BRATTLEBORO, VERMONT IM 019-1(50)

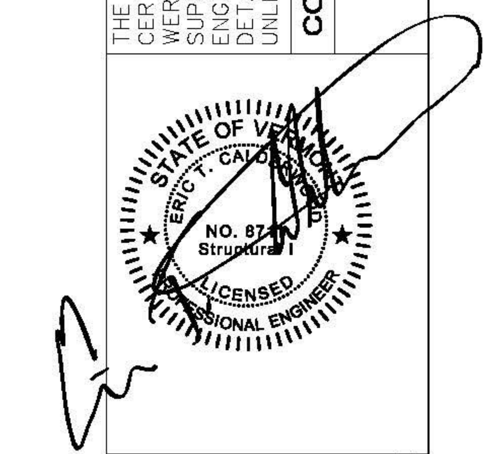

W.E. DAILEY INC.
AIRPORT ROAD, SHAFTSBURY, VT. 05262
PRECAST CONCRETE PRODUCTS
TEL: (802) 442-4418 FAX: (802) 442-4719
DATE: MARCH, 2011 REVISION 0: INITIAL SUBMISSION
DETAILER: ETC

I-91 BRATTLEBORO, VERMONT OVER MAPLE ST.

BEAM TYPE "A2-SB" DIMENSIONAL DETAILS

SHEET NUMBER
5

Filename: ...\005_Beam_A2-SB_dimensional Workgroup: Structures Division Username: Eric Calderwood Date: 6/11/2012