"PME" = PIECE MARK END
"OPME" = OPPOSITE PIECE MARK END

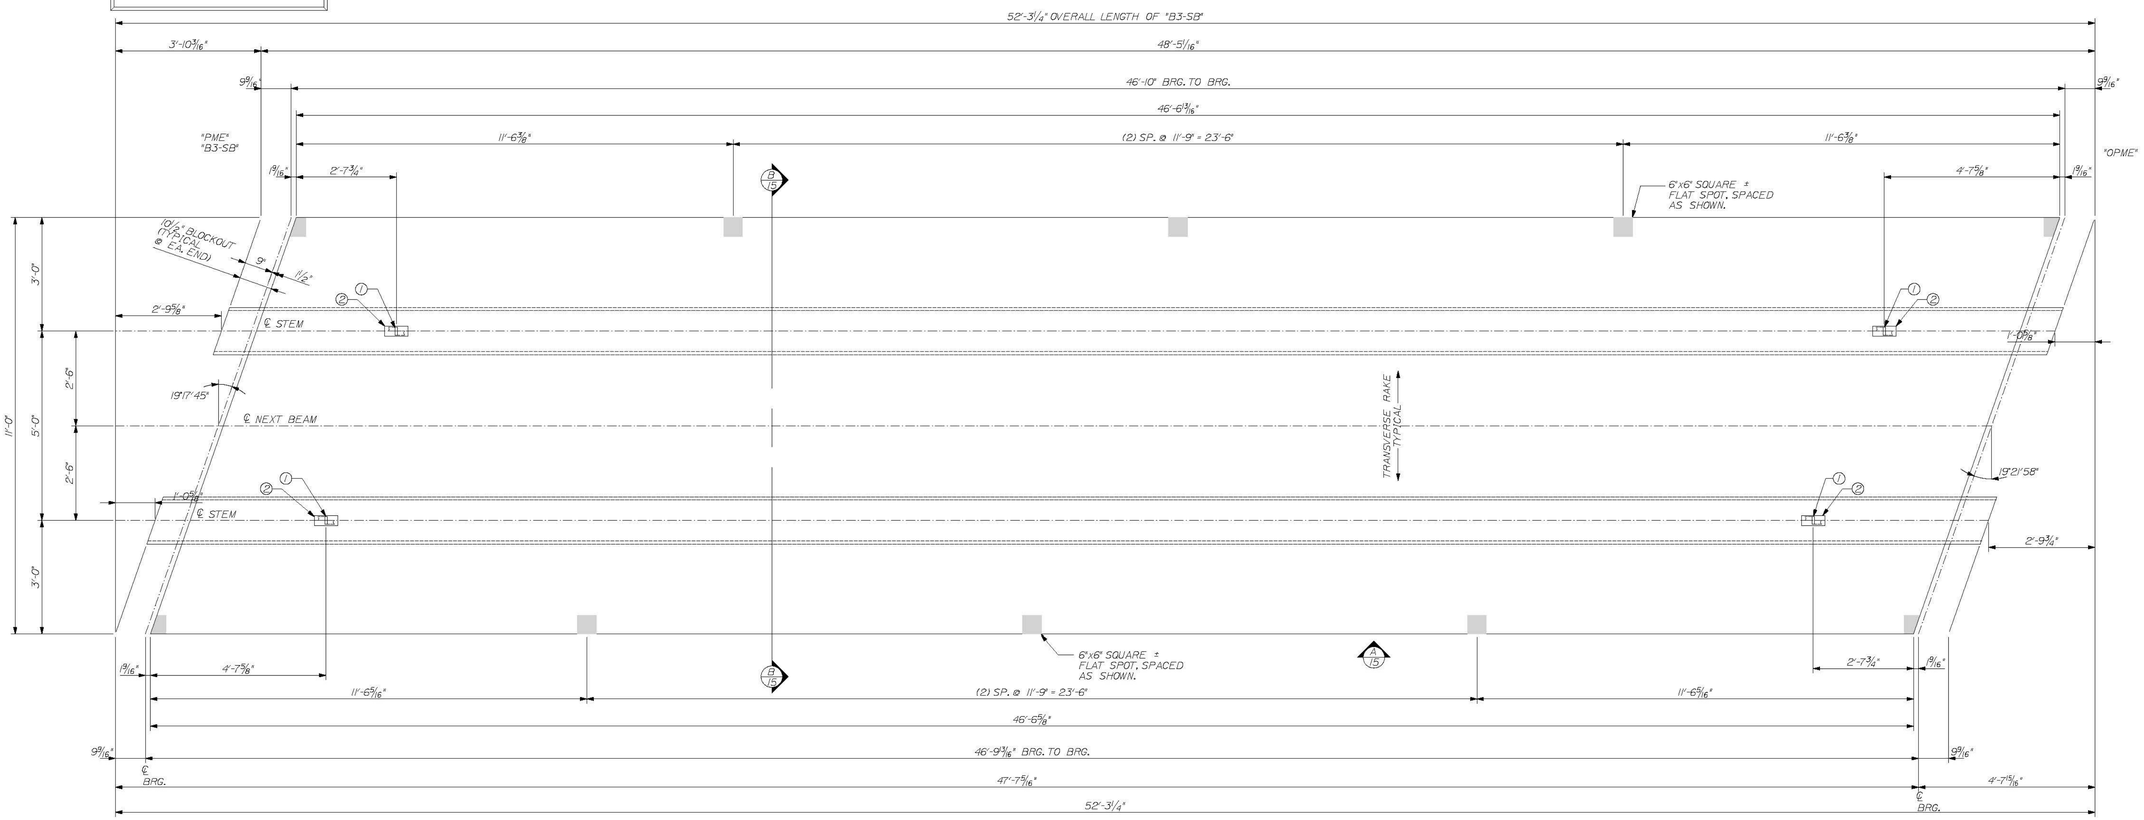

PLAN VIEW ~ BEAM "B3-SB"
SCALE: 1/2" = 1'-0"

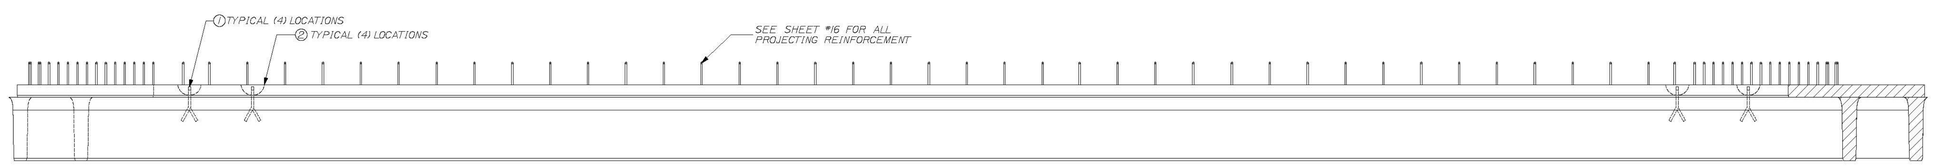

VIEW A ~ TYPICAL BOTH SIDES
SCALE: 1/2" = 1'-0"

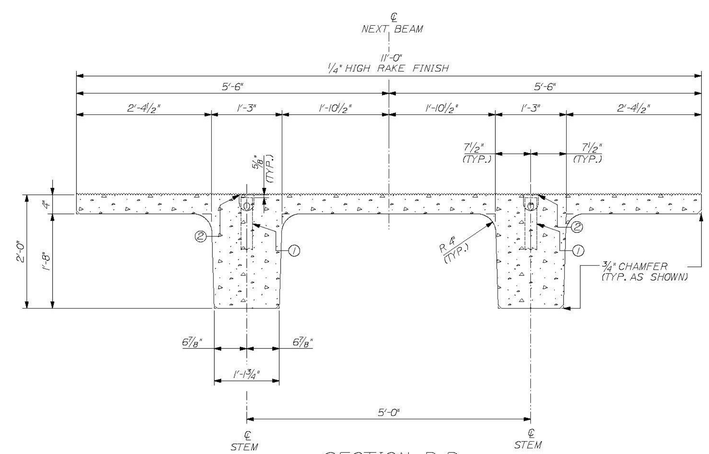

SECTION B-B
SCALE: 3/4" = 1'-0"

No Exception Taken
Make Correction as Noted
Submit Specified Item
Revise and Resubmit as Noted
Rejected

T-Y-LIN INTERNATIONAL

Checking is for general compliance with the design concept of the project and general compliance with the information given in the contract documents only. Any dation shown is not an approval and is subject to the requirements of the plans and specifications. Any action shown on a specific item shall not facilitate the checking of an assembly of which the item is a component. Contractor is solely responsible for dimensions which shall be confirmed and correlated at the job site, fabrication processes, techniques of construction, safety precautions, and coordination of its work with that of all other trades and the satisfactory performance of its work.

Reviewed By: _____ Date: June 11, 2012

PRODUCT WEIGHT	
PRODUCT	WEIGHT
"B3-SB"	27.5 TONS

BILL OF MATERIALS

REMARKS	#	QTY	TOTAL	DESCRIPTION
SEE SHEET #2	1	4	4	RL-23 SPREAD ANCHOR, 8 TON, (11" LONG), PART# MB79119
	2	4	4	RL-45 REUSABLE RECESS MEMBER, 8TON, PART# MB79121
	4	1	1	13.5 C.Y. CONCRETE MIX

DESIGN NOTES:

CONCRETE f'_c @ TRANSFER = 6200 PSI
f'_c @ FINAL = 8000 PSI
CAMBER @ DESTRESS = 1 1/4 in.
CAMBER @ ERECTION = 2 3/16 in.
FINISH - TOPS OF BEAMS TO RECIEVE RAKE FINISH W/ 1/4" AMPLITUDE
PATCH RECESS VOIDS FLUSH WITH SURFACE WITH CEMENT MORTAR
ALL TOLERANCES TO PCI STANDARDS

(1) "B3-SB" DECK BEAMS REQUIRED

SEE SHEET #16 FOR REINFORCING

DUE TO INHERENT VARIABLES, CAMBERS ARE PROVIDED ONLY AS A MEANS OF QUANTIFYING THE CONSISTENCY OF PRODUCTION AND QUALITY CONTROL AND SHOULD NEVER BE CONSIDERED ANY BETTER THAN ESTIMATES.

THE PROFESSIONAL ENGINEER'S STAMP CERTIFIES ONLY THAT THESE DRAWINGS WERE PREPARED UNDER THE DIRECT SUPERVISION OF A REGISTERED PROFESSIONAL ENGINEER AND COMPLIES WITH THE STANDARD DETAILS SHOWN ON THE CONTRACT DRAWING UNLESS REQUESTED OTHERWISE.

STATE OF VERMONT
ERIC A. CALDERWOOD
NO. 8741
Structural
LICENSED
PROFESSIONAL ENGINEER

CONTRACTOR: BECK & BELLUCCI, INC.

PROJECT: BRATTLEBORO, VERMONT
IM 019-1(50)

W.E. DALEY INC.
AIRPORT ROAD, SHAFTSBURY, VT. 05262

PRECAST CONCRETE PRODUCTS
TEL: (802) 442-4416
FAX: (802) 442-4719

DATE: 10/05/2011 REVISIONS: 0 INITIAL SUBMISSION
DETAILER: RTC

I-91 BRATTLEBORO, VERMONT
OVER MAPLE ST.

BEAM TYPE "B3-SB"
DIMENSIONAL DETAILS

SHEET NUMBER
15

Filename: ...\015_Beam_B3-SB_dimensions.dgn Workgroup: Structures Division Username: Eric Calderwood Date:6/11/2012