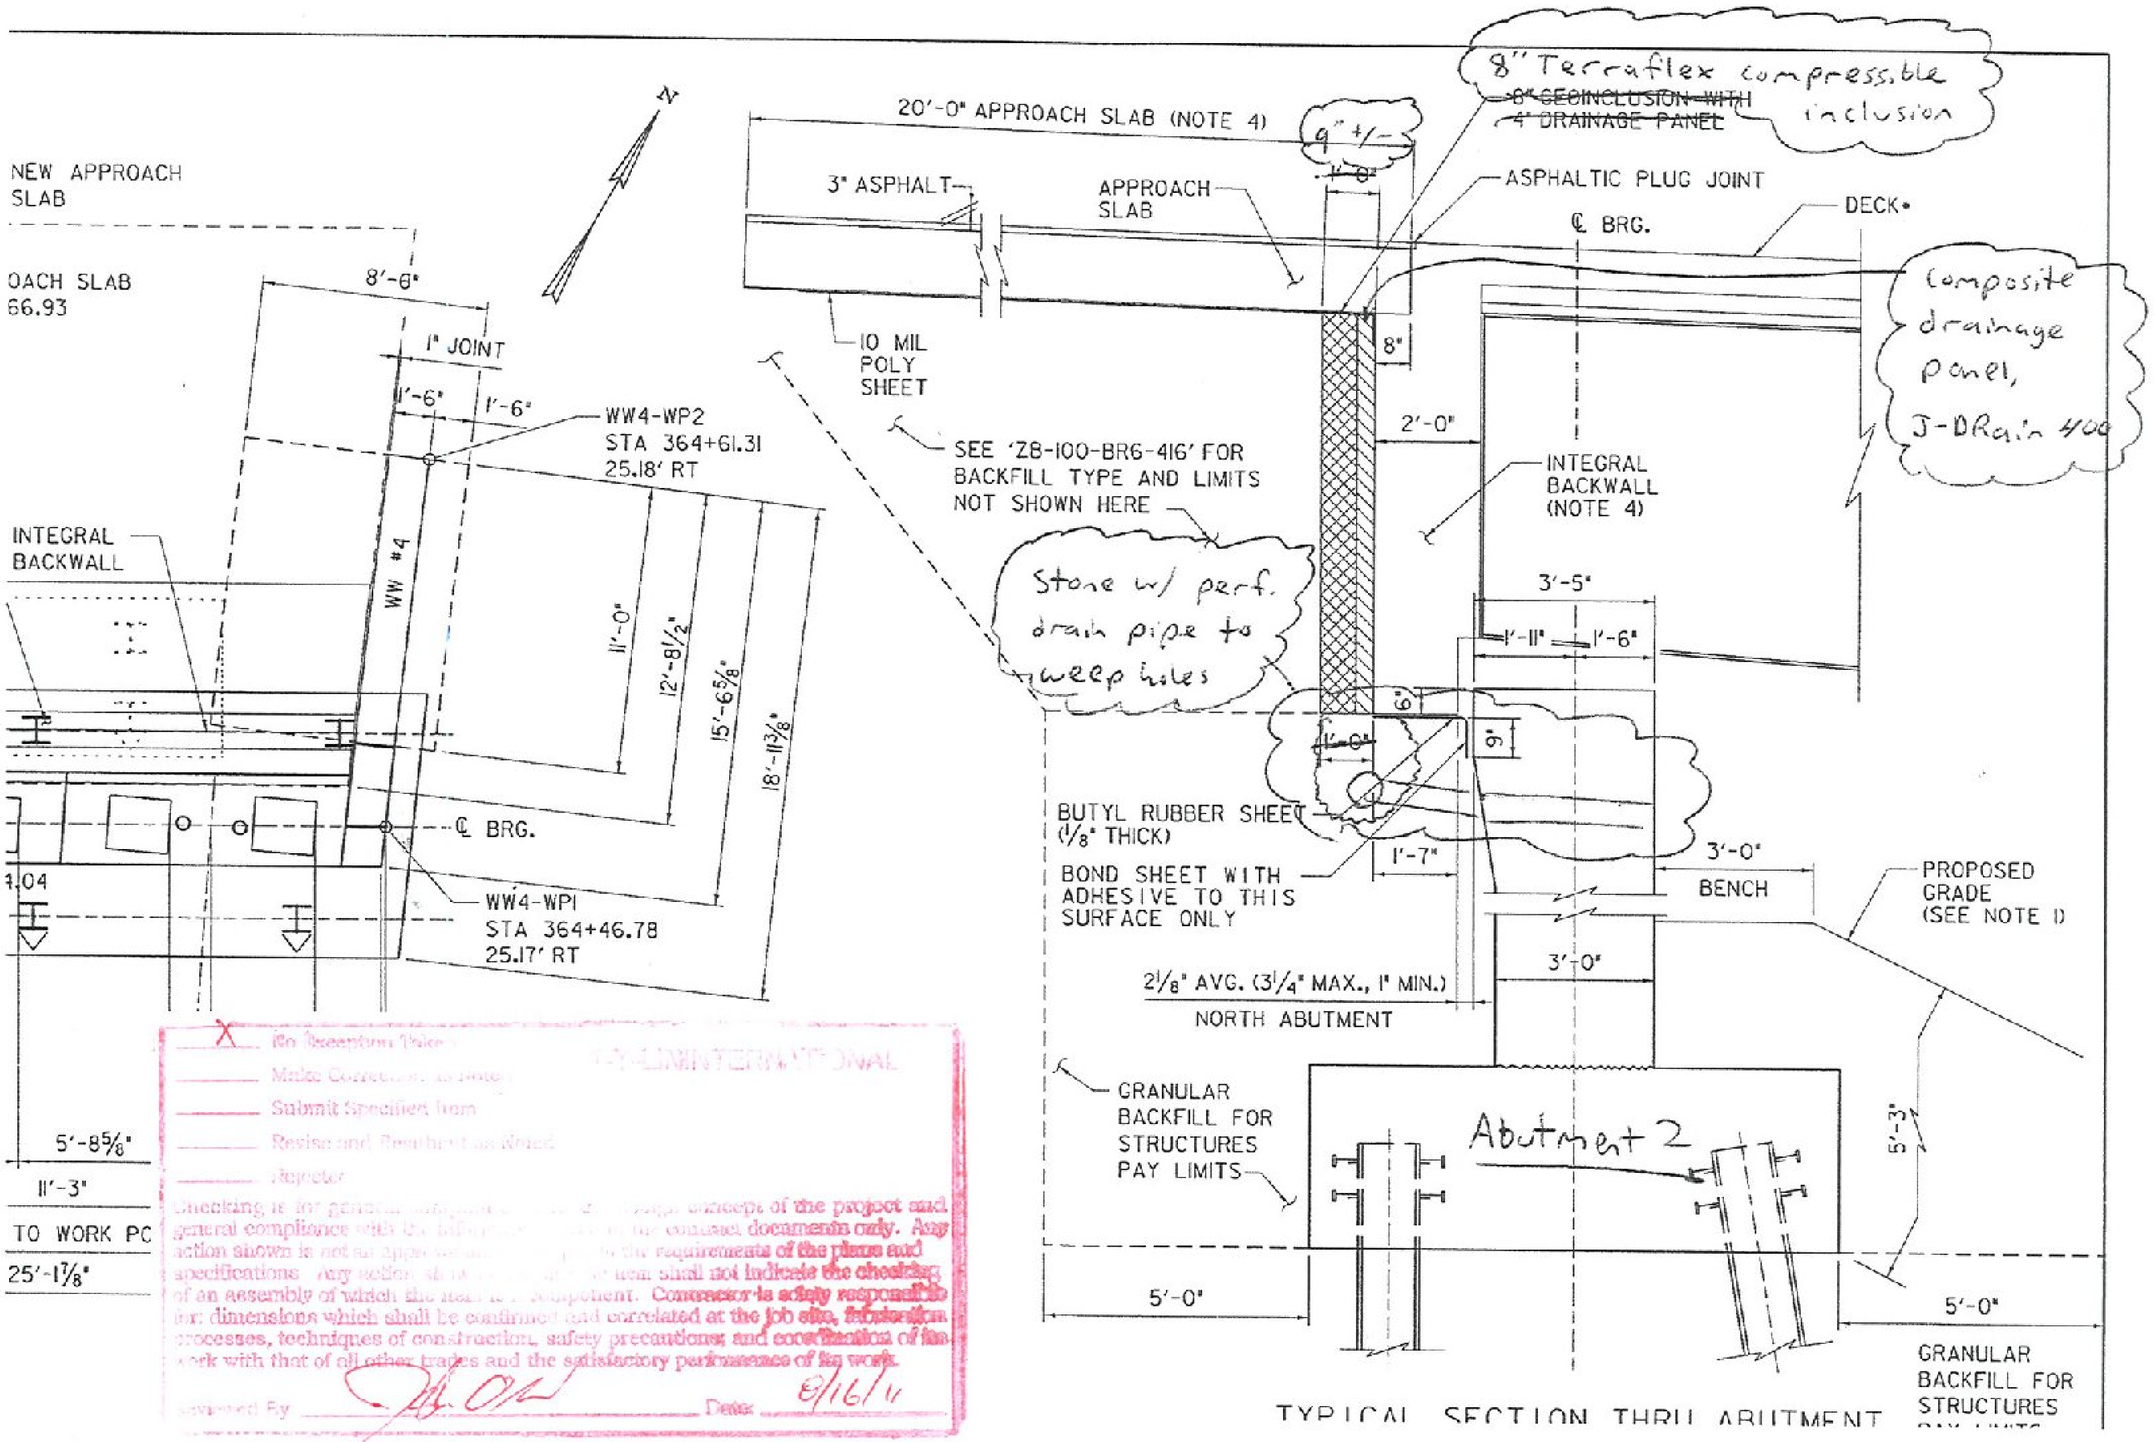

X No Exception Taken
Make Corrections as Noted
Submit Specified Item
Revise and Resubmit as Noted
Rejected
Checking is for general compliance with the design concept of the project and general compliance with the information given on the contract documents only. Any action shown is not an approval of a deviation from the requirements of the plans and specifications. Any action shown on an item shall not indicate the checking of an assembly of which the item is a component. Contractor is solely responsible for dimensions which shall be confirmed and correlated at the job site, fabrication processes, techniques of construction, safety precautions and coordination of his work with that of all other trades and the satisfactory performance of his work.
Reviewed By _____ Date 8/16/11