T·Y·LIN INTERNATIONAL

SUBMITTAL REVIEW

Review is for general conformance with the contract plans. Neither the presence nor the absence of markings or notations on this submittal shall be construed as relieving the contractor from compliance with the contract plans and specifications; nor shall this review serve in any way to alter the contract plans or specifications. The preparer of this submittal is solely responsible for the accuracy of dimensions, selection of proper materials, development of techniques, safety, and proper construction in performance of the work depicted hereon.

- [x] No Exceptions Taken
- [ ] Make Corrections Noted
- [ ] Amend and Resubmit
- [ ] Rejected
- [ ] Review Not Required

By: _____ Date 10/31/11

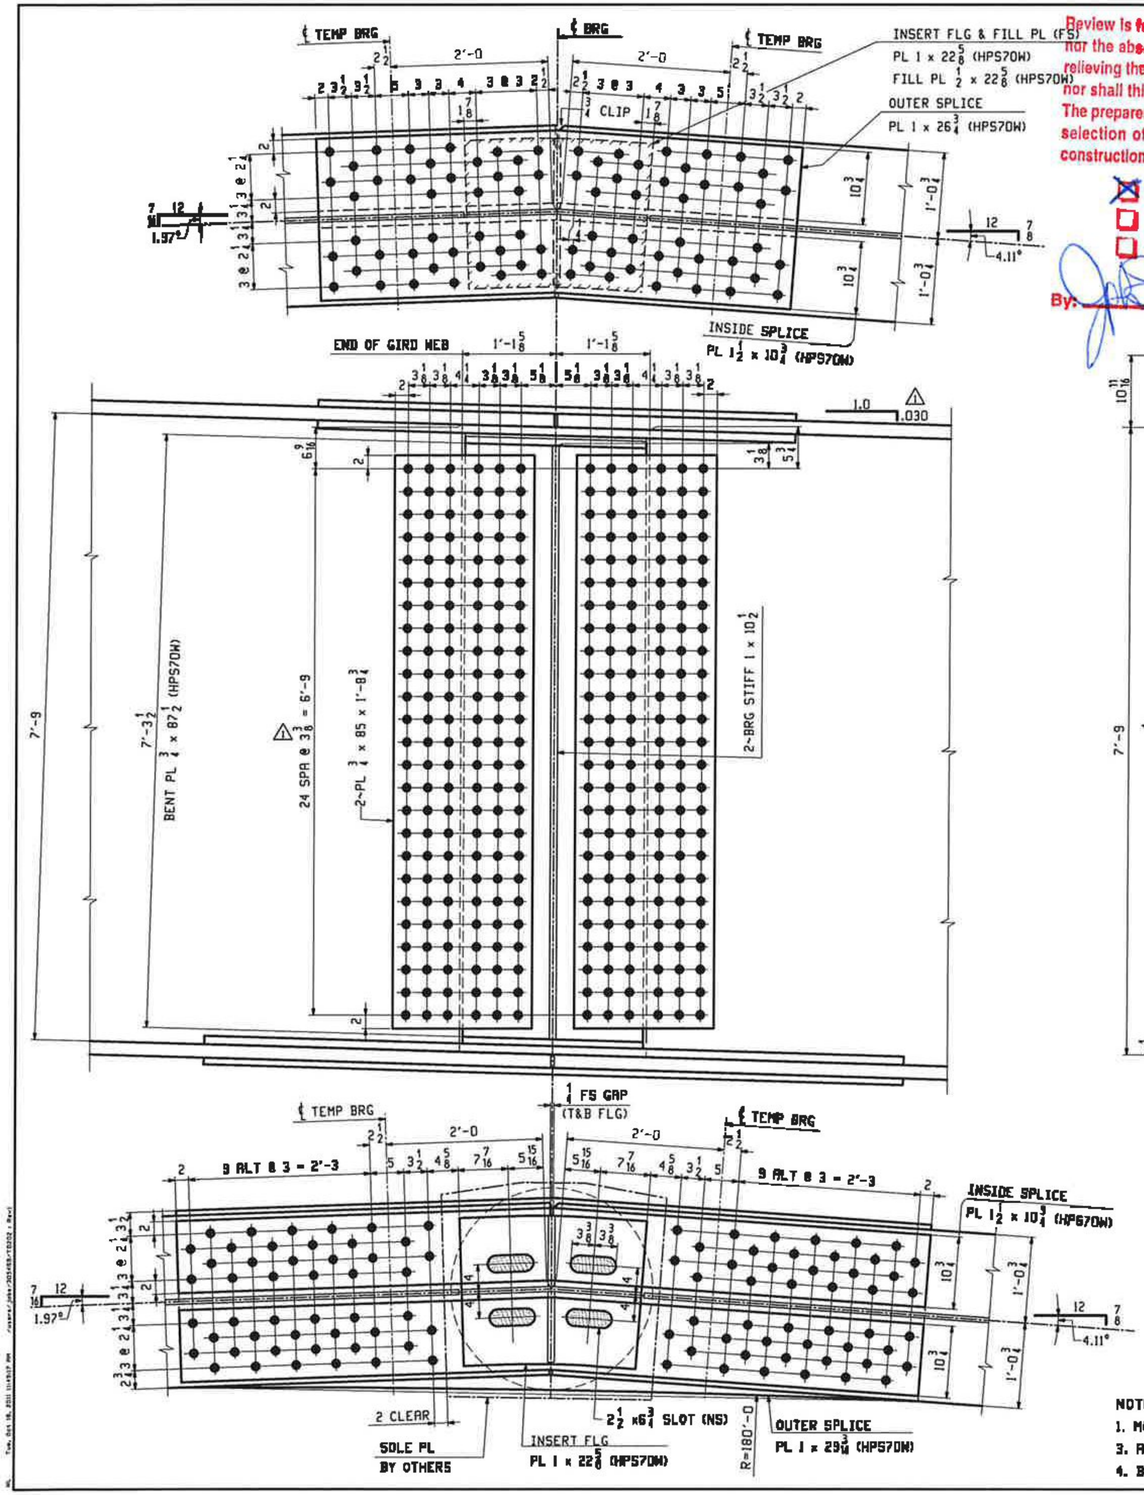

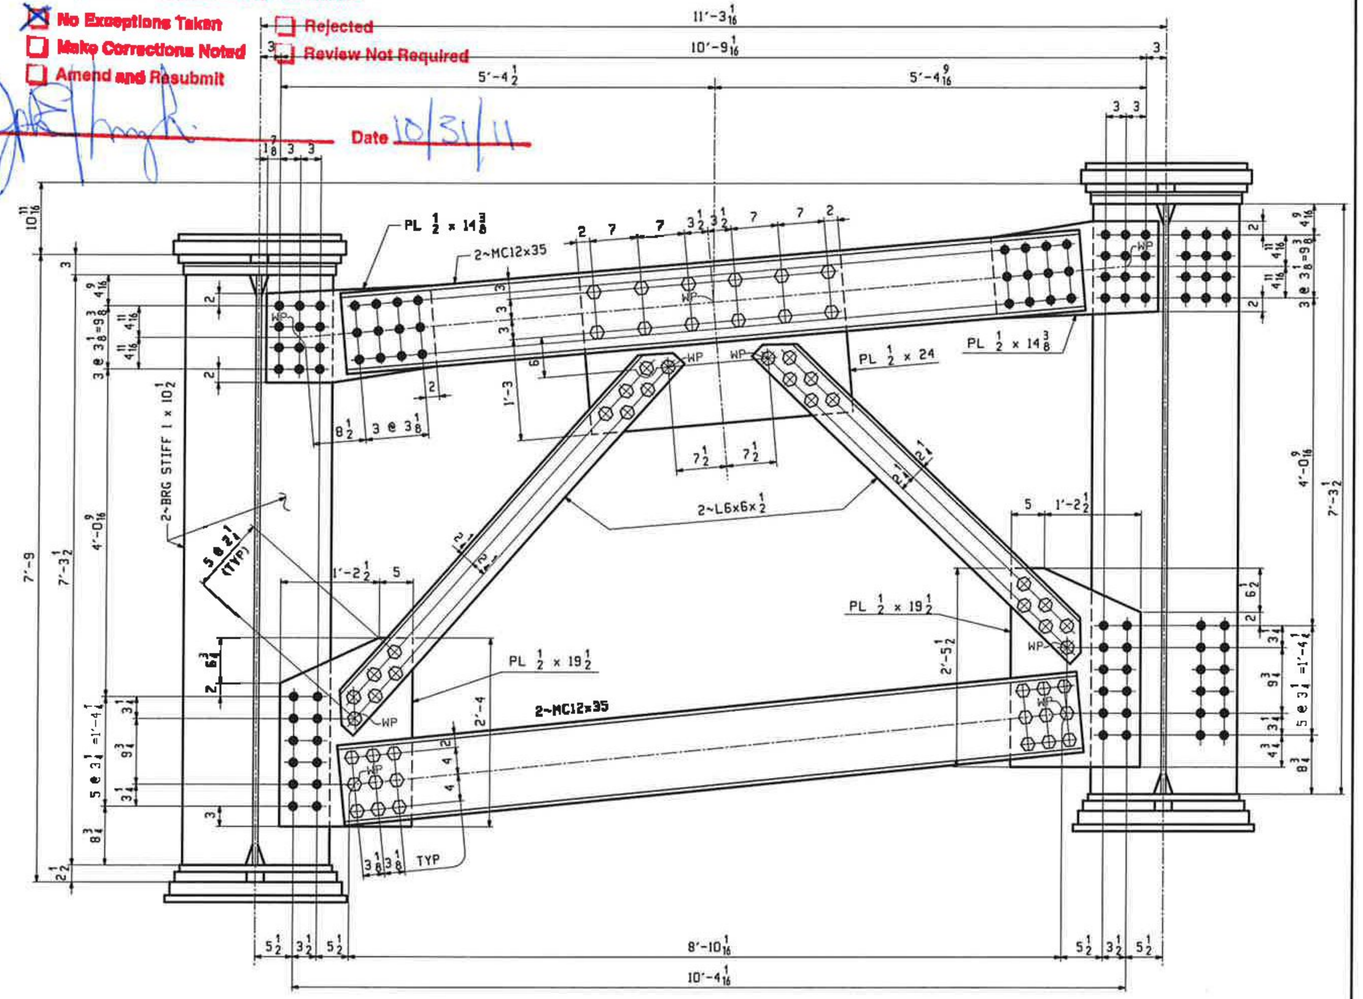

PIER CROSSFRAME "CF2"

LOOKING BACK STATION

** NOTE **
THE PURPOSE OF THIS DRAWING IS TO COORDINATE GEOMETRIC CONTROL INFORMATION AND CONNECTION SPACING. THIS DWG IS SUBMITTED FOR INFORMATION ONLY & IS NOT INTENDED FOR SHOP FABRICATION. DETAIL DWGS WILL SHOW ALL WELDING AND DIMENSIONS REQ'D FOR FABRICATION.

NOTES:

1. MATERIAL IS A709-50W (UN).
3. ALL HOLES SHALL BE 1 1/16ø.
4. BOLTS SHALL BE 1"ø A325 TYPE 3.

REV.	DATE	REMARKS	DWN	CHK	APVL	SHOP
1	10/18	REVISE GRADE DIRECTION & VERT. DIM.	JTB	WL		
0						

MATERIAL:	SURFACE PREP. & PAINT:	HOLES:	SHOP BOLTS:
A709-50W (UN)	SEE GN1	AS NOTED	AS NOTED

DESCRIPTION: PIER CROSSFRAME LAYOUTS

CASCO BAY STEEL STRUCTURES, INC.
1 WALLACE AVE.
SOUTH PORTLAND, ME 04106
PHONE (207) 780-6722
FAX. (207) 780-5726

STRUCTURE: I-91 BRIDGE 69 OVER WHITESTONE BROOK & WILLIAMS STREET COUNTY OF WINDHAM

LOCATION: Town of Brattleboro, VT.

PROJ NO. IM 091-1(50)

CUSTOMER: BECK & BELLUCI

DRAWN:	DATE:
WL	06/25
CHKD:	DATE:
JTB	07/08
JOB NO.	DWG NO.
479	TD202
	REV. 1