


## TAPERED WEB ELEVATION FOR G1A-G4A

NOTE: ALL LONGITUDINAL DIMENSIONS ARE SHOWN FOR GIRDER G1A.
GIRDERS G2A- G4A ARE SIMILAR, SEE WS201 FOR DIMENSIONS & LOCATIONS OF U1.

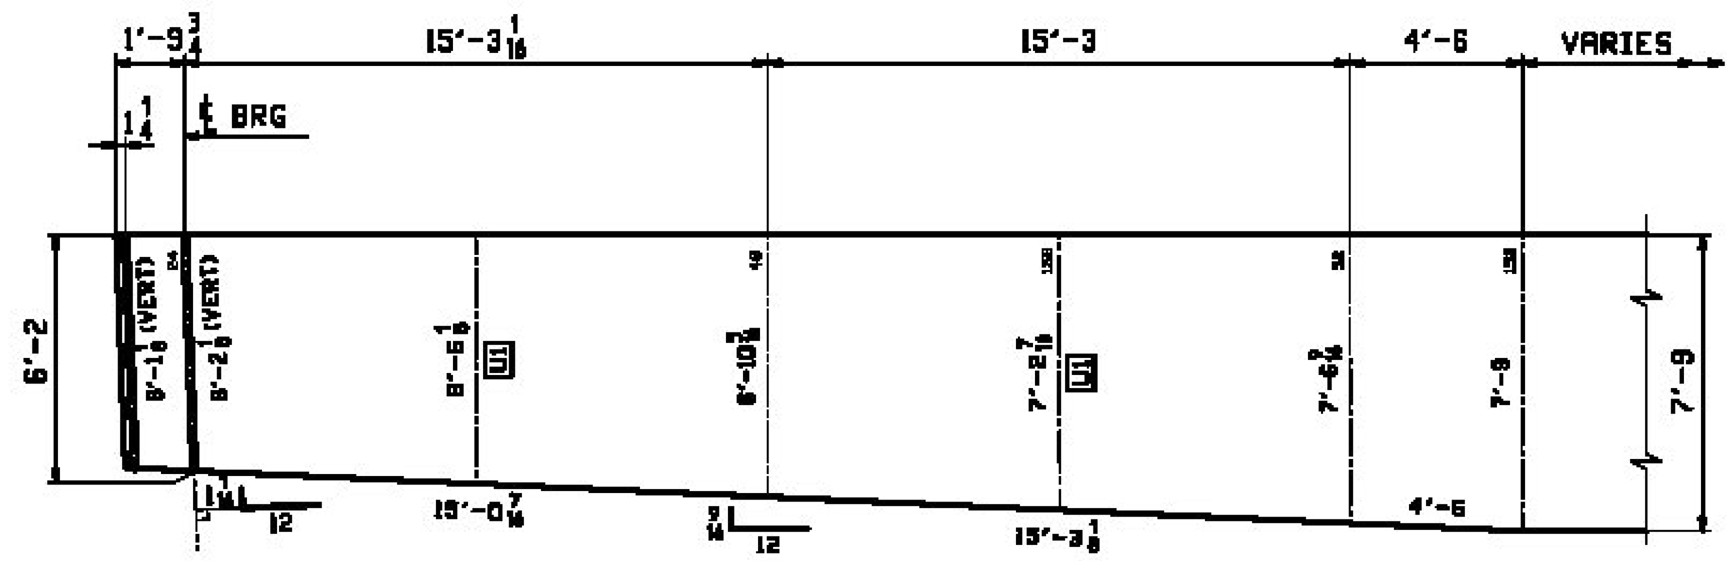


## TAPERED WEB ELEVATION FOR G1E-G4E

NOTE: ALL LONGITUDINAL DIMENSIONS ARE SHOWN FOR GIRDER G1E.
GIRDERS G2E- G4E ARE SIMILAR, SEE WS201 FOR DIMENSIONS & LOCATIONS OF U1.

X No Exception Taken
Make Correction as Noted
Submit Specified Item
Revise and Resubmit as Noted
Rejected

T-Y-LININTERNATIONAL

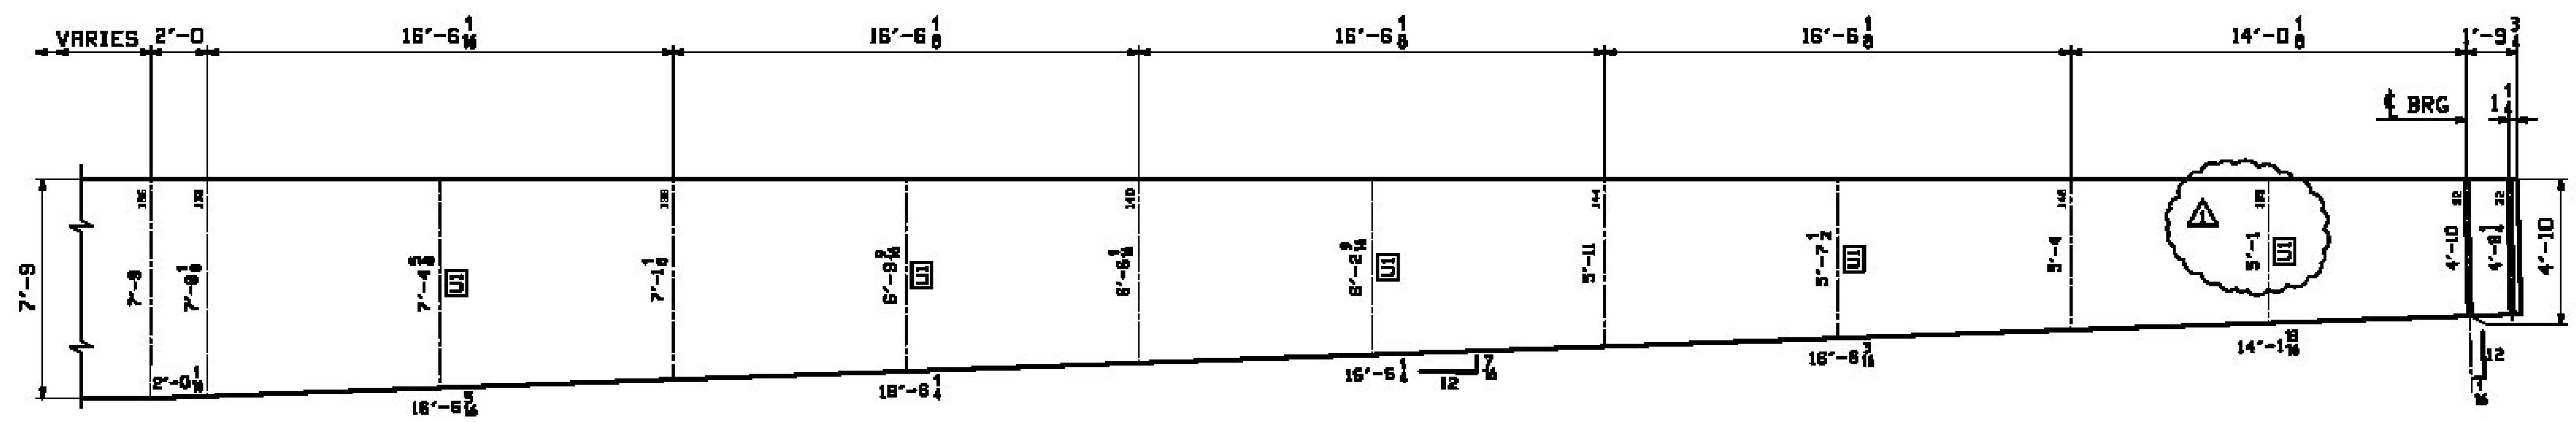Checking is for general compliance with the design concept of the project and general compliance with the information given in the contract documents only. Any action shown is not an approval and is subject to the requirements of the plans and specifications. Any action shown on a specific item shall not indicate the checking of an assembly of which the item is a component. Contractor is solely responsible for: dimensions which shall be confirmed and correlated at the job site, fabrication processes, techniques of construction, safety precautions; and coordination of its work with that of all other trades and the satisfactory performance of its work.

Reviewed By: [signature] Date: May 29, 2012

| REV. | DATE | REMARKS | DWN | CHK | APVL | SHOP |
|---|---|---|---|---|---|---|
| ⚠1 | 5/10 2012 | ADD UTILITY SUPPORT BETWEEN G3E/G4E (EXTRA-TEC-3054001) | JTB | TJB | | |
| 0 | | | | | | |

| MATERIAL: | SURFACE PREP. & PAINT: | HOLES: | SHOP BOLTS: |
|---|---|---|---|
| M270-50W (UN) | SEE GN1 | AS NOTED | AS NOTED |

DESCRIPTION: SB TAPERED WEB ELEVATIONS

**CASCO BAY STEEL STRUCTURES, INC.**
1 WALLACE AVE. PHONE (207) 780-6722
SOUTH PORTLAND, ME 04106 FAX. (207) 780-6726

| | | | |
|---|---|---|---|
| STRUCTURE: | I-91 BRIDGE 6S OVER WHITESTONE BROOK & WILLIAMS STREET COUNTY OF WINDHAM | DRAWN: WL | DATE: 06/24 |
| | | CHKD: JTB | DATE: 07/08 |
| LOCATION: | Town of Brattleboro, VT. | JOB NO. | DWG NO. |
| PROJ NO. | IM 091-1(5D) | 479 | WE201 |
| CUSTOMER: | BECK & BELLUCCI | | REV. ⚠1 |