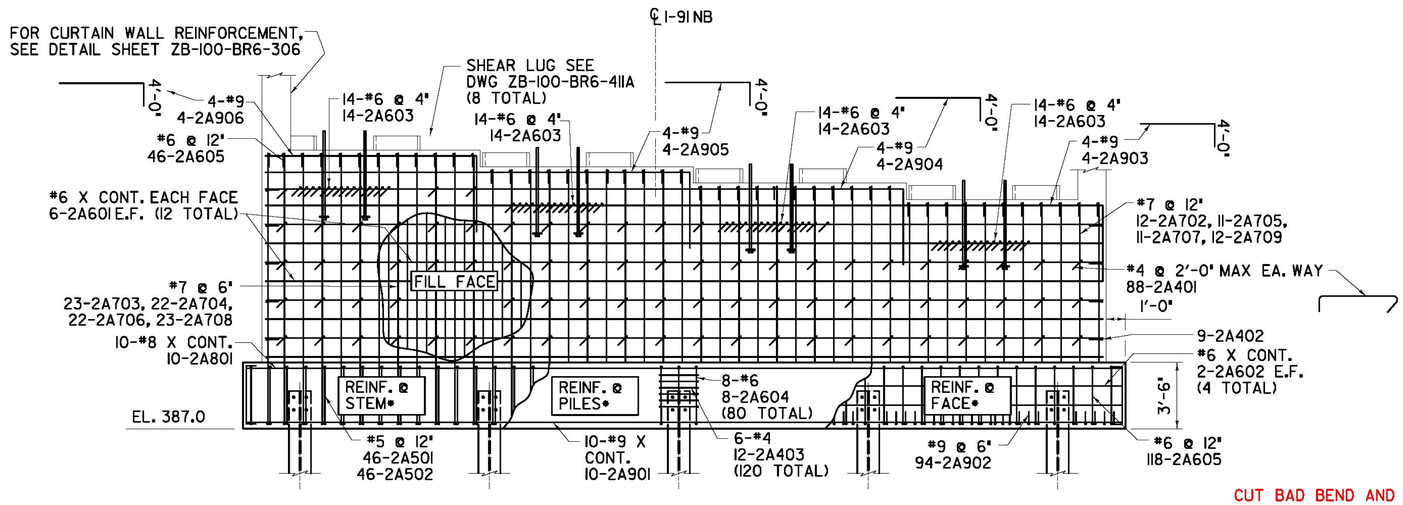

ABUTMENT #2 - FOOTING ELEVATION

SCALE: 1/4 "= 1'-0"

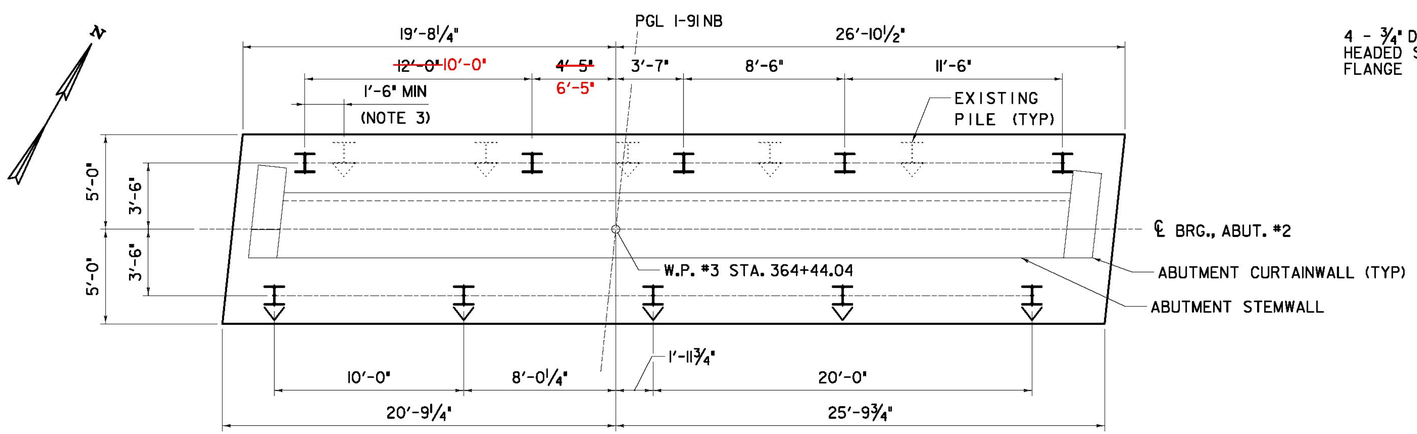

ABUTMENT #2 - FOUNDATION PLAN

SCALE: 1/4 "= 1'-0"

(WINGWALL FOUNDATIONS NOT SHOWN)

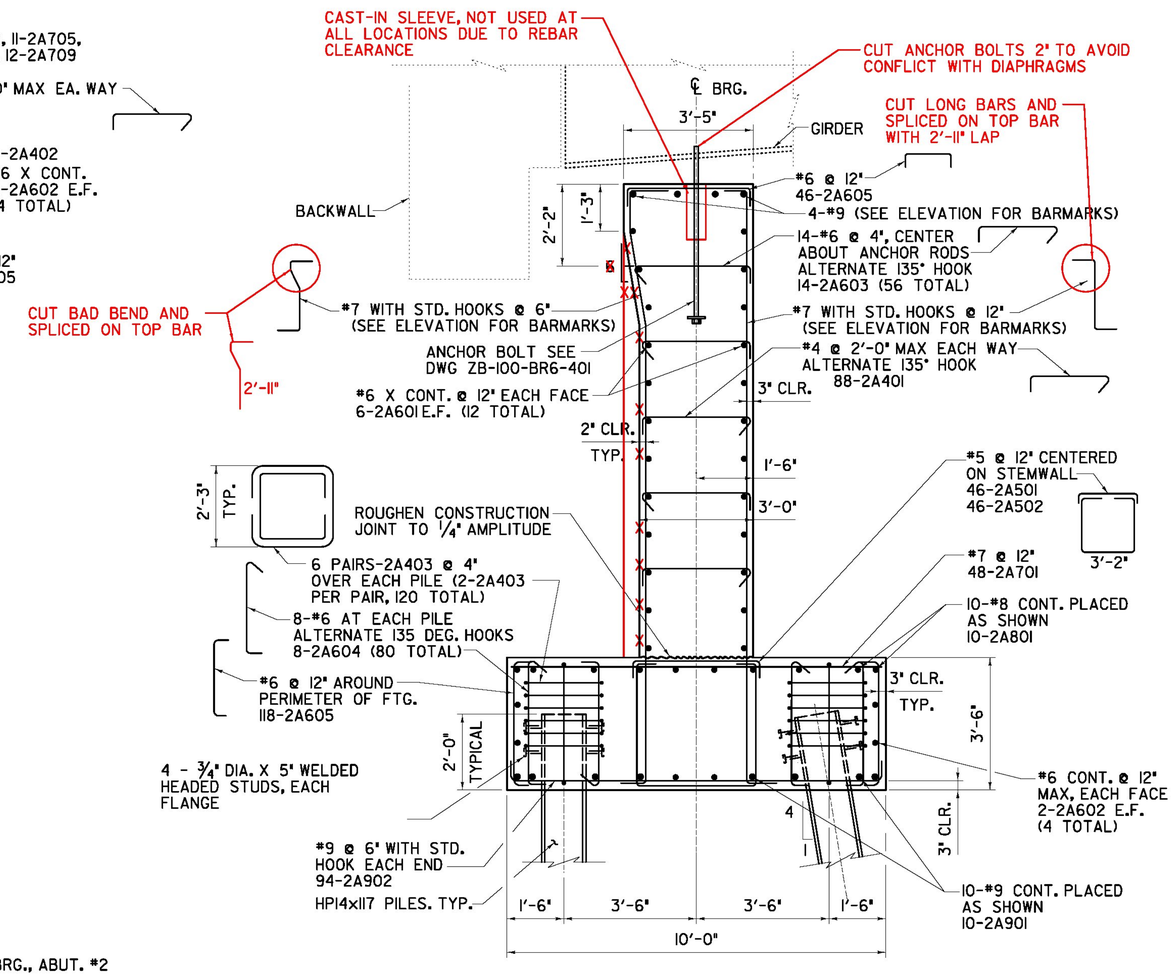

TYPICAL SECTION

SCALE: 1/2 "= 1'-0"

NOTES:

1. SEE SUPERSTRUCTURE DRAWINGS FOR BACKWALL REINFORCEMENT AND DETAILS.
2. SEE 'ZB-100-BR6-305' FOR PILE STUD DETAILS.
3. ABUTMENT PILES IN THE BACK ROW HAVE BEEN SPACED TO AVOID EXISTING PILES, BASED ON SURVEY INFORMATION AND AS-BUILT PLANS. THE ENGINEER SHALL BE NOTIFIED IF THE PROPOSED PILE LAYOUT RESULTS IN THE INSTALLATION OF A PROPOSED PILE WITHIN 1.5FT OF AN EXISTING PILE.

AS BUILT RECORD PLANS

PROJECT NAME:	BRATTLEBORO
PROJECT NUMBER:	IM 091-1(50)

BECK & BELLUCCI, INC. | T·Y·LIN INTERNATIONAL

FILE NAME: ZB-100-BR6-306.dgn	PLOT DATE: 5/15/2013
PROJECT LEADER: Phillip E. Kendall P.E.	DRAWN BY: DGA
DESIGNED BY: Mike Lopez, P.E.	CHECKED BY: J. England, P.E.
BR 6N - ABUT 2 FOOTING REINFORCEMENT	SHEET ZB-100-BR6-306