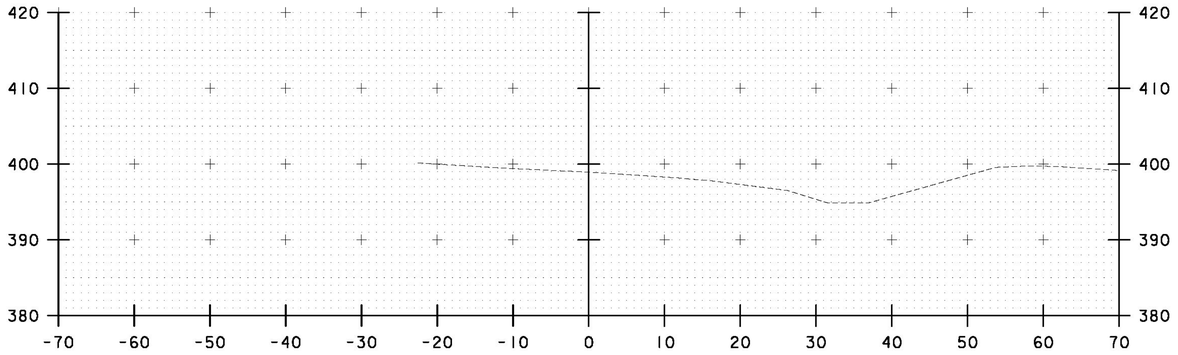

567+50

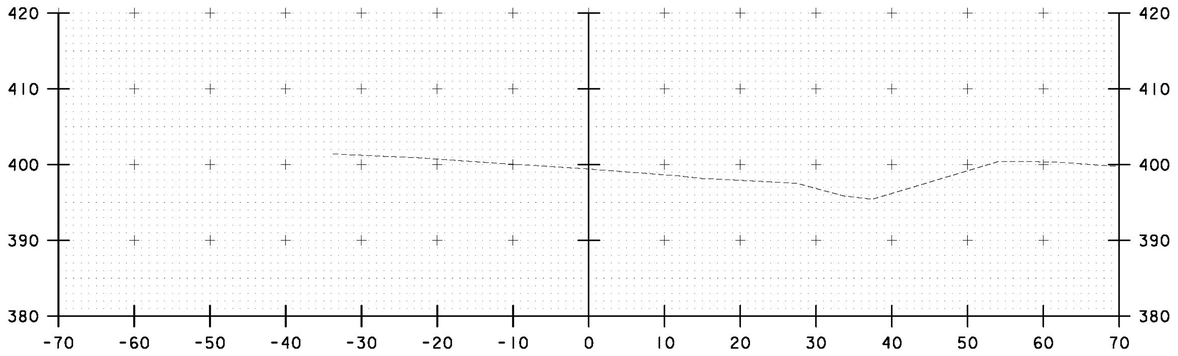

567+00

LIMIT OF WORK

END MILL AND OVERLAY

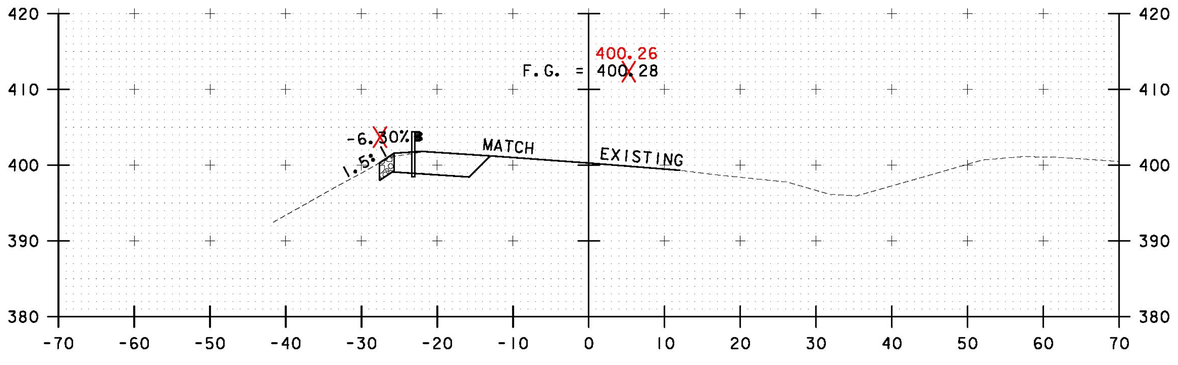

566+50

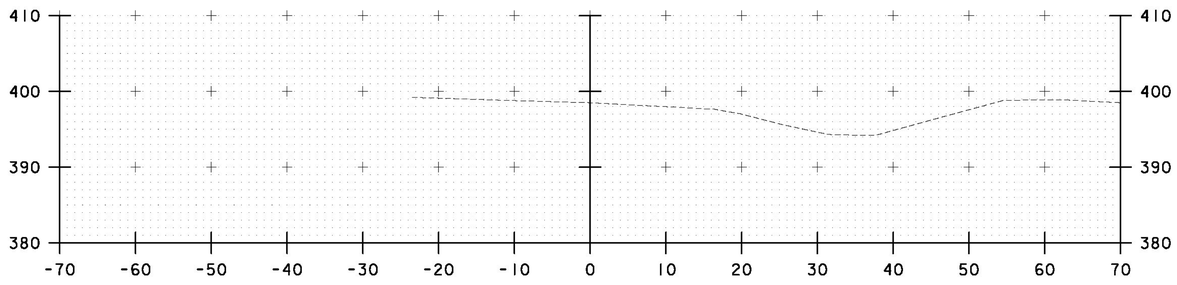

568+14

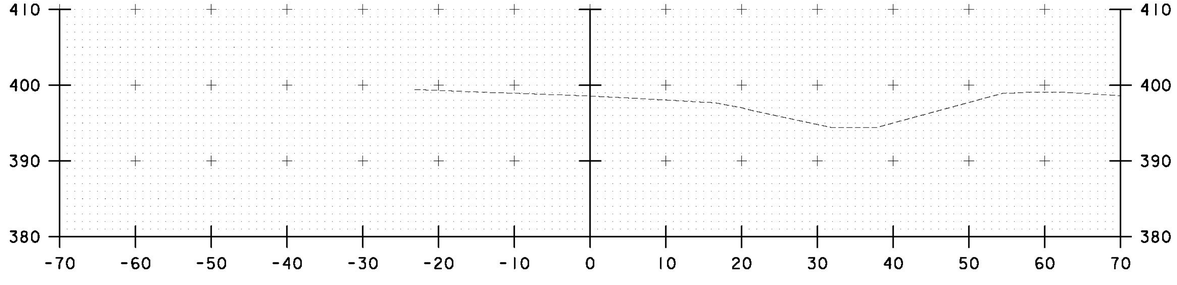

568+00

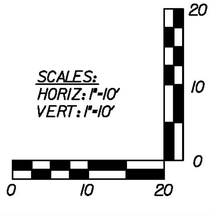

AS BUILT
RECORD PLANS

STA. 566+50 TO STA. 568+14

PROJECT NAME: BRATTLEBORO

PROJECT NUMBER: IM 091-1(50)

BECK & BELLUCCI, INC.

T.Y. LIN INTERNATIONAL

FILE NAME: HW-SRA-DGN-900.dgn
PROJECT LEADER: Phillip E. Kendall P.E.
DESIGNED BY: Phillip E. Kendall P.E.
CROSS SECTIONS 7 OF 7

PLOT DATE: 2/22/2013
DRAWN BY: J. Davis
CHECKED BY: D. Bryant, P.E.
SHEET HW-SRA-DGN-907