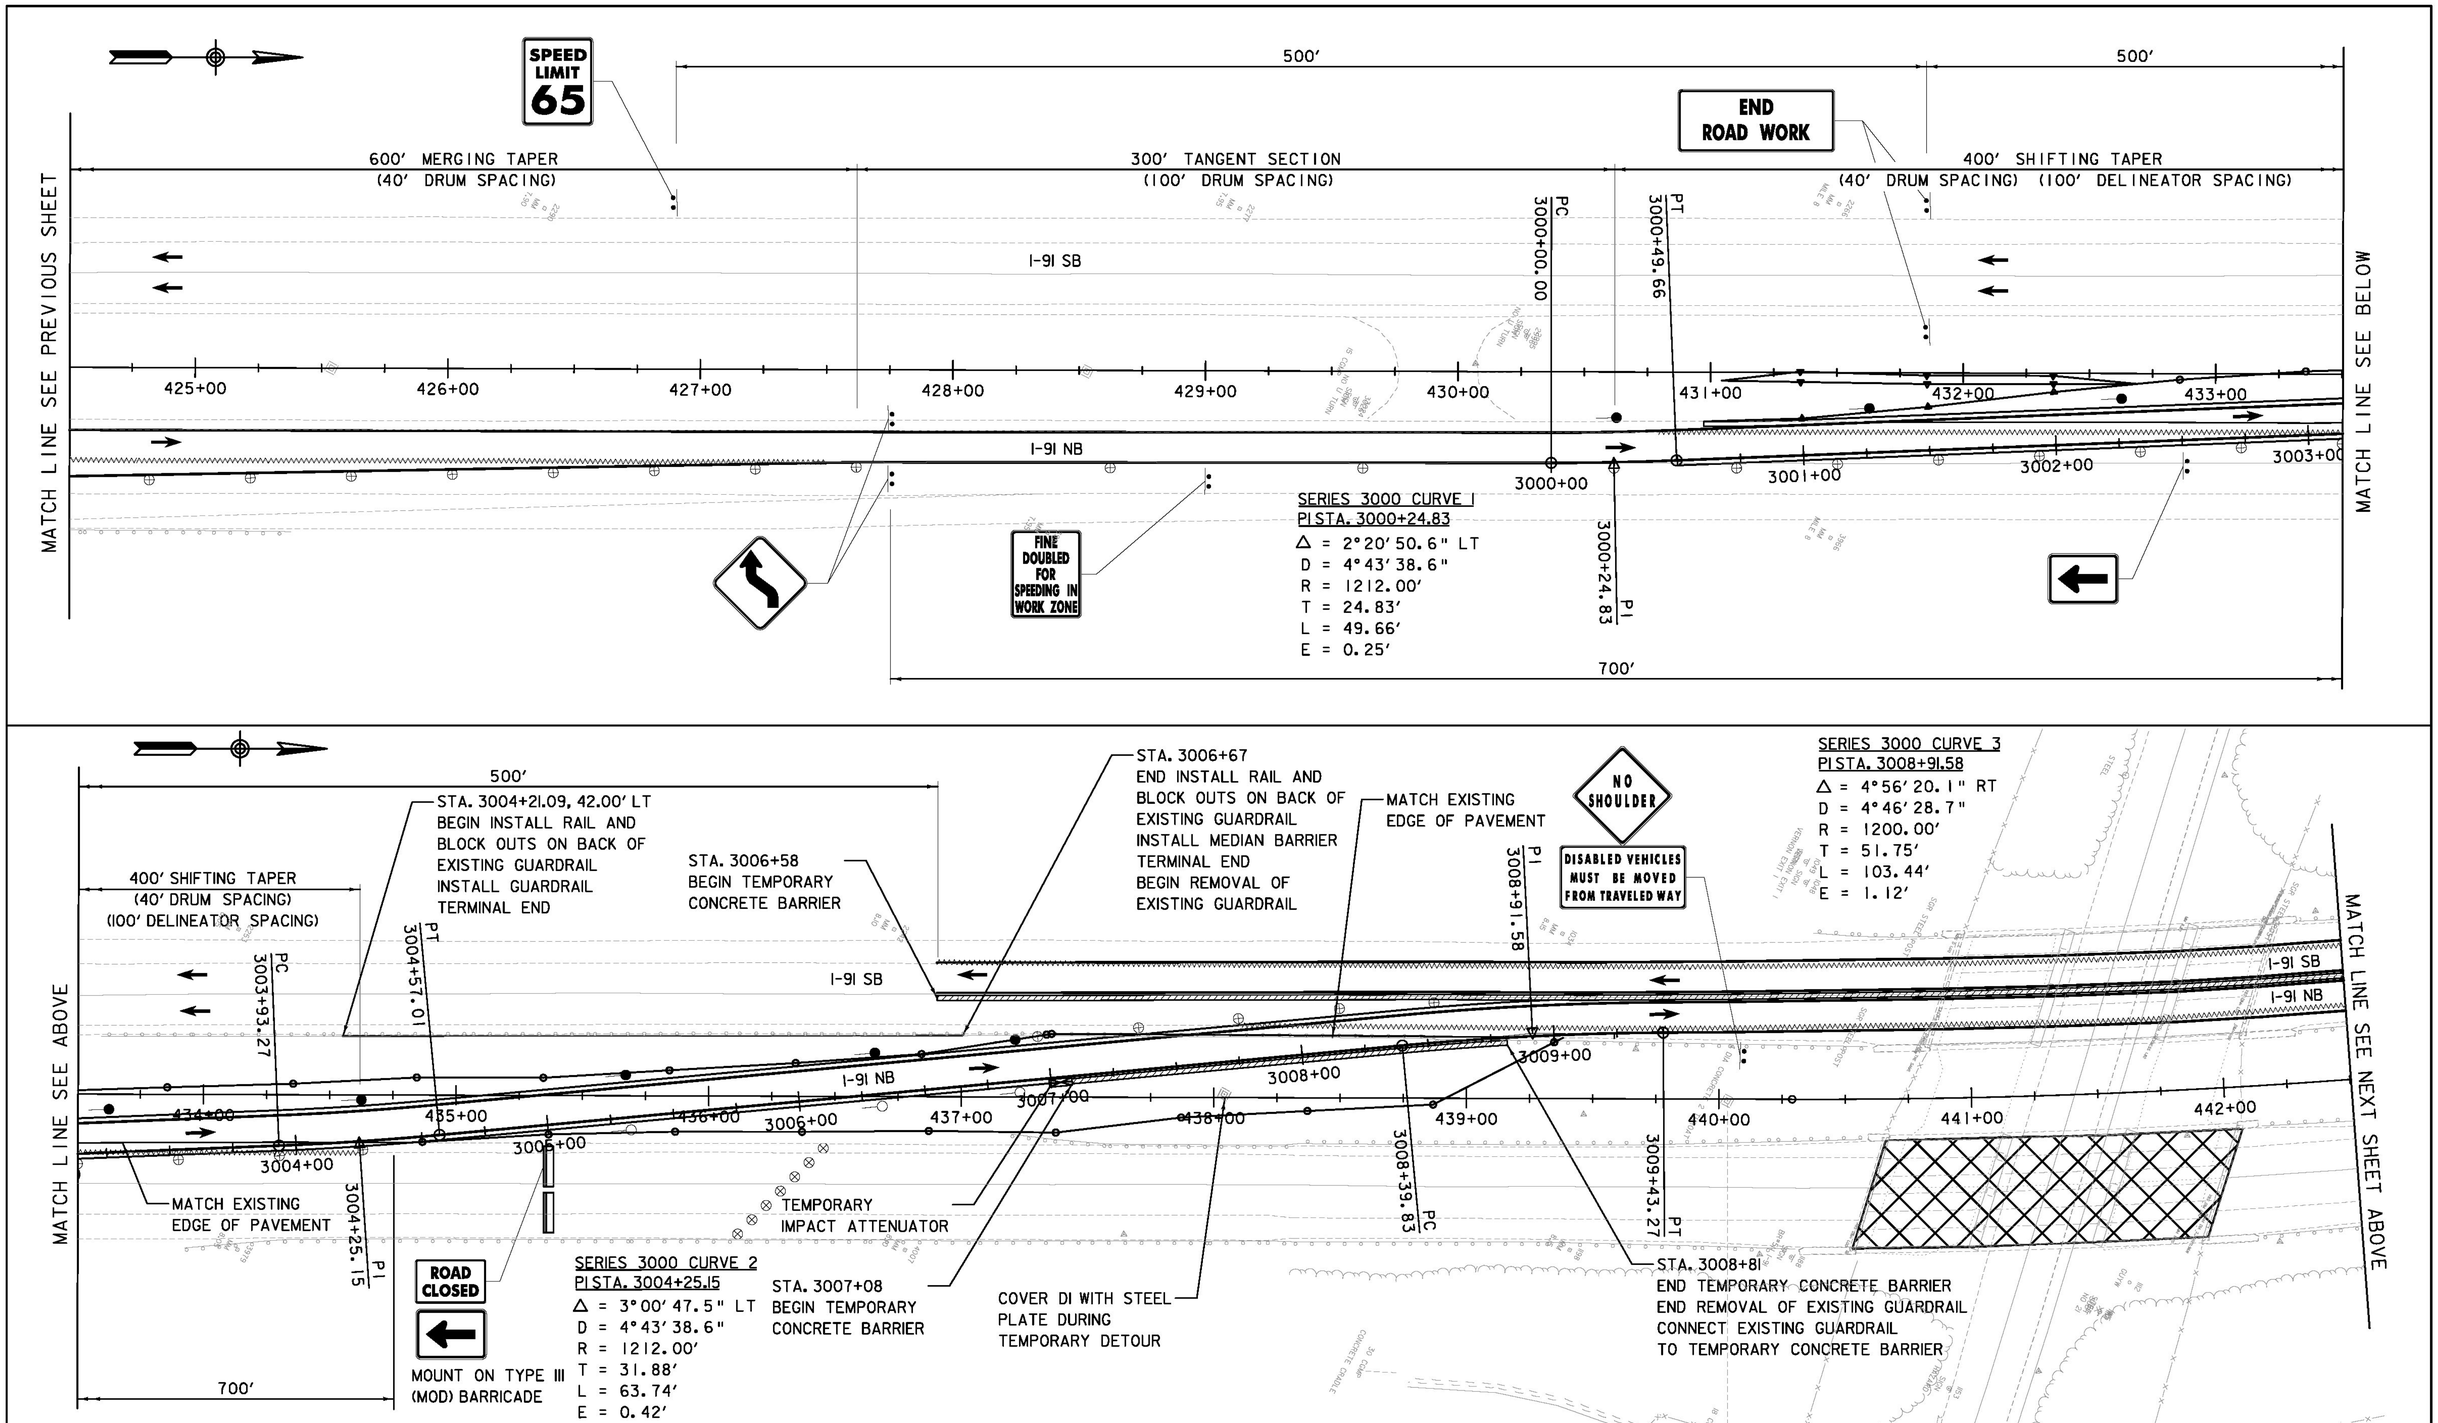

AS BUILT RECORD PLANS

SCALE 1″ = 30′-0″
30 0 30

RFC - WORK PACKAGE #2A
MARCH 21, 2011

NOTE:
SEE SHEET HW-100-NC0-501 FOR LEGEND.

PROJECT NAME:	BRATTLEBORO
PROJECT NUMBER:	IM 091-1(50)

BECK & BELLUCCI, INC. | T·Y·LIN INTERNATIONAL

FILE NAME: HW-100-NC0-504.dgn	PLOT DATE: 3/18/2011
PROJECT LEADER: Brian W. Clogston P.E.	DRAWN BY: J. R. Howe P.E.
DESIGNED BY: Phillip E. Kendall P.E.	CHECKED BY: D. Bryant P.E.
NORTHBOUND CLOSURE TCP 4 OF 7	SHEET HW-100-NC0-504