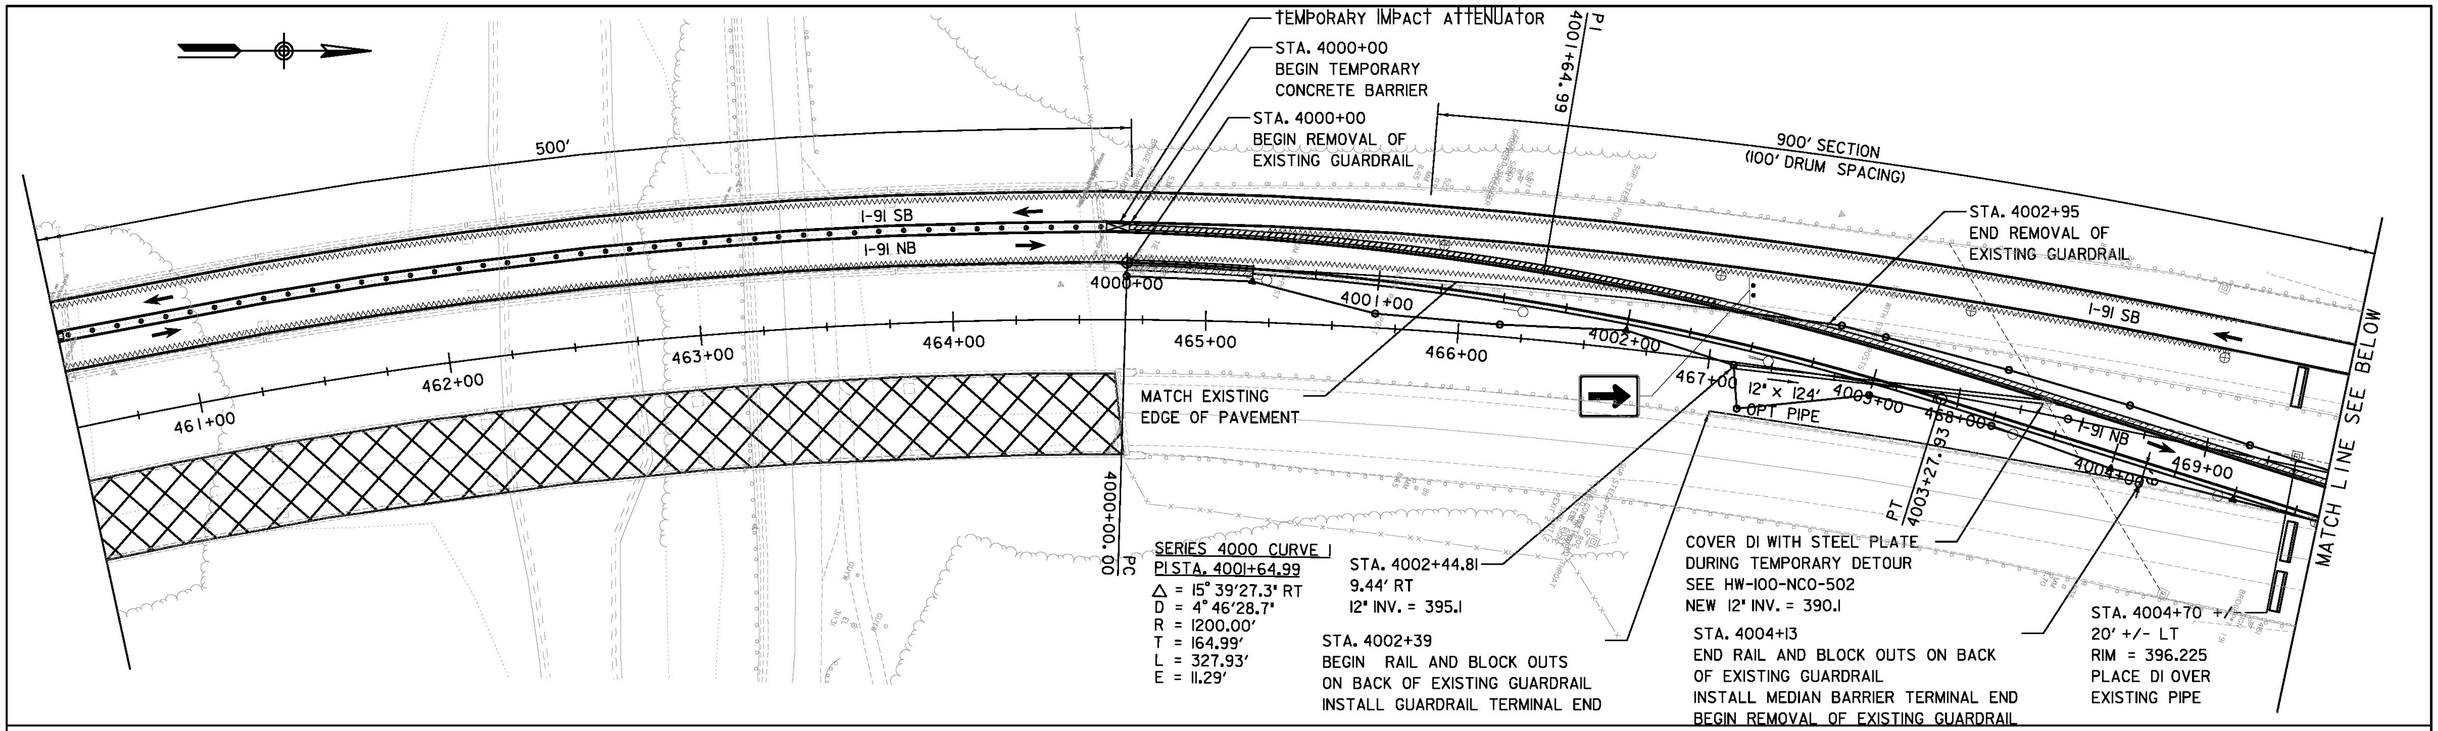

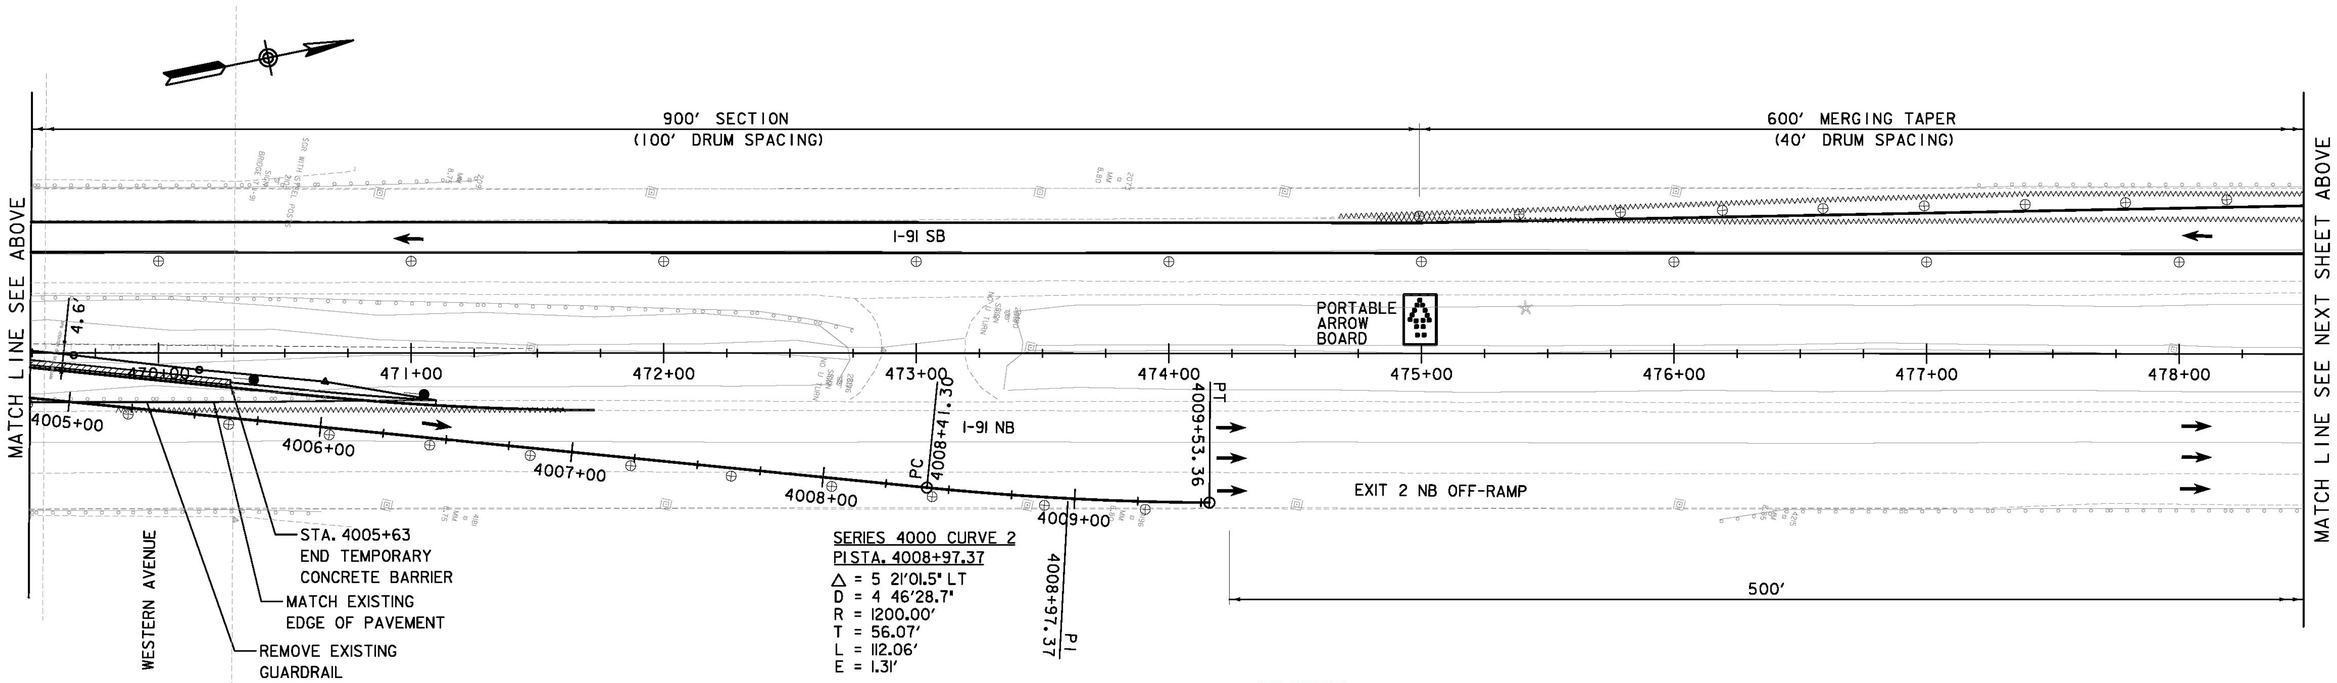

AS BUILT
RECORD PLANS

RFC - WORK PACKAGE #2A
MARCH 21, 2011

SCALE 1" = 30'-0"
30 0 30

NOTE:
SEE SHEET HW-100-NCO-501 FOR LEGEND.

BECK & BELLUCCI, INC.	T·Y·LIN INTERNATIONAL

PROJECT NAME: BRATTLEBORO	
PROJECT NUMBER: IM 091-1(50)	
FILE NAME: HW-100-NCO-506.dgn	PLOT DATE: 3/18/2011
PROJECT LEADER: Brian W. Clogston P.E.	DRAWN BY: J. R. Howe P.E.
DESIGNED BY: Phillip E. Kendall P.E.	CHECKED BY: D. Bryant P.E.
NORTHBOUND CLOSURE TCP 6 of 7	SHEET HW-100-NCO-506