STATE OF VERMONT
AGENCY OF TRANSPORTATION

TRAFFIC SIGN SUMMARY SHEET #1

MILEMARKER, STATION, OR SIGN NUMBER	SIGN LEGEND	SIGN DIMENSIONS EA	SIGN DIMENSIONS WIDTH (in)	SIGN DIMENSIONS HEIGHT (in)	NEW & SALVAGED SIGNS "A"	NEW & SALVAGED SIGNS "B"	NEW & SALVAGED SIGNS SALV SIGN	NEW & SALVAGED SIGNS SALV TIS	EXIST POST RETAIN	EXIST POST SALVAGE	NEW SIGN POSTS NO. OF POSTS	FLANGED CHANNEL lb/ft 1.12	FLANGED CHANNEL lb/ft 2.0	FLANGED CHANNEL lb/ft 3.0	SQUARE STEEL (in) lb/ft 1.75 1.88	SQUARE STEEL (in) lb/ft 2.0 2.16	SQUARE STEEL (in) lb/ft 2.5 3.35	ANCHOR	SLEEVE	TUBULAR ALUMINUM Ø (in) lb/ft 3.0 1.3	TUBULAR ALUMINUM Ø (in) lb/ft 4.0 1.7	TUBULAR ALUMINUM Ø (in) lb/ft 4.0 MOD 1.7	TUBULAR STEEL Ø (in) FOUND-ATION	TUBULAR STEEL Ø (in) lb/ft 3.0 7.6	TUBULAR STEEL Ø (in) lb/ft 3.5 9.0	TUBULAR STEEL Ø (in) lb/ft 4.0 10.8	TUBULAR STEEL Ø (in) lb/ft 5.0 14.6	~~W-SHAPE STEEL~~ REMOVAL FTG. SIZE 24"	~~W-SHAPE STEEL~~ REMOVAL FTG. SIZE 30"	~~W-SHAPE STEEL~~ REMOVAL WEIGHT	~~W-SHAPE STEEL~~ REMOVAL POST SIZE	SIGN FRAME REQUIRED	REMARKS	SIGN DETAIL DETAIL ON SHEET NUMBER	SIGN DETAIL STD. SHEET NUMBER
											OPTION ITEMS																								
I-91 0+00 LT 52+80 LT 105+60 LT 158+40 LT 211+20 LT 264+00 LT 316+80 LT 369+60 LT 422+40 LT 475+20 LT 528+00 LT 580+80 LT		10 2	12 12	24 36	20.00 6.00						12		X 10 11 11 11 11 11 6 12 11 10 11 11		X															1 1 1 1 1 1 1 1 1 1 1 1					E-139
I-91 624+47 LT					20.0		1				2			X 33'		X														1+1			SIGN REPLACED AFTER NEW POSTS SET DUE TO BEING HIT BY TRAFFIC		
I-91 0+00 RT 4+75 RT 102+43 RT 221+23 RT 307+30 RT 348+48 RT 419+76 RT 463+06 RT 498+96 RT 591+36 RT 628+32 RT		11	36	36	99.00						22		12 30 30 31 30 30 29 29 29 30 29	X		X														1 1 1 1 1 1 1 1 1 1 1					E-143
EXIT 1 RAMP A ON RAMP 1+60 LT		1	18	18	+2.25 2.25						1		+9 X +9		X															1+1			SIGN AND POST REPLACED DUE TO DAMAGE		E-150
EXIT 1 RAMP A ON RAMP 3+50 RT		1	36	36	9.00						2			X 37'		X														2					E-142
		1	36	36	9.00																														E-142
EXIT 1 RAMP A ON RAMP 10+75 RT		1	30	30	6.25						1			X 15'		X														1					E-143
EXIT 1 RAMP C OFF RAMP 1+80 LT	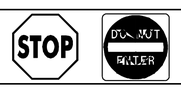	1 1	30 30	30 30	6.25 6.25						1			X 14'		X														4			BACK TO BACK		E-143 E-143
		1 1	36 36	12 12	3.00 3.00																												BACK TO BACK		E-142 E-142
												FT	FT 470' ~~195~~	FT 99' ~~420~~	FT 195	FT 420	FT		EA	LB	LB	LB		LB	LB	LB	LB							
TOTALS					SF 192.25 ~~170.00~~	SF	EA. 1	SF				FT 569 ~~615~~			FT 615					LB			EA.	LB				EA.	EA.	LB 33					

FINAL POST LENGTHS ARE TO BE DETERMINED IN THE FIELD. POST SIZES ARE COMPUTED BASED ON INFORMATION FURNISHED ON THE STANDARD SHEETS AND THE TRAFFIC & SAFETY DIVISION'S "SIGN POST DESIGN GUIDELINE."

PROJECT NAME: GUILFORD-BRATTLEBORO
PROJECT NUMBER: AC IM 091-1(54)

FILE NAME: 05A014ss01.1
PROJECT LEADER: CRB
DESIGNED BY: CLD
CLD REF. NO. 05-0387
PLOT DATE: 22-JAN-2009 13:4
DRAWN BY: MRS
CHECKED BY: NLL
SHEET 65 OF 69