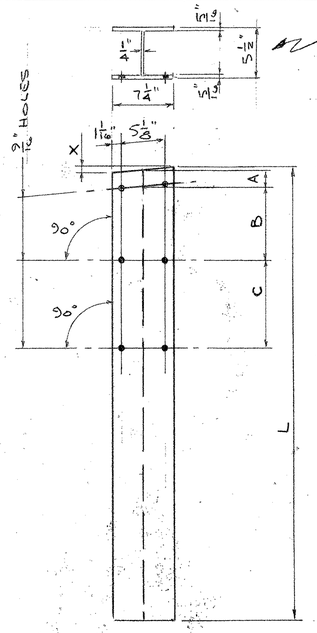

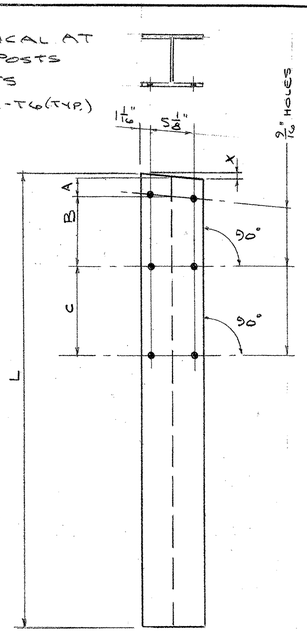

APPROACH POSTS

MK	QUAN	X	L	A	B	C

APPROACH POSTS

MK	QUAN	X	L	A	B	C
A1	1	7/16"	6'-6"	1 1/2"	9 7/8"	12 1/2"
A2	1	7/16"	6'-6"	1 1/2"	8 9/16"	11 7/8"
A3	1	7/16"	6'-6"	1 1/2"	7 5/16"	11 3/16"
A4	1	7/16"	6'-6"	1 1/2"	6"	10 1/2"
A5	1	1/4"	6'-0"	2"	9 5/8"	0
A6	1	1/4"	6'-0"	2"	8 13/16"	0
A7	1	1/4"	6'-0"	2"	7 7/8"	0

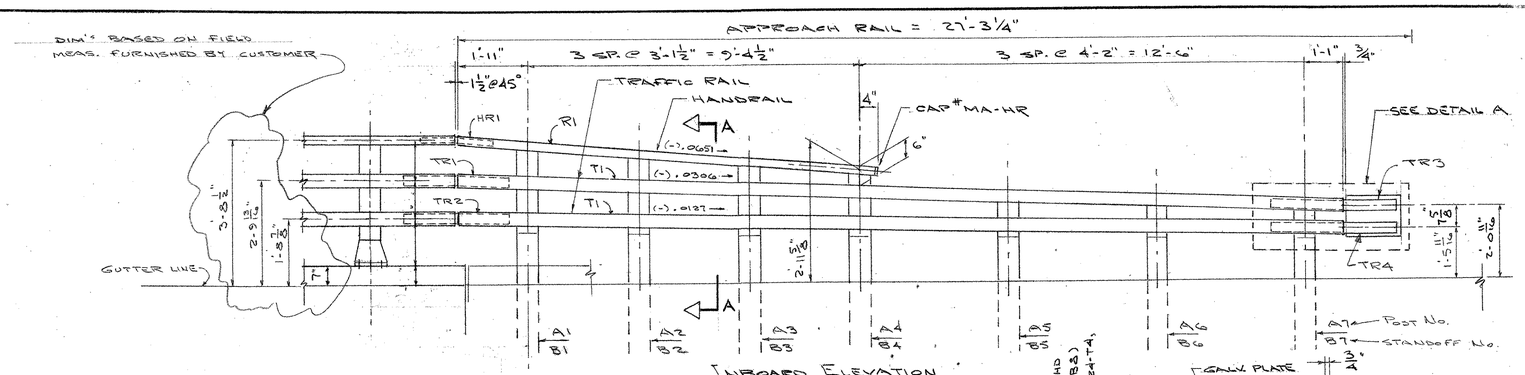

INBOARD ELEVATION
R.H. AS SHOWN

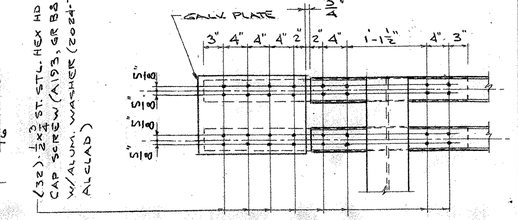

DETAIL A
OUTBOARD VIEW

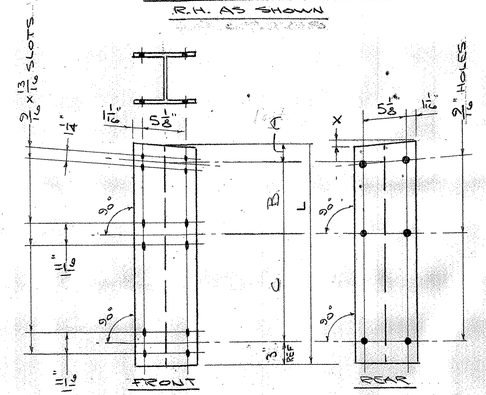

STANDOFF

MK	QUAN	X	L	A	B	C
B1	1	7/16"	2'-2 7/8"	1 1/2"	9 7/8"	12 1/2"
B2	1	7/16"	2'-0 15/16"	1 1/2"	8 9/16"	11 7/8"
B3	1	7/16"	1'-11"	1 1/2"	7 5/16"	11 3/16"
B4	1	7/16"	1'-9"	1 1/2"	6"	10 1/2"
B5	1	1/4"	1'-2 5/8"	2"	9 5/8"	0
B6	1	1/4"	1'-1 13/16"	2"	8 13/16"	0
B7	1	1/4"	1'-0 7/8"	2"	7 7/8"	0

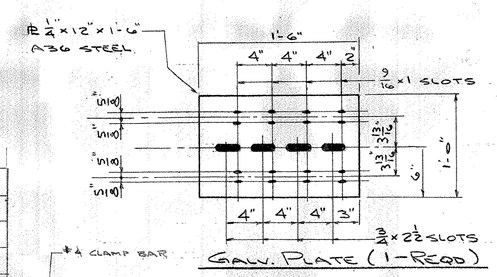

GALV. PLATE (1-REQD)

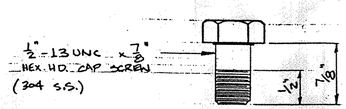

"C" BOLT

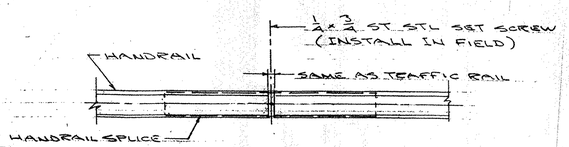

DET. AT HANDRAIL SPLICE
OUTBOARD VIEW

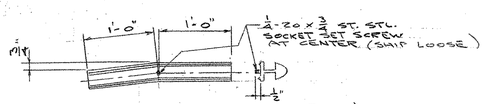

HANDRAIL SPLICE HR1 (1-REQD)

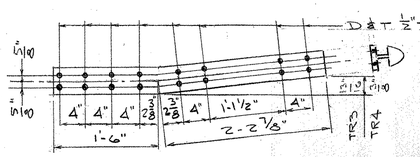

TRAF. RAIL SPLICE TR3 (1-REQD)
TRAF. RAIL SPLICE TR4 (1-REQD)

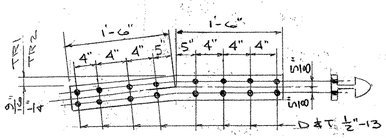

TRAF. RAIL SPLICE TR1 (1-REQD)
TRAF. RAIL SPLICE TR2 (1-REQD)

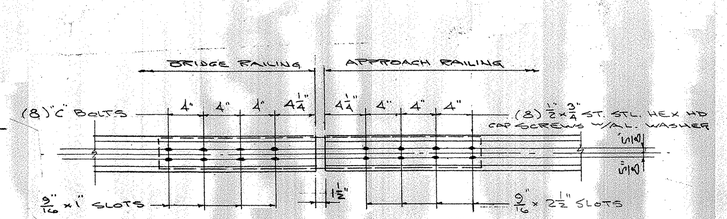

DET. AT TRAFFIC RAIL SPLICES TR1 & TR2
OUTBOARD VIEW

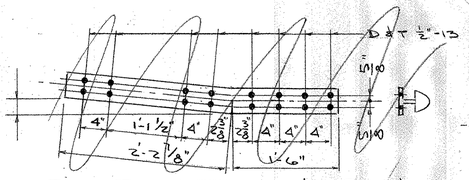

TRAF. RAIL SPLICE (-REQD)
TRAF. RAIL SPLICE (-REQD)

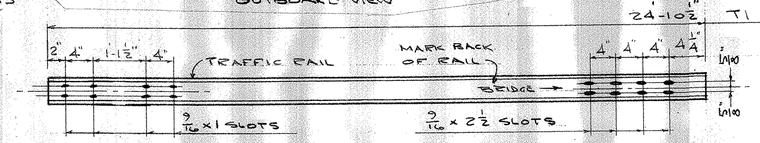

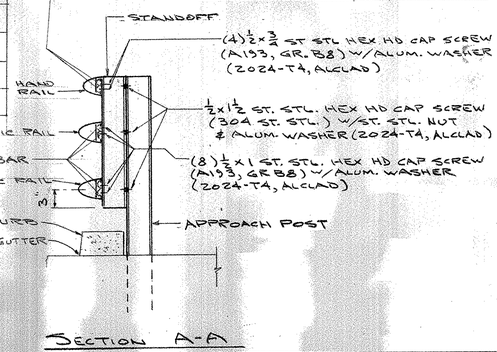

SECTION A-A

FINISH: MILL FINISH

AUCIELLO IRON WORKS INC
560 MAIN ST. HUDSON, MA. (508) 568-8382

VT. AGENCY OF TRANSPORTATION
BRATTLEBORO
PROJ # ACIM 09151 (54)

RECEIVED
CK'D BY LFW OK'D BY MP
OCT 27 2006
RESUBMIT ____ APPROVED ✓
BY DATE 10/27/06

ISSUE	DATE	DESCRIPTION	BY
1	10-16-06	FOR APPROVAL	RM

AL. APPROACH RAIL AT SAFETY CURB

FOR: NORTHLAND SPECIALTIES, INC.

DR: 10-13-06
CHK: 10-16-06
JOB NO. A8100013-1001
DWG. NO. BR-2907
SHEET 1 OF 2

070

168704 8-93
MAKEPEACE