STATE OF VERMONT
AGENCY OF TRANSPORTATION

TRAFFIC SIGN SUMMARY SHEET

MILEMARKER, STATION, OR SIGN NUMBER	SIGN LEGEND	SIGN DIMENSIONS EA	WIDTH (In)	HEIGHT (In)	NEW & SALVAGED SIGNS "A"	"B"	SALV SIGN	SALV TIS	EXIST POST RETAIN	EXIST POST SALVAGE	NEW SIGN POSTS NO. OF POSTS	FLANGED CHANNEL lb/ft 1.12	2.0	3.0	SQUARE STEEL (In) lb/ft 1.75 1.88	2.0 2.16	2.5 3.35	ANCHOR	SLEEVE	TUBULAR ALUMINUM Ø (In) lb/ft 3.0 1.3	4.0 1.7	4.0 MOD 1.7	TUBULAR STEEL Ø (in) FOUND-ATION	lb/ft 3.0 7.6	3.5 9.0	4.0 10.8	5.0 14.6	W-SHAPE STEEL FTG. SIZE 24"	30"	WEIGHT	POST SIZE	SIGN REMOVED	REMARKS	SIGN DETAIL DETAIL ON SHEET NUMBER	STD. SHEET NUMBER
												OPTION ITEMS																									
STATION 43+16, LT RAMP "C"		1	24	36	6						1			X		X		1															INSTALL NEW SIGN ON NEW POST		STD. E-140
STATION 43+16, LT RAMP "C"		1	24	30	5																												SUB-MOUNT NEW SIGN WITH PREVIOUS SIGN		STD. E-140
STATION 44+00, LT RAMP "C"		1	36	24	6						1			X		X		1															INSTALL NEW SIGN ON NEW POST		STD E-143
STATION 44+00, RT RAMP "C"		1	36	24	6						1			X		X		1															INSTALL NEW SIGN ON NEW POST		STD E-143
STATION 44+00, RT RAMP "C"		1	24	24	4																												INSTALL NEW SIGN ON NEW POST, (SUB-MOUNT W/ PREVIOUS SIGN)		STD E-143
STATION 52+00 RAMP "C" OVERHEAD		1	162	102		114.75																											INSTALL NEW SIGN ON NEW OVERHEAD SIGN SUPPORT, CENTER ARROW OVER LANE, HOSPITAL TO BE BLUE BACKGROUND WITH WHITE LETTERING		
STATION 52+00 RAMP "C" OVERHEAD		1	120	84		70																											INSTALL NEW SIGN ON NEW OVERHEAD SIGN SUPPORT, CENTER ARROW OVER LANE		
STATION 52+25, RT RAMP "C"		1	36	36	9						2			X		X		2															INSTALL NEW SIGN ON NEW POST		STD. E-152
STATION 52+25, LT RAMP "C"		1	36	36	9						2			X		X		2															INSTALL NEW SIGN ON NEW POST		STD. E-152
STATION 56+64, RT RAMP "C"		1	84	56		32.67					2					X		2	2															INSTALL NEW SIGN ON NEW POSTS, USE ANCHORS		
STATION 56+75 RT RAMP "C"		1	18	18	2.25						1			X		X		1															INSTALL NEW SIGN ON NEW POST		STD. E-150
STATION 56+90 RAMP "C" OVERHEAD	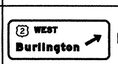	1	198	90		123.75																											INSTALL NEW SIGN ON NEW OVERHEAD SIGN SUPPORT, CENTER ARROW OVER EXIT LANE		
STATION 56+90 RAMP "C" OVERHEAD	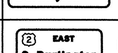	1	192	114		152																											INSTALL NEW SIGN ON NEW OVERHEAD SIGN SUPPORT, CENTER ARROW OVER LANE		
STATION 56+90 RAMP "C"		1	90	72		45																											INSTALL NEW SIGN ON NEW POST		
STATION 64+00, LT RAMP "C"		1	36	48	12						2			X		X		2															INSTALL NEW SIGN ON NEW POST		STD. E-150
												FT	FT	FT 119	FT	FT 124.5	FT		EA 2	LB	LB	LB		LB	LB	LB	LB								
	TOTALS				SF 59.25	SF 538.17	EA.	SF				LF 119			LF 124.5					LB			EA.	LB				EA.	EA.	LB					

FINAL POST LENGTHS ARE TO BE DETERMINED IN THE FIELD. POST SIZES ARE COMPUTED BASED ON INFORMATION FURNISHED ON THE STANDARD SHEETS AND THE TRAFFIC & SAFETY DIVISION'S "SIGN POST DESIGN GUIDELINE."

PROJECT NAME: SOUTH BURLINGTON
PROJECT NUMBER: IM 089-3(37)

FILE NAME: z03al78tss.dgn
PROJECT LEADER: KEN UPMAL
DESIGNED BY: V. KACOYANNAKIS
PLOT DATE: 5/5/2006
DRAWN BY: V. KACOYANNAKIS
CHECKED BY: J. FORD
SHEET 65 OF 99