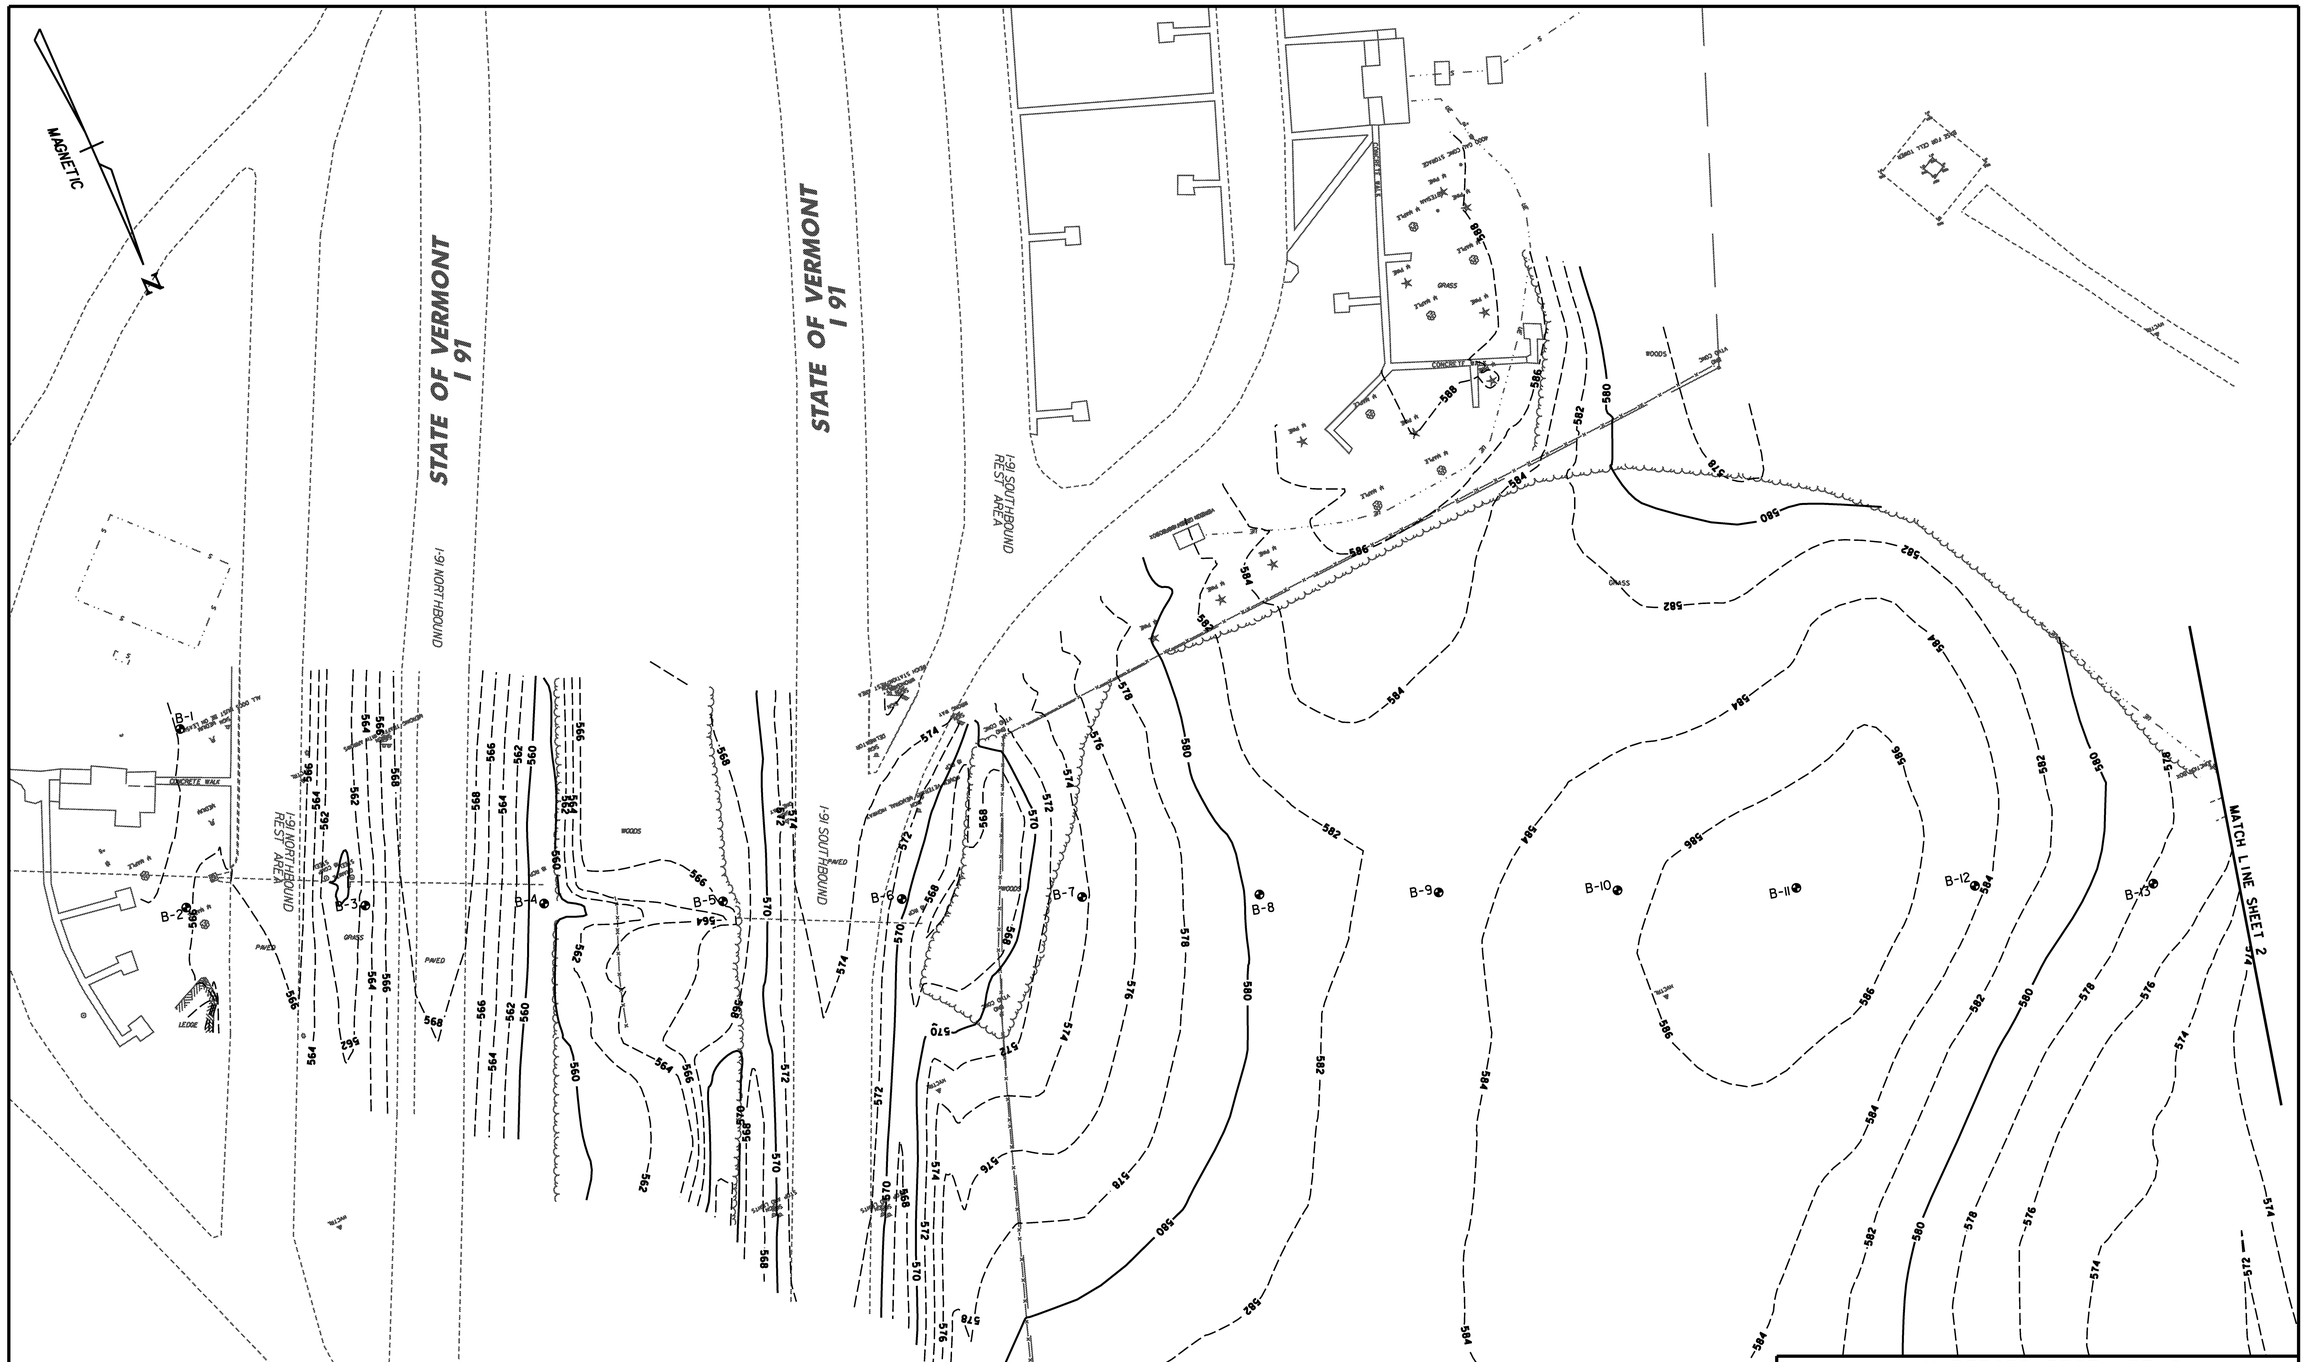

PROJECT NAME: HARTFORD REST AREAS
PROJECT NUMBER: IM BLDG(10)

FILE NAME: ...\u04a026plt-exist.dgn
PROJECT LEADER: JTM
DESIGNED BY:
EXISTING CONDITIONS SHEET 1

PLOT DATE: 5/19/2008
DRAWN BY: PZA
CHECKED BY: JTM
SHEET 8 OF 70