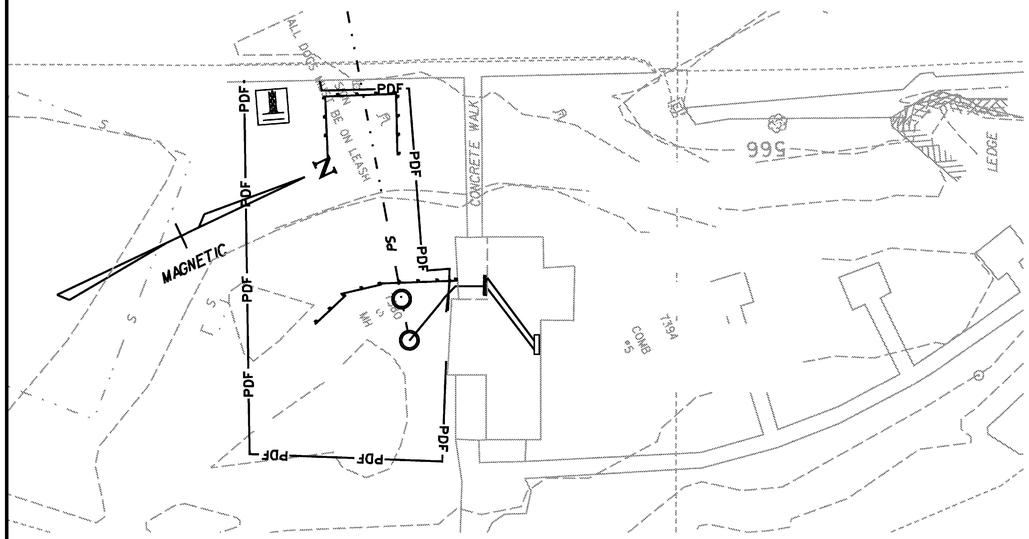

NORTH BOUND REST AREA SITE PLAN

SCALE: 1"=20'

REST AREA CLOSED

BUILDING REMOVED DURING PROJECT CONSTRUCTION

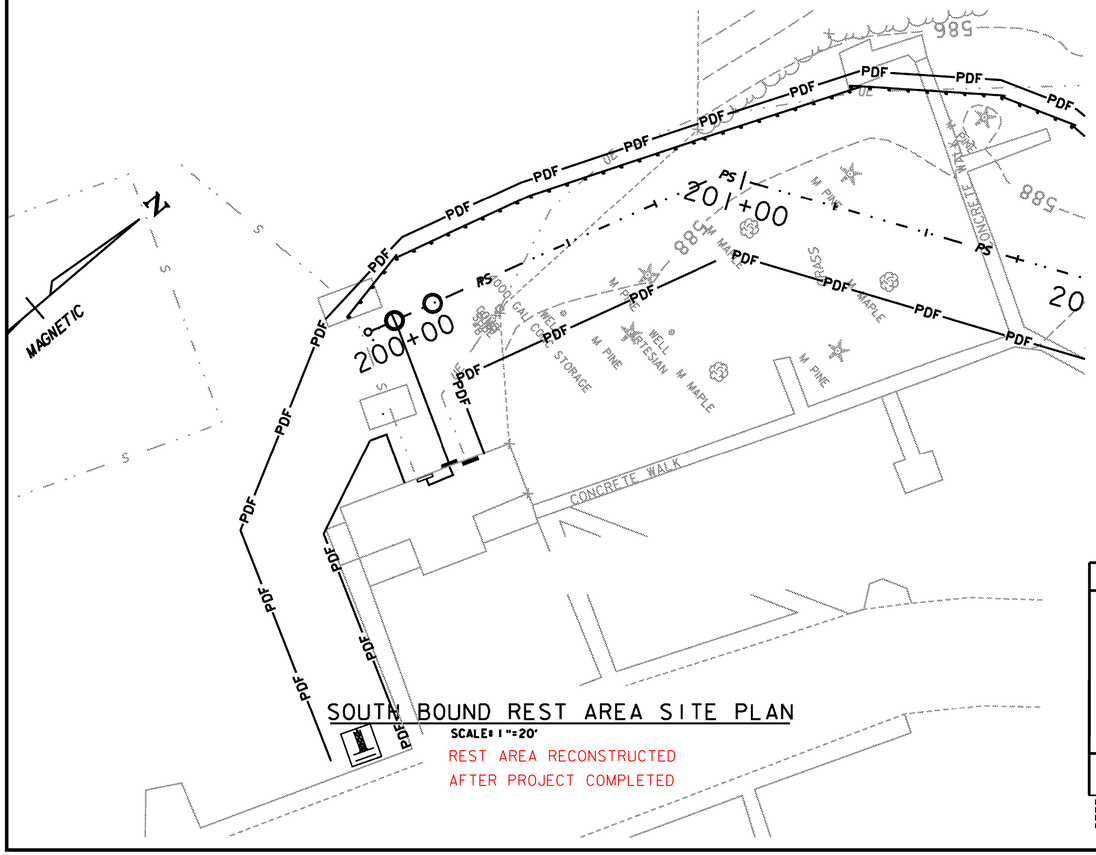

SOUTH BOUND REST AREA SITE PLAN

SCALE: 1"=20'

REST AREA RECONSTRUCTED

AFTER PROJECT COMPLETED

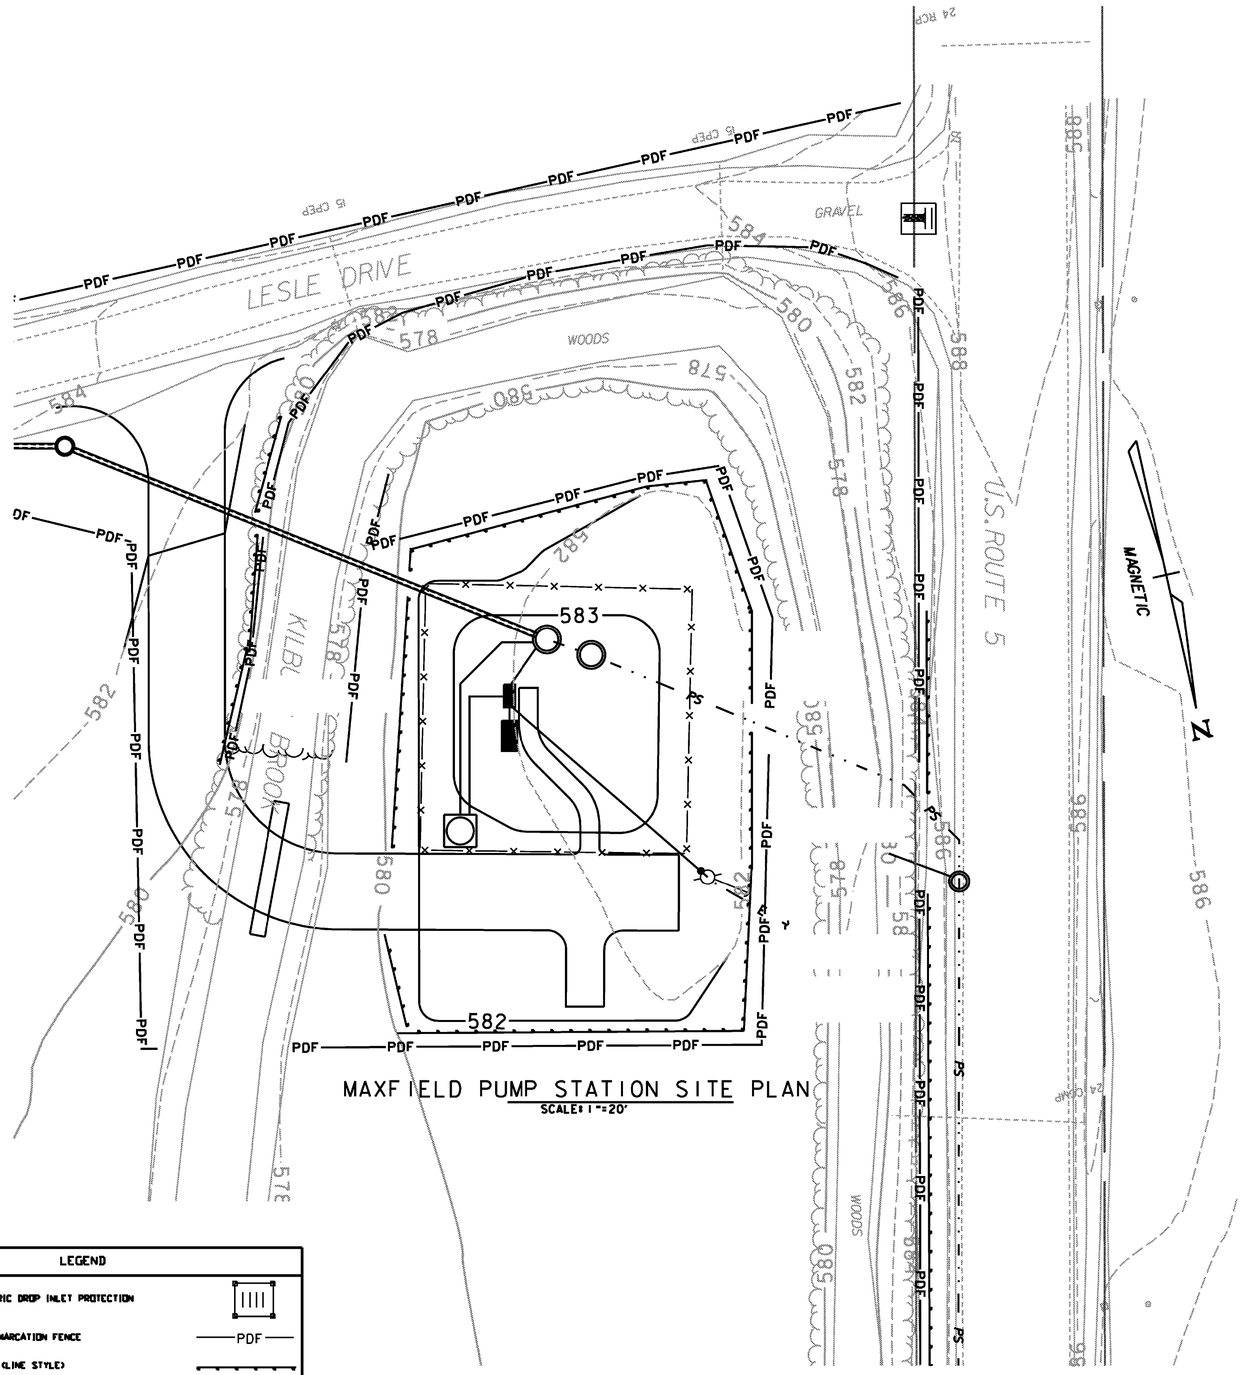

MAXFIELD PUMP STATION SITE PLAN

SCALE: 1"=20'

LEGEND	
FILTER FABRIC DROP INLET PROTECTION	
PROJECT DEMARCATION FENCE	PDF
SILT FENCE (LINE STYLE)	
STABILIZED CONSTRUCTION ENTRANCE	
ROCK DAM	
ADAPTED FROM DETAILS PROVIDED BY: NEW YORK STATE DEC ORIGINALLY DEVELOPED BY USDA-NRCS VERMONT DEPARTMENT OF ENVIRONMENTAL CONSERVATION	STANDARD SYMBOLS

NOTES:
REFER TO "THE VERMONT STANDARDS & SPECIFICATIONS FOR EROSION PREVENTION & SEDIMENT CONTROL -2006-" FROM THE VT AGENCY OF NATURAL RESOURCES FOR ADDITIONAL GUIDANCE.

0 20 40

SCALE

Stantec

PROJECT NAME:	HARTFORD REST AREAS
PROJECT NUMBER:	IM BLDG(10)
FILE NAME: ...\u04a026plt-ErosionControl_SP	PLOT DATE: 5/19/2008
PROJECT LEADER: JTM	DRAWN BY: PZA
DESIGNED BY: MEHP	CHECKED BY: JTM
EROSION CONTROL SHEET 12	SHEET 35 OF 70