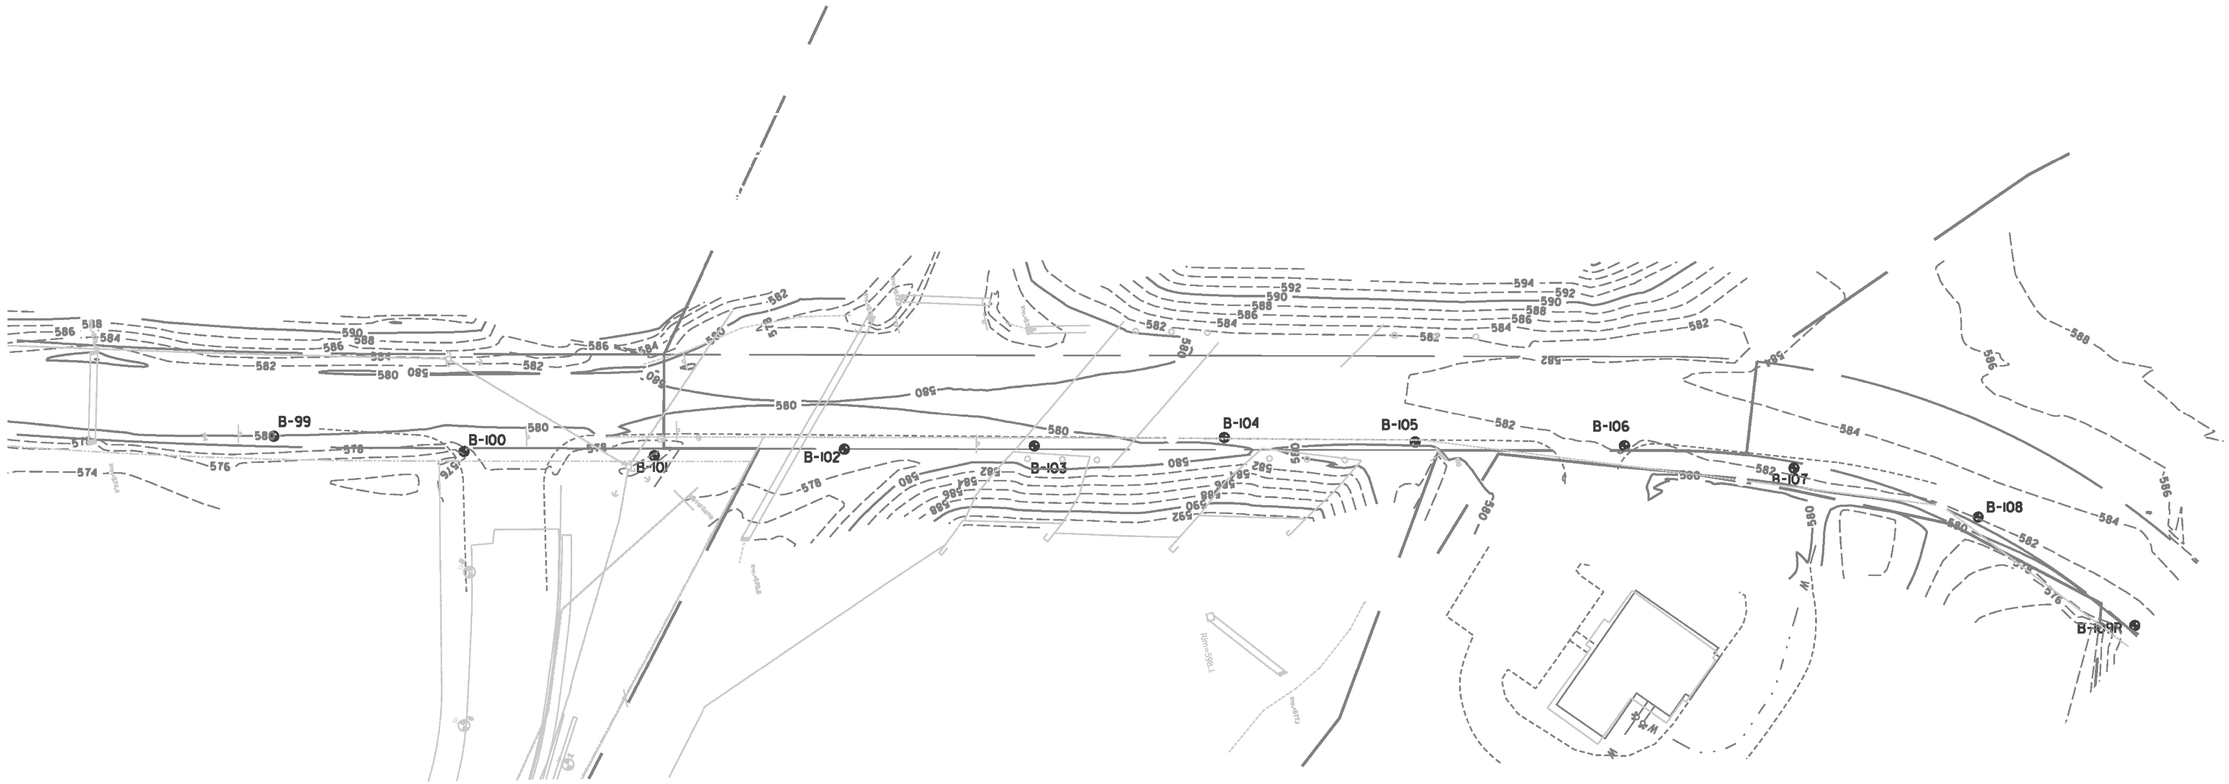

R