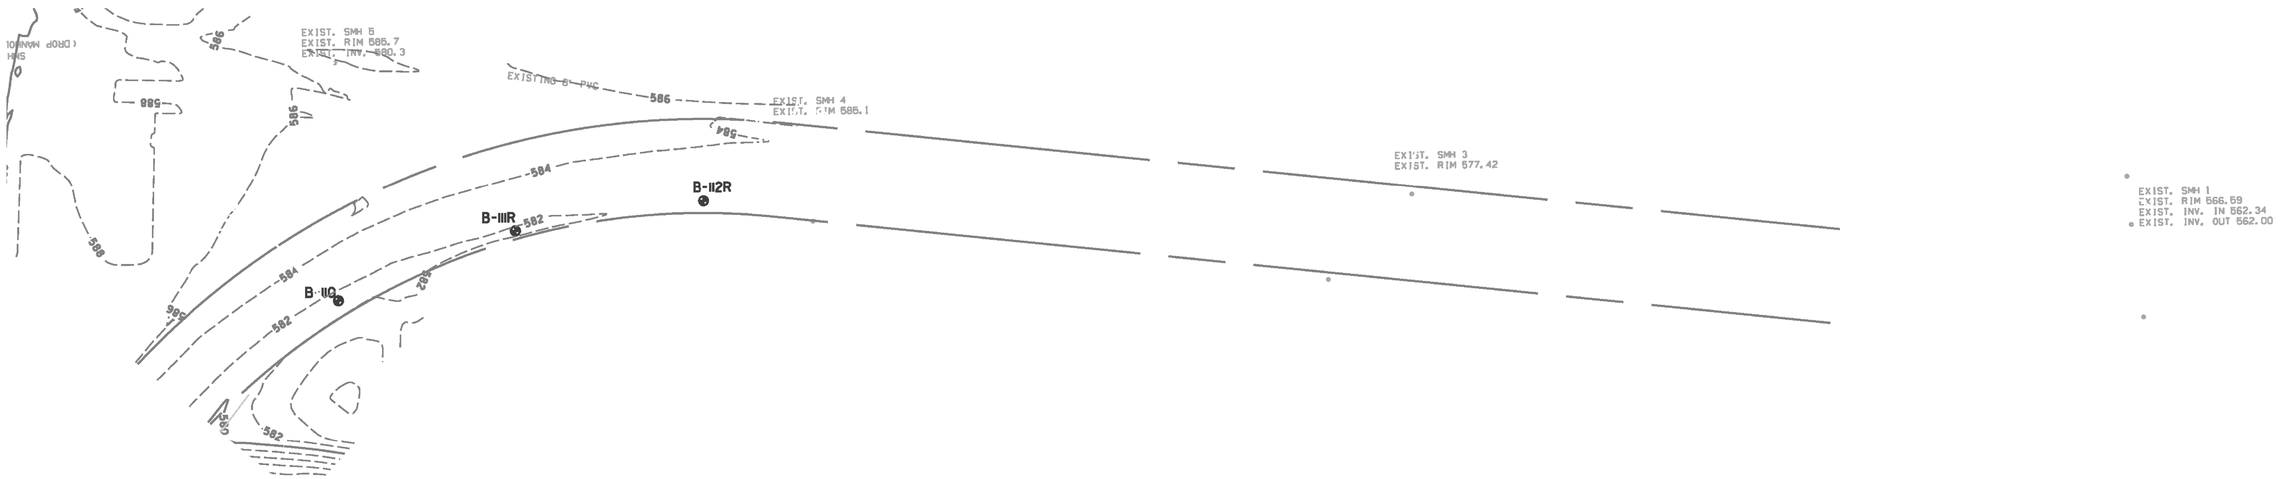
EXIST. SMH 5
EXIST. RIM 585.7
EXIST. INV. 580.3
EXISTING 8" PVC
586
EXIST. SMH 4
EXIST. RIM 585.1
584
EXIST. SMH 3
EXIST. RIM 577.42
B-112R
B-111R
582
B-110
EXIST. SMH 1
EXIST. RIM 666.69
EXIST. INV. IN 562.34
EXIST. INV. OUT 562.00
580

R