STATE OF VERMONT
AGENCY OF TRANSPORTATION

TRAFFIC SIGN SUMMARY SHEET

MILEMARKER, STATION, OR SIGN NUMBER	SIGN LEGEND	SIGN DIMENSIONS EA	WIDTH (in)	HEIGHT (in)	NEW & SALVAGED SIGNS "A"	"B"	SALV SIGN	SALV TIS	EXIST POST RETAIN	EXIST POST SALVAGE	NEW SIGN POSTS NO. OF POSTS	FLANGED CHANNEL lb/ft 1.12	FLANGED CHANNEL lb/ft 2.0	FLANGED CHANNEL lb/ft 3.0	SQUARE STEEL (in) 1.75 lb/ft 1.88	SQUARE STEEL (in) 2.0 lb/ft 2.16	SQUARE STEEL (in) 2.5 lb/ft 3.35	ANCHOR	SLEEVE	TUBULAR ALUMINUM Ø (in) 3.0 lb/ft 1.3	TUBULAR ALUMINUM Ø (in) 4.0 lb/ft 1.7	TUBULAR ALUMINUM Ø (in) 4.0 MOD lb/ft 1.7	TUBULAR STEEL Ø (in) FOUNDATION	TUBULAR STEEL Ø (in) 3.0 lb/ft 7.6	TUBULAR STEEL Ø (in) 3.5 lb/ft 9.0	TUBULAR STEEL Ø (in) 4.0 lb/ft 10.8	TUBULAR STEEL Ø (in) 5.0 lb/ft 14.6	W-SHAPE STEEL FTG. SIZE 24"	W-SHAPE STEEL FTG. SIZE 30"	W-SHAPE STEEL WEIGHT	W-SHAPE STEEL POST SIZE	SIGN FRAME REQUIRED	REMARKS	SIGN DETAIL DETAIL ON SHEET NUMBER	SIGN DETAIL STD. SHEET NUMBER
														OPTION ITEMS																							
SOUTHBOUND U-TURNS		10	36	36	90.00						20			X		X		X																R3-4		E-143
STA. 4+90.91 RT EXIT 17 RAMP B		1	36	36	9.00						2			X		X		X																W3-3		E-101
STA. 6+38.20 RT,LT EXIT 17 RAMP B		2	36	24	12.00						4			X		X		X																R5-1A		E-143
STA. 3+20.88 RT EXIT 17 RAMP F		1	36	36	9.00						2			X		X		X																W3-2A		E-150
STA. 7+00.00 RT EXIT 17 RAMP F		1	36	36	4.50						2			X		X		X																R1-2		E-146
STA. 7+67.82 RT EXIT 18 RAMP C		1	36	36	9.00						2			X		X		X																W3-1A		E-150
STA. 10+32.03 RT,LT EXIT 18 RAMP C		2	36	24	12.00						4			X		X		X																R5-1A		E-143
STA. 12+61.68 RT,LT EXIT 18 RAMP C	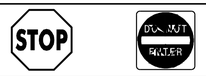	2 2	30 30	30 30	12.50 12.50						2			X		X		X																R1-1 BACK TO BACK R5-1		E-143 E-143
STA. 12+61.68 RT,LT EXIT 18 RAMP C		2 2	36 36	12 12	6.00 6.00																												R6-1L BACK TO BACK R6-1R		E-142 E-142

FINAL POST LENGTHS ARE TO BE DETERMINED IN THE FIELD. POST SIZES ARE COMPUTED BASED ON INFORMATION FURNISHED ON THE STANDARD SHEETS AND THE TRAFFIC & SAFETY DIVISION'S "SIGN POST DESIGN GUIDELINE."

	SF	SF	EA.	SF		FT	FT	FT	FT	FT	FT		EA	LB	LB	LB		LB	LB	LB	LB		EA.	EA.	LB
								570.00			570.00														
TOTALS	182.50					570.00			570.00					LB			EA.	LB				EA.	EA.	LB

PROJECT NAME: COLCHESTER - GEORGIA
PROJECT NUMBER: IM 089-3(59)

FILE NAME: p04a030.DGN
PROJECT LEADER: EPD
DESIGNED BY: JDA
PLOT FILE:

PLOT DATE: 12-OCT-2010 16:39
DRAWN BY: RHB/SJB
CHECKED BY: EPD
SHEET 12 OF 22