Decel. lane taper begins at 113.17 ±
620′ from Gore
Use 7 Type II Delineators

Accel. lane taper ends at 113.63 ±
700′ from Gore
Use 8 Type II Delineators

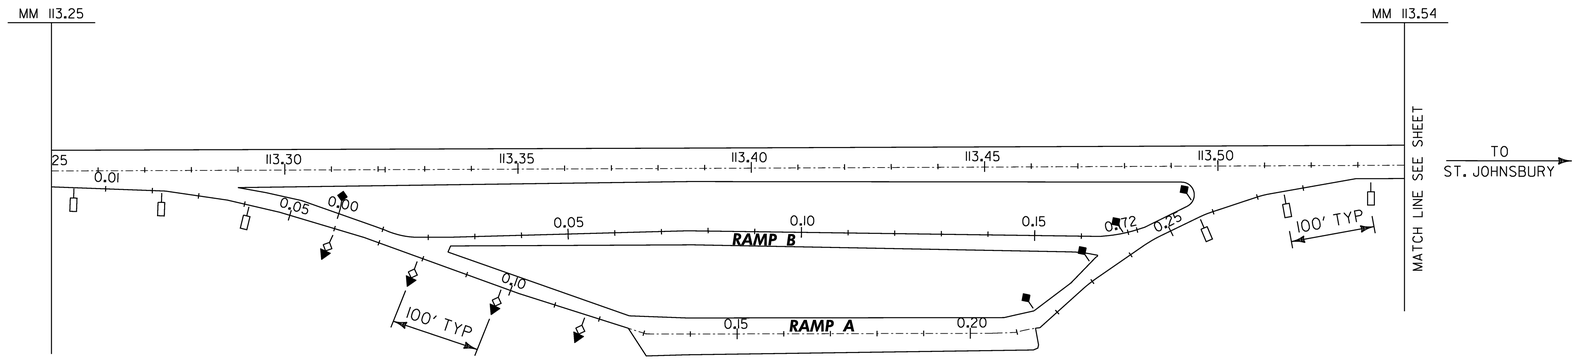

LEGEND

- ***TYPE I (WHITE)***
- ***TYPE I (YELLOW)***
- ***TYPE II (WHITE)***
- ***TYPE III (RED ON BACK, WHITE)***
- ***TYPE III (RED ON BACK, YELLOW)***

PARKING AREA 113.39 I–91 NB DELINEATOR LAYOUT

PROJECT NAME: RYEGATE-ST. JOHNSBURY
PROJECT NUMBER: IM 091-2(73)

FILE NAME: 97194s-ra.dgn
PROJECT LEADER: CRB
DESIGNED BY: DAM
CLD REF. NO.: 97-0194
PLOT DATE: 12/13/2006
DRAWN BY: JCS
CHECKED BY: DAM
SHEET 32 OF 88