STATE OF VERMONT
AGENCY OF TRANSPORTATION

TRAFFIC SIGN SUMMARY SHEET 16

Metric

MILE MARKER	SIGN LEGEND	SIGN DIMENSIONS EA	WIDTH (mm)	HEIGHT (mm)	NEW & SALVAGED SIGNS "A"	"B"	SALV SIGN	SALV TIS	EXIST POST RETAIN	SALVAGE	NEW SIGN POSTS NO. OF POSTS	FLANGED CHANNEL kg/m 1.7	3.0	4.5	SQUARE STEEL (mm) kg/m 44 3.4	50 3.9	63 5.0	ANCHOR	SLEEVE	TUBULAR ALUMINUM DIA (mm) kg/m 75 1.9	100 2.5	100MD 2.5	TUBULAR STEEL DIA (mm) kg/m FND-ATION	75 11.3	90 13.6	100 16.1	125 21.8	W-SHAPE STEEL FTG. SIZE 600 mm	750 mm	MASS	POST SIZE	SIGN FRAME	REMARKS	SIGN DETAIL DETAIL ON SHEET NUMBER	STD. SHEET NUMBER
PARK AREA 113.39 NB 0.100 RAMP B RT		1	600	900	0.54																													VR-278		E-144
		1	600	600	0.36						1			4.88 X		~~X~~		~~X~~																VR-648		E-144
0.135 RAMP B RT		1	900	300	0.27						2			8.54 X		~~X~~		~~X~~																R6-1L		E-142
0.155 RAMP B RT		1			0.35																													R1-2 900X900X900		E-146
		1	600	600	0.36						1			4.88 X		~~X~~		~~X~~																R3-1		E-143
0.160 RAMP B LT		1	750	750	0.56						1			4.27 X		~~X~~		~~X~~																R5-1		E-143
0.160 RAMP B RT		1	750	750	0.56						1			4.88 X		~~X~~		~~X~~																R5-1		E-143
0.0							1																											27.45		
PARK AREA 115.40 SB 0.068 RAMP A LT	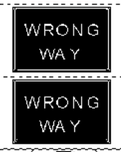	1	900	600	0.54						2			8.54 X		X		X																R5-1a		E-143
0.068 RAMP A RT		1	900	600	0.54						2			8.54 X		~~X~~		~~X~~																R5-1a		E-143
0.078 RAMP A LT		1	750	750	0.56						1			4.27 X		~~X~~		~~X~~																R5-1		E-143
0.078 RAMP A RT		1	750	750	0.56						1			4.27 X		~~X~~		~~X~~																R5-1		E-143
0.100 RAMP A LT		1	600	600	0.36																													VD-10R	77	
		1	600	750	0.45						1			4.88 X		~~X~~		~~X~~																VD-239R	77	
0.130 RAMP A RT		1	750	600	0.45						1			4.27 X		~~X~~		~~X~~																VR-032		E-144
0.180 RAMP A RT		1	600	900	0.54																													VR-278		E-144
		1	600	600	0.36						1			4.88 X		~~X~~		~~X~~																VR-648		E-144
												m 0.0	m 0.0	m ~~60.6~~ 67.1	m 0.0	m 60.6	m 0.0		EA. 0	kg 0.0	kg 0.0	kg 0.0		kg 0.0	kg 0.0	kg 0.0	kg 0.0								
							1					67.1																								
		SHEET TOTALS			m2 7.36	m2 0.00	EA. ~~0~~	m2 0.00						m ~~60.6~~			m ~~60.6~~				kg 0.0		EA. 0		kg 0.0		EA. 0	EA. 0	kg 0					

FINAL POST LENGTHS ARE TO BE DETERMINED IN THE FIELD. POST SIZES ARE COMPUTED BASED ON INFORMATION FURNISHED ON THE STANDARD SHEETS AND THE TRAFFIC & SAFETY DIVISION'S "SIGN POST DESIGN GUIDELINE".

PROJECT NAME: RYEGATE-ST. JOHNSBURY
PROJECT NUMBER: IM 091-2(73)

FILE NAME	fsssRyegate.xls	PLOT DATE	12/12/06
PROJECT LEADER:	CRB	DRAWN BY:	JCS
DESIGNED BY:	PTS	CHECKED BY:	DAM
CLD REF. NO.:	97-0194	SHEET 54	OF 88