STATE OF VERMONT
AGENCY OF TRANSPORTATION

TRAFFIC SIGN SUMMARY SHEET 33

Metric

MILE MARKER	SIGN LEGEND	SIGN DIMENSIONS EA	WIDTH (mm)	HEIGHT (mm)	NEW & SALVAGED SIGNS "A"	"B"	SALV SIGN	SALV TIS	EXIST POST RETAIN	SALVAGE	NEW SIGN POSTS NO. OF POSTS	FLANGED CHANNEL kg/m 1.7	3.0	4.5	SQUARE STEEL (mm) kg/m 44 3.4	50 3.9	63 5.0	ANCHOR	SLEEVE	TUBULAR ALUMINUM DIA (mm) kg/m 75 1.9	100 2.5	100MD 2.5	TUBULAR STEEL DIA (mm) kg/m FND-ATION	75 11.3	90 13.6	100 16.1	125 21.8	W-SHAPE STEEL FTG. SIZE 600 mm	750 mm	MASS	POST SIZE	SIGN FRAME	REMARKS	SIGN DETAIL DETAIL ON SHEET NUMBER	STD. SHEET NUMBER
1.579 RTE 5 LT		1	600	300	0.18																												M3-3		E-136A
		1	600	300	0.18																												M3-1		E-136A
		1	600	300	0.18																												M4-5		E-136A
		1	600	600	0.36																												M1-4		E-136A
		1	600	600	0.36																												M1-4		E-136A
		1	750	600	0.45																												M1-4		E-136A
		1	525	375	0.20																												M6-1		E-136A
		1	525	375	0.20						2												2	77.49 X							#3	M6-1		E-136A
		1	525	375	0.20																												M6-1		E-136A
1.580 RTE 5 LT		1	600	300	0.18																												M3-3		E-136A
		1	600	300	0.18																												M3-3		E-135
		1	600	300	0.18																												M3-1		E-135
		1	600	600	0.36																												M1-4		E-136A
		1	600	600	0.36																												M1-1		E-135
		1	600	600	0.36																												M1-1		E-135
		1	525	375	0.20																												M6-3		E-136A
		1	525	375	0.20						2												2	80.08 X							#3	M6-3		E-136A
		1	525	375	0.20																												M6-1		E-135
1.580 RTE 5 RT		1	600	300	0.18																												M3-1		E-136A
		1	600	600	0.36						1			4.27 X		X		X															M1-4		E-136A
1.600 RTE 5 RT		1	750	750	0.56						1			4.27 X		X		X															VR-921		E-145A
1.605 RTE 5 LT		1	1800	300	0.54																												D1-1a		E-123
	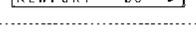	1	1800	300	0.54						2			8.54 X		X		X															D1-1a		E-123
1.640 RTE 5 RT		1	1800	300	0.54																												D2-1		E-123
		1	1800	300	0.54						2			8.54 X		X		X															D2-1		E-123
1.650 RTE 5 LT		1	525	375	0.20																												M2-1		E-135
		1	600	600	0.36						1			4.27 X		X		X															M1-1		E-135
1.670 RTE 5 RT		1	750	750	0.56						1			4.27 X		X		X															VR-921		E-145A
		m 0.0	m 0.0	m ~~34.3~~ 34.16	m 0.0	m 0.0	m 34.3		EA. 0			kg 0.0	kg 0.0	kg 0.0		kg ~~165.0~~ 157.57	kg 0.0	kg 0.0	kg 0.0															
		34.16				0																													
	SHEET TOTALS	m2 8.91	m2 0.00	EA. 0	m2 ~~0.00~~		m ~~34.3~~					m ~~34.3~~						kg 0.0		EA. 4	157.57	kg ~~165.0~~			EA. 0	EA. 0	kg 0							

FINAL POST LENGTHS ARE TO BE DETERMINED IN THE FIELD. POST SIZES ARE COMPUTED BASED ON INFORMATION FURNISHED ON THE STANDARD SHEETS AND THE TRAFFIC & SAFETY DIVISION'S "SIGN POST DESIGN GUIDELINE".

PROJECT NAME: ST. JOHNSBURY-LYNDON
PROJECT NUMBER: HES 091-3(42)

FILE NAME:	tsssSIJ.xls	PLOT DATE:	1/4/2007
PROJECT LEADER:	CRB	DRAWN BY:	HJC
DESIGNED BY:	PTS	CHECKED BY:	DAM
CLD REF. NO.:	97-0211	SHEET	61 OF 130