INDEX OF SHEETS

1. TITLE SHEET
2. TYPICAL SECTION - PAVER PLACED SURFACE TREATMENT
3. QUANTITY SHEET
4. INTERCHANGE DETAIL SHEET
5.- 6. CONSTRUCTION APPROACH SIGNING SHEETS
7. ROUGHNESS DATA INFORMATION SHEET
8. RUTTING DATA INFORMATION SHEET

STANDARDS

E-100	CONSTRUCTION APPROACH SIGNS	01/02/04
E-101	CONSTRUCTION SIGN DETAILS	05/30/03
E-102	CONSTRUCTION SIGN DETAILS	06/30/03
E-102A	CONSTRUCTION SIGN DETAILS	05/01/04
E-103	MAINLINE TRAFFIC CONTROL DIVIDED HIGHWAY ONE LANE CLOSED	03/01/04
E-105	TRAFFIC CONTROL FOR CONSTRUCTION VEHICLE U-TURNS ON DIVIDED HIGHWAY	05/01/04
E-106	TRAFFIC CONTROL - MISCELLANEOUS DETAILS	03/01/04
E-107A	BREAKAWAY BARRICADE DETAILS	08/08/95
E-191	PAVEMENT MARKING DETAILS	02 / 01/ 99
E-192	PAVEMENT MARKING DETAILS	10 / 12/ 00

STATE OF VERMONT
AGENCY OF TRANSPORTATION

PROPOSED IMPROVEMENT
TOWNS OF BROOKFIELD & WILLIAMSTOWN
COUNTY OF ORANGE
INTERSTATE ROUTE 89

BEGINNING AT MM 37.950 ON THE SOUTHBOUND LANES IN THE TOWN OF BROOKFIELD AND EXTENDING 6.003 MILES NORTH TO MM 43.953 IN THE TOWN OF WILLIAMSTOWN

LENGTH OF PROJECT 6.003 MILES
LENGTH OF ROADWAY 6.003 MILES

WORK TO BE PERFORMED UNDER THIS PROJECT INCLUDES THE CONSTRUCTION OF A PREVENTATIVE MAINTENANCE TREATMENT SITE ON THE EXISTING INTERSTATE TYPICAL.

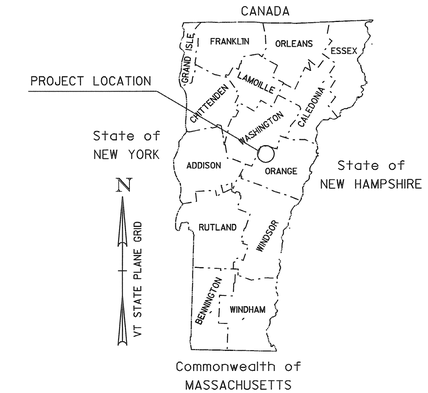

RECORD PLANS

CONTRACTOR: PIKE INDUSTRIES, INC. – BERLIN, VT
RESIDENT ENGINEER: PAUL PERRY IV
CONSTRUCTION BEGAN: SEPTEMBER 19, 2007
CONSTRUCTION COMPLETE: OCTOBER 22, 2007
RECORD PLANS BY: PAUL PERRY IV

I HEREBY CERTIFY THAT ALL THE CONSTUCTION REQUIRED BY THIS SET OF DRAWINGS HAS BEEN ACCOMPLISHED AS INDICATED HEREIN.

BY Paul K. Perry RESIDENT ENGINEER
DATE 5-5-10

NOTE: Any further information concerning final quantities, amounts or other details relative to this project may be found at Central Files in the electronic archives.

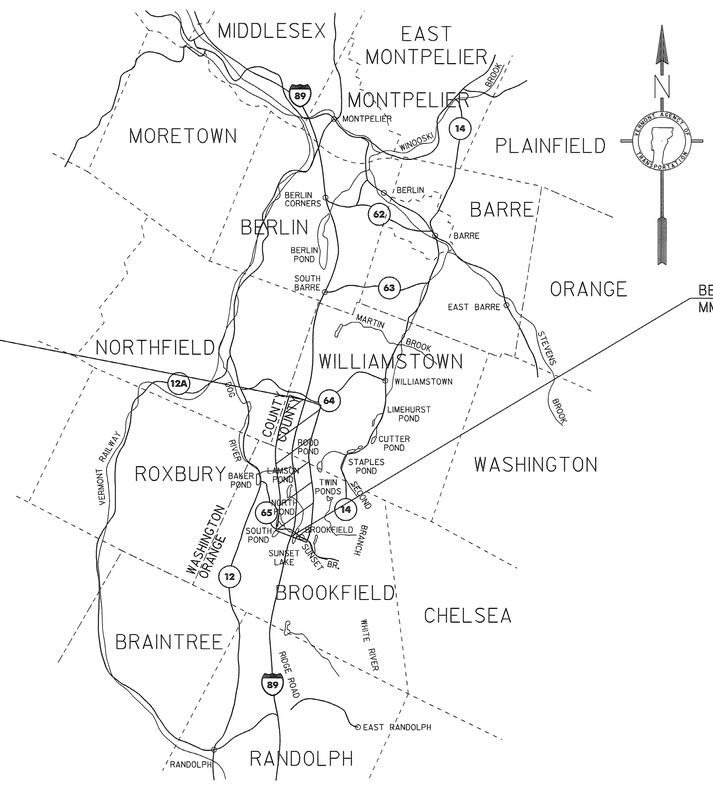

TRAFFIC DATA

AADT			DHV		ESALS	
2007	2017	2027	2007	2017	2007~2017	2007~2027
7400	8700	10,000	1100	1200	6,389,000	17,534,000

CONVENTIONAL SIGNS

COUNTY LINE
TOWN LINE
LIMITS OF ACCESS
POINT OF ACCESS
FENCE LINE
STONE WALL
TRAVELED WAY
GUARD RAIL
RAILROAD
SURVEY LINE
CULVERT
POWER POLE
TELEPHONE POLE
TREES
CONTROL OF ACCESS
PROPERTY LINE
R.O.W. TAKING LINE
SLOPE RIGHTS
TOP OF CUT
TOE OF SLOPE

DATUM
VERTICAL N/A
HORIZONTAL N/A

THESE PLANS ARE SUBJECT TO SUCH ENGINEERING CHANGES AS MAY BE REQUIRED BY THE FEDERAL HIGHWAY ADMINISTRATION OR THE DIRECTOR OF PROGRAM DEVELOPMENT.

CONSTRUCTION IS TO BE CARRIED ON IN ACCORDANCE WITH THESE PLANS AND THE STANDARD SPECIFICATIONS FOR CONSTRUCTION DATED 2006, AS APPROVED BY THE FEDERAL HIGHWAY ADMINISTRATION ON JANUARY 15, 2006 FOR USE ON THIS PROJECT, INCLUDING ALL SUBSEQUENT REVISIONS AND SUCH REVISED SPECIFICATIONS AND SPECIAL PROVISIONS AS ARE INCORPORATED IN THESE PLANS.

APPROVED Rich Fishman DATE 3/29/07
DIRECTOR OF PROGRAM DEVELOPMENT

DEPARTMENT OF TRANSPORTATION
FEDERAL HIGHWAY ADMINISTRATION

APPROVED for Mark D. Richter DATE 4-18-07
DIVISION ADMINISTRATOR

PROJECT BROOKFIELD-WILLIAMSTOWN IM SURF (3)

SHEET 1 OF 8 SHEETS