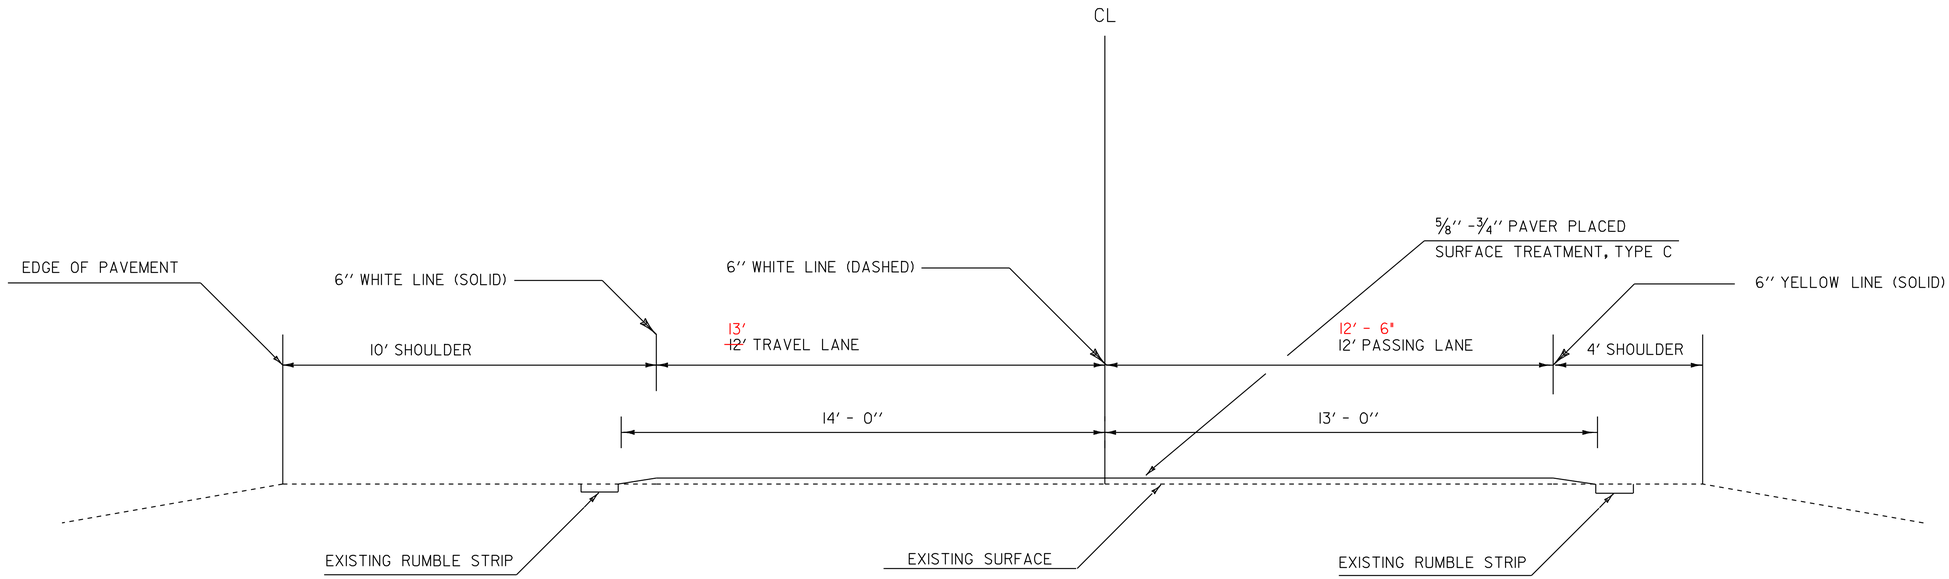

TYPICAL SECTION

I 89 SOUTHBOUND – MM 37.950 – 43.953

NOTES:

1. ALL NECESSARY SURFACE PREPARATION (POTHOLE REPAIR, RAVELING, CRACK SEALING) SHALL BE PERFORMED PRIOR TO CONSTRUCTING THE PAVER PLACED SURFACE TREATMENT. ESTIMATED QUANTITIES OF ITEMS 900.680 AND 417.10 HAVE BEEN INCLUDED TO COVER THIS PROVISION.
2. ALL EXISTING PAVEMENT MARKINGS SHALL BE REMOVED PRIOR TO APPLYING THE APPLICABLE TREATMENT. AN ESTIMATED QUANTITY OF 50 % REMOVAL OF EXISTING MARKINGS HAS BEEN INCLUDED TO COVER THIS PROVISION. PAVEMENT MARKINGS SHALL BE REMOVED PRIOR TO ANY CRACK FILLING BEING PERFORMED.
3. A 50' COLD PLANED WEDGE SHALL BE CONSTRUCTED AT THE PROJECT BEGIN, PROJECT END, INTERCHANGE RAMPS, AND AT ALL BEGIN/END BRIDGE APPROACHES WITHIN THE PROJECT LIMITS. THE LONGITUDINAL EDGES OF THE SURFACE TREATMENTS SHALL BE FEATHERED AS DIRECTED BY THE RESIDENT ENGINEER.

BRIDGES WITHIN THE PROJECT ARE:

BRIDGE NUMBER	34S	MM 38.844	(NO WORK REQUIRED)
BRIDGE NUMBER	35S	MM 42.952	(NO WORK REQUIRED)

N.T.S.

TYPICAL SECTION – PAVER PLACED SURFACE TREATMENT

PROJECT NAME: BROOKFIELD-WILLIAMSTOWN
PROJECT NUMBER: IM_SURF(3)

FILE NAME: p06g168.dgn
PROJECT LEADER: WOOLAVER
DESIGNED BY: LOCKE
p06g168typ.i

PLOT DATE: 28-MAY-2010 12:5
DRAWN BY: LOCKE
CHECKED BY: PAVT_MGMT
SHEET 2 OF 8