STATE OF VERMONT
AGENCY OF TRANSPORTATION

TRAFFIC SIGN SUMMARY SHEET #3

MILEMARKER, STATION, OR SIGN NUMBER	SIGN LEGEND	SIGN DIMENSIONS EA	WIDTH (in)	HEIGHT (in)	NEW & SALVAGED SIGNS "A"	"B"	SALV SIGN	SALV TIS	EXIST POST RETAIN	SALVAGE	NEW SIGN POSTS NO. OF POSTS	FLANGED CHANNEL lb/ft 1.12	2.0	3.0	SQUARE STEEL (in) lb/ft 1.75	2.0	2.5	ANCHOR	SLEEVE	TUBULAR ALUMINUM Ø (in) lb/ft 3.0	4.0	4.0 MOD	TUBULAR STEEL Ø (in) FOUND-ATION	lb/ft 3.0	3.5	4.0	5.0	W-SHAPE STEEL FTG. SIZE 24"	30"	WEIGHT	POST SIZE	SIGN FRAME REQUIRED	REMARKS	SIGN DETAIL DETAIL ON SHEET NUMBER	STD. SHEET NUMBER
												OPTION ITEMS																							
EXIT 8 RAMP C OFF RAMP 5+77 RT		1	36	36	9.00						2			X 2 @ 16' EA =32'		X																			E-150
EXIT 8 RAMP C OFF RAMP 5+77 LT		1	36	36	9.00						2			X 1@14' 1@16' 30'		X																			E-150
EXIT 8 RAMP C OFF RAMP 8+49 RT		1	36	24	6.00						2			X 2@14' EA =28'		X																			E-143
EXIT 8 RAMP C OFF RAMP 8+49 LT		1	36	24	6.00						2			X 2 @ 14' EA =28'		X																			E-143
EXIT 8 RAMP C OFF RAMP 9+50 LT	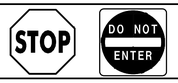	1 1	30 30	30 30	6.25 6.25						1			X 14'		X																		BACK TO BACK		E-143 E-143
		1 1	36 36	12 12	3.00 3.00																												BACK TO BACK		E-142 E-142
EXIT 8 RAMP C OFF RAMP 10+18 RT	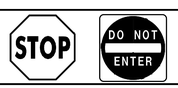	1 1	30 30	30 30	6.25 6.25						1			X 1@16'		X																		BACK TO BACK		E-143 E-143
		1 1	36 36	12 12	3.00 3.00																												BACK TO BACK		E-142 E-142
FINAL POST LENGTHS ARE TO BE DETERMINED IN THE FIELD. POST SIZES ARE COMPUTED BASED ON INFORMATION FURNISHED ON THE STANDARD SHEETS AND THE ROADWAY, TRAFFIC AND SAFETY SECTION'S "SIGN POST DESIGN GUIDELINE."												FT	FT	FT 150	FT	FT 150	FT		EA	LB	LB	LB		LB	LB	LB	LB							
SUBTOTALS SIGN SHEET 3		SF 67.00	SF	EA.	SF							FT 150			FT 150					LB			EA.	LB				EA.	EA.	LB				

PROJECT NAME: SPRINGFIELD - WINDSOR
PROJECT NUMBER: IM 091-1(55)

FILE NAME: 06A194.dgn
PROJECT LEADER: LFW
DESIGNED BY: LFW
PLOT FILE: 06A196tss3.i

PLOT DATE: 28-OCT-2011 14:01
DRAWN BY: LFW
CHECKED BY: LFW
SHEET 22 OF 36