STATE OF VERMONT
AGENCY OF TRANSPORTATION

TRAFFIC SIGN SUMMARY SHEET 3

MILEMARKER, STATION, OR SIGN NUMBER	SIGN LEGEND	SIGN DIMENSIONS EA	WIDTH (in)	HEIGHT (in)	NEW & SALVAGED SIGNS "A"	"B"	SALV SIGN	SALV TIS	EXIST POST RETAIN	EXIST POST SALVAGE	NEW SIGN POSTS NO. OF POSTS	FLANGED CHANNEL lb/ft 1.12	2.0	3.0	SQUARE STEEL (in) lb/ft 1.75 1.88	2.0 ~~2.16~~	2.5 3.35	ANCHOR	SLEEVE	TUBULAR ALUMINUM Ø (in) lb/ft 3.0 1.3	4.0 1.7	4.0 MOD 1.7	TUBULAR STEEL Ø (in) FOUNDATION	3.0 7.6	3.5 9.0	4.0 10.8	5.0 14.6	W-SHAPE STEEL FTG. SIZE 24"	30"	WEIGHT	POST SIZE	SIGN FRAME REQUIRED	REMARKS	SIGN DETAIL DETAIL ON SHEET NUMBER	STD. SHEET NUMBER
												OPTION ITEMS																									
STA. 14+75 RT EXIT 18 RAMP A		1	30	30	6.25						1					12 GA X 12		X																	R3-2		E-143
STA. 0+26 RT EXIT 18 RAMP B	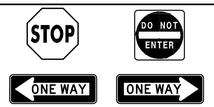	1 1 1 1	30 30 36 36	30 30 12 12	6.25 6.25 3.00 3.00						1					12 X		X																	RI-1 R5-1 MOUNT STOP AND DO NOT ENTER SIGNS BACK TO BACK R6-1R R6-1L MOUNT ONE WAY SIGNS BACK TO BACK.		E-143 E-138 E-142
STA. 3+09 RT EXIT 18 RAMP B		1	36	24	6.00						2					16 X		X																	R5-1A		E-143
STA. 3+09 LT RAMP B	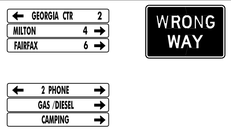	1	36	24	6.00		3 3				2					16 X		X																	R5-1A MOUNT GUIDE SIGNS AND WRONG WAY SIGN BACK TO BACK		E-143
STA. 4+99 LT EXIT 18 RAMP B	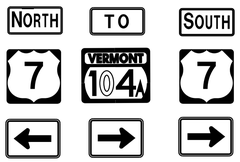	1 1 1 2 1 1 1	24 24 24 30 24 21 21 21	12 12 12 24 24 15 15 15	2.00 2.00 2.00 5.00 8.00 2.19 2.19 2.19						2					16 X 16		X																	M3-1 M4-5 M3-3 MI-4 MI-4 M6-1 M6-1 M6-1 SIGN FRAME REQUIRED FOR MOUNTING		E-136A E-136A E-136B E-136A
STA. 7+00 RT EXIT 18 RAMP B		1	18	18	2.25						1					10 X		X																	OMI-1		E-150
STA. 7+18 LT EXIT 18 RAMP B		1	36	36	9.00						2					14 X 14		X																	W3-1A		E-150
STA. 5612+85 RT		1	8	6	0.33						1					10 X		X																			
STA. 5621+87 RT		1	8	6	0.33						1					8 X		X																			
STA. 5634+11 RT		1 1	30 36	15 36	3.13 9.00						2					16 X 16		X																	M3-1 MI-1		E-135
STA. 5639+38 RT		1 1	48 24	48 18	16.00 3.00						2					16 X 16		X																	VW-397 VP-396		E-153B
	SHEET 15 TOTAL SHEET 16 TOTAL SHEET 17 TOTAL				~~124.38~~ 126.38 140.61 105.36		6									~~330~~ 290 ~~285~~ 232 ~~255~~ 208									1	228										
	SUBTOTAL ROUNDING				370.35 4.65							FT	FT	FT	FT	FT ~~870~~	FT 730		EA	LB	LB	LB		LB 228	LB	LB	LB								
	TOTALS				SF ~~375.00~~	SF 372.35	EA. 6	SF				FT			FT		~~870~~ 730			LB			EA. 1	LB 228				EA.	EA.	LB					

FINAL POST LENGTHS ARE TO BE DETERMINED IN THE FIELD. POST SIZES ARE COMPUTED BASED ON INFORMATION FURNISHED ON THE VTRANS STANDARD SHEETS AND "SIGN POST DESIGN GUIDELINE".

TRAFFIC SIGN SUMMARY SHEET 3

PROJECT NAME: COLCHESTER - GEORGIA
PROJECT NUMBER: IM 089-3(64)

FILE NAME: p06a196.dgn
PROJECT LEADER: CDL
DESIGNED BY: SJL
PLOT FILE: p06a196tss3.i

PLOT DATE: 04-OCT-2011 16:52
DRAWN BY: SJL
CHECKED BY: EPD
SHEET 18 OF 23