Drilling and Blasting of Solid Rock Subgrade Item 114
1621+00 - 1626+50

Property Line Fence, Item 583-B, Mod.
1617+00 - 1621+00 SB Lt.
1617+00 - 1633+00 NB Rt.
1621+00 - 1633+00 SB Lt.

Three Cable Guard Rail w/Steel Posts, Item 543
1617+00 to 1617 ~~+20~~ SB Lt.
1617+00 to 1621+72 ~~SB Rt.~~
1625 ~~+70~~ 98 to 1633+00 NB Rt.
1628+25 to 1633+00 SB Lt.
1632+04 to 1633+00 SB Rt.

SUBBASE OF SAND ITEM 202
1617+50 - 1620+86 LT

BITUMINOUS CONCRETE SURFACE FOR GUTTERS AND TRAFFIC ISLANDS, ITEM 534
1619+00 SB Lt.
1622+00 SB Lt.
1622+00 NB Lt.
1626+50 SB Lt.

Paved Median Gutter
1618+96 ~~+1619+00~~ - 1619+25
1628 ~~+50~~ - 1628+75
1629 ~~+50~~ - 1629+75
1632 ~~+50~~ - 1632+75

PARCEL: 507 A,B
GRANTOR: PEARL IRENE GOODRICH
STATIONS: 1615 + 46 — 1641 + 32 N.B.
TAKING: 21.1 A±
REMAINDER: 194.0 A±
RIGHTS:
CULVERT STA 1619+00±, 1622+00±, 1626+50±
1629+50±, 1630+51±, 1632+50±
1635+50±
TITLE TAKEN: COND, 12/28/60
RECORDED: RICHMOND HWY BK2 PG108-113 12/28/60
WILLISTON HWY BK1 PG21-48 12/28/60

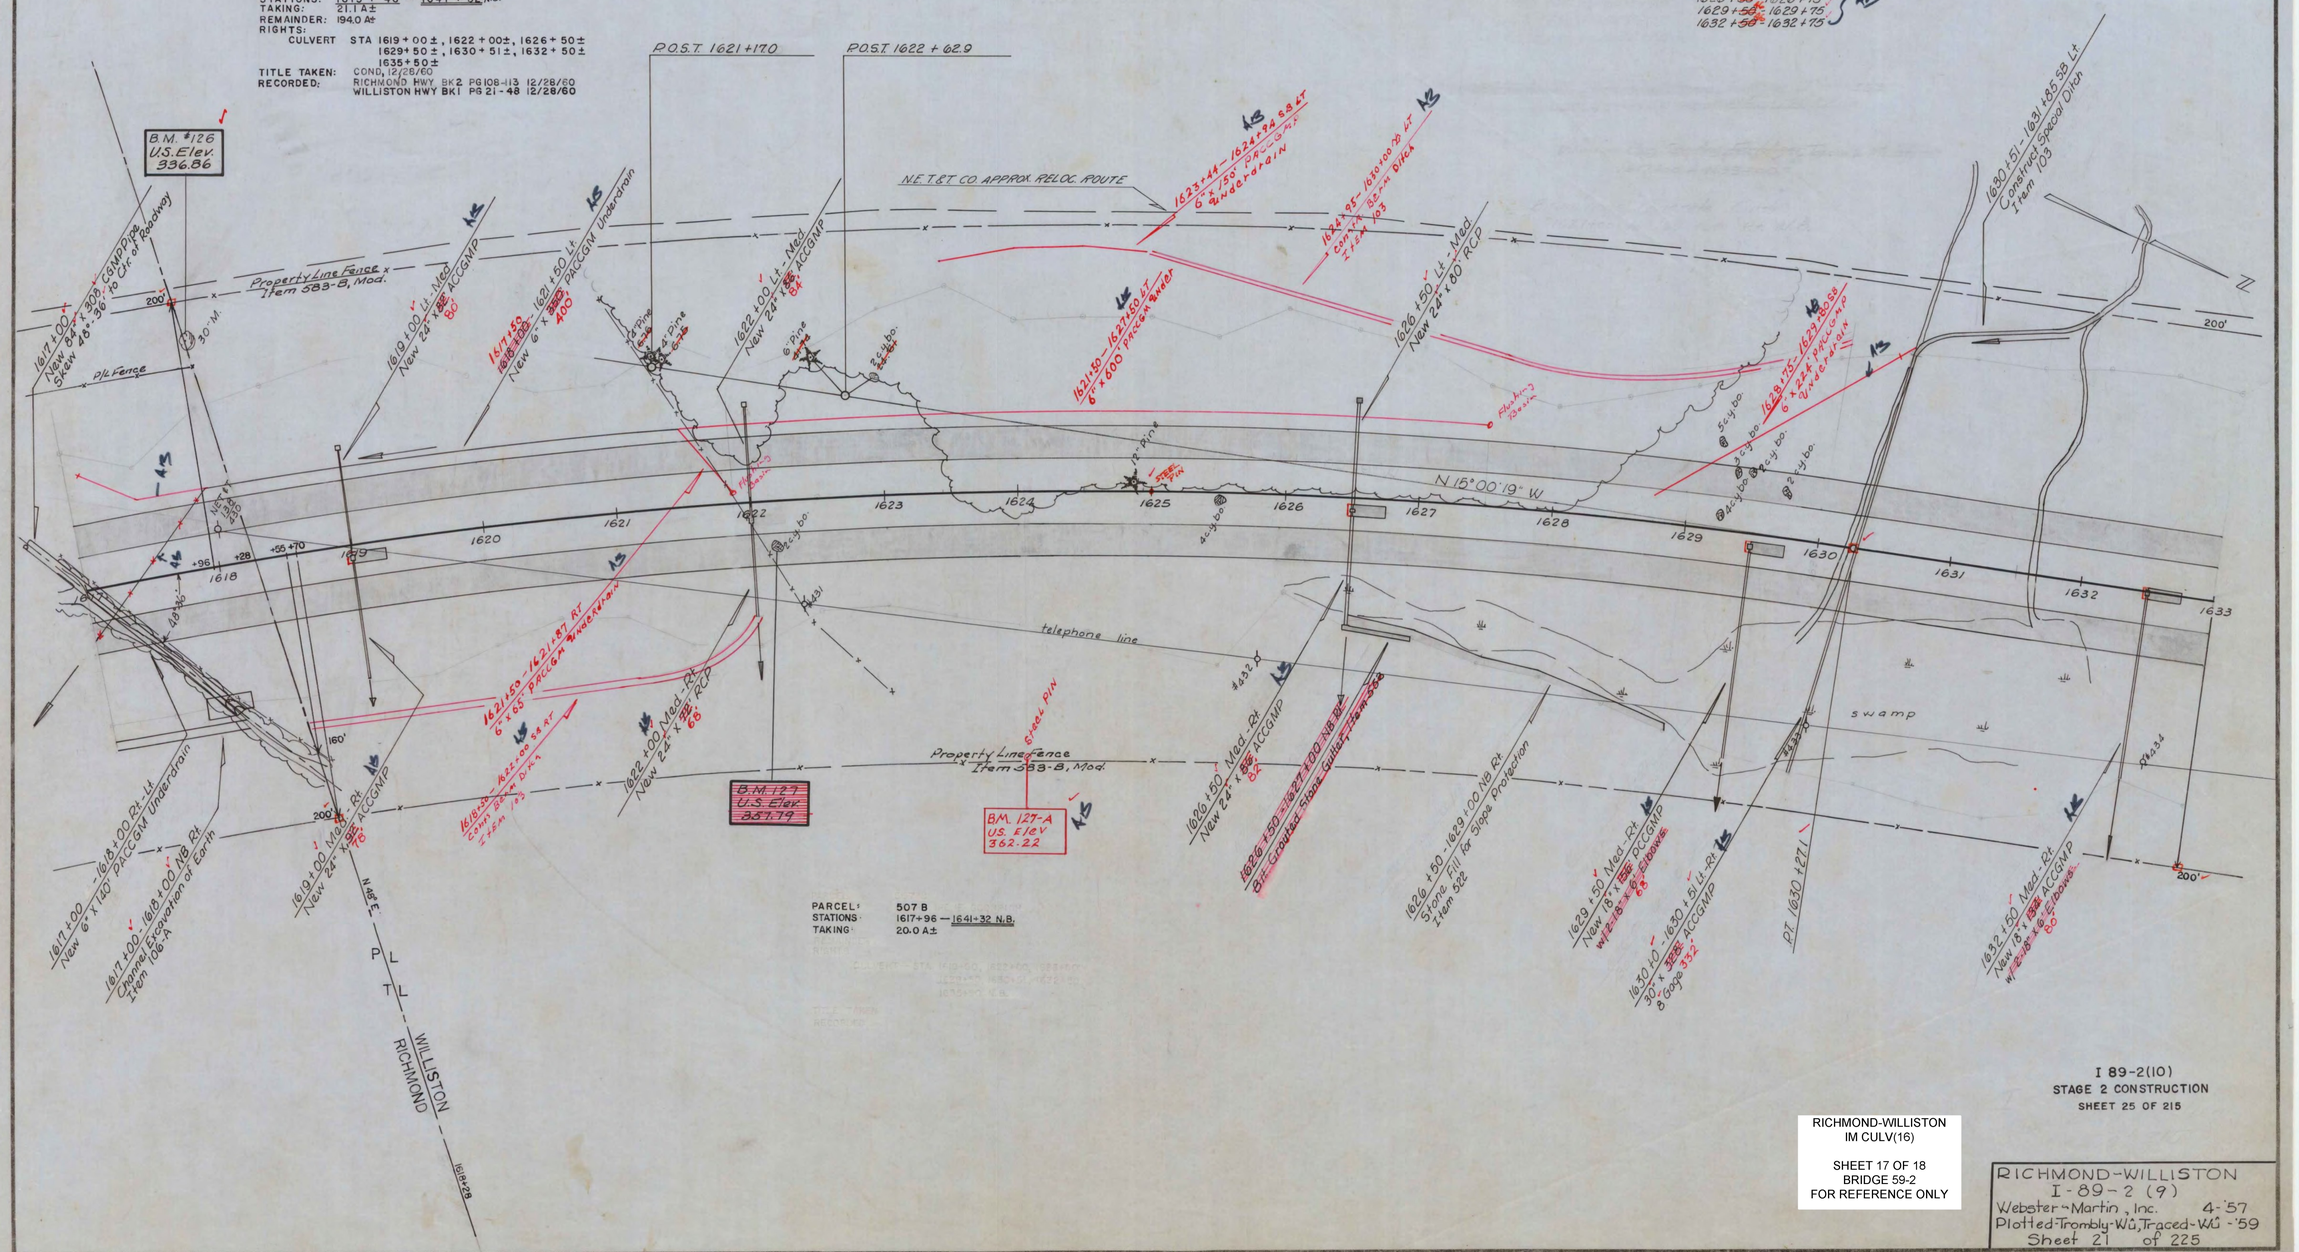

I 89-2(10)
STAGE 2 CONSTRUCTION
SHEET 25 OF 215

RICHMOND-WILLISTON
IM CULV(16)

SHEET 17 OF 18
BRIDGE 59-2
FOR REFERENCE ONLY

RICHMOND-WILLISTON
I-89-2 (9)
Webster-Martin, Inc. 4-'57
Plotted-Trombly-WÛ, Traced-WÛ -'59
Sheet 21 of 225

Contract II