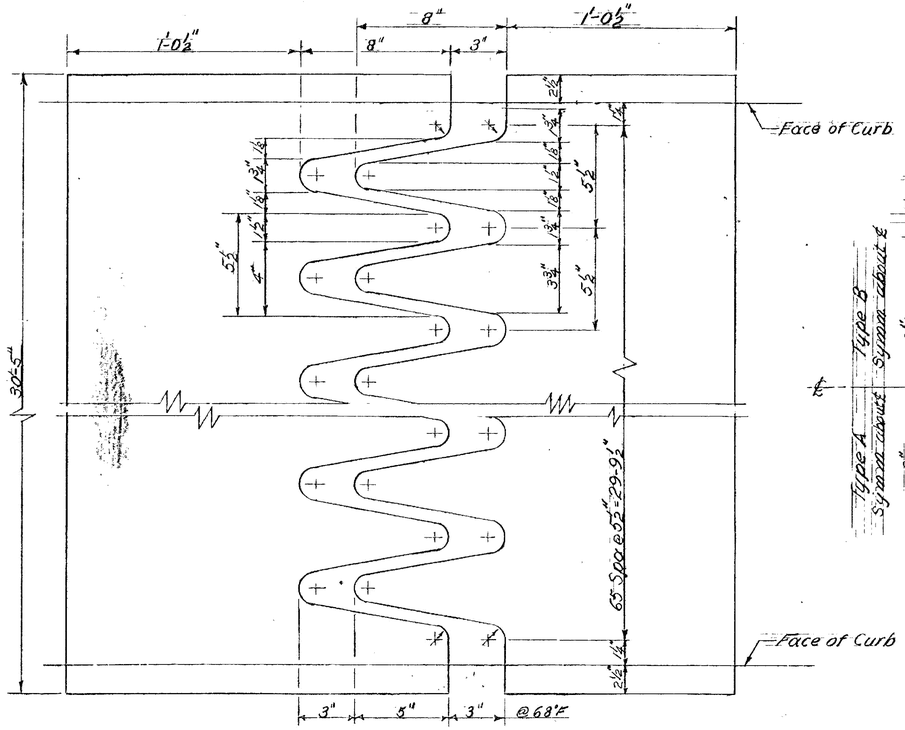

FINGER PLATE DETAIL

Scale: 3" = 1'-0

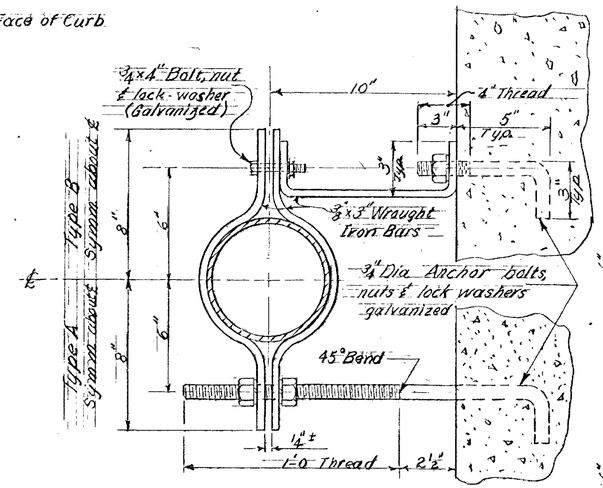

CLAMP DETAILS

SCALE: 3" = 1'-0

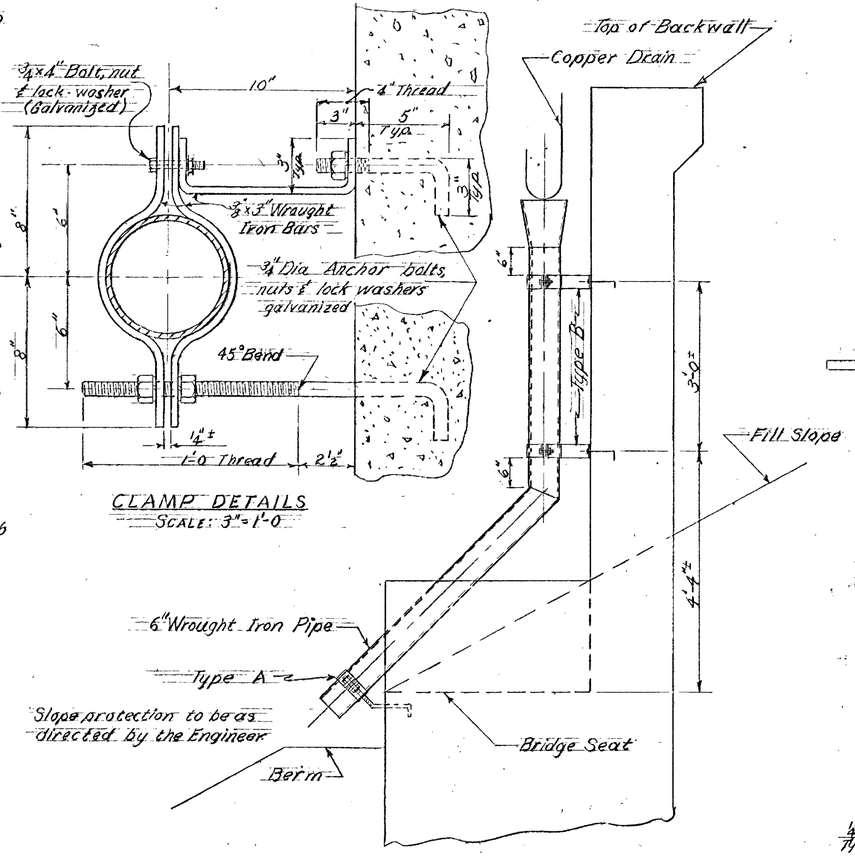

DRAINAGE AT EXP. DAMS

SCALE: ¼" = 1'-0

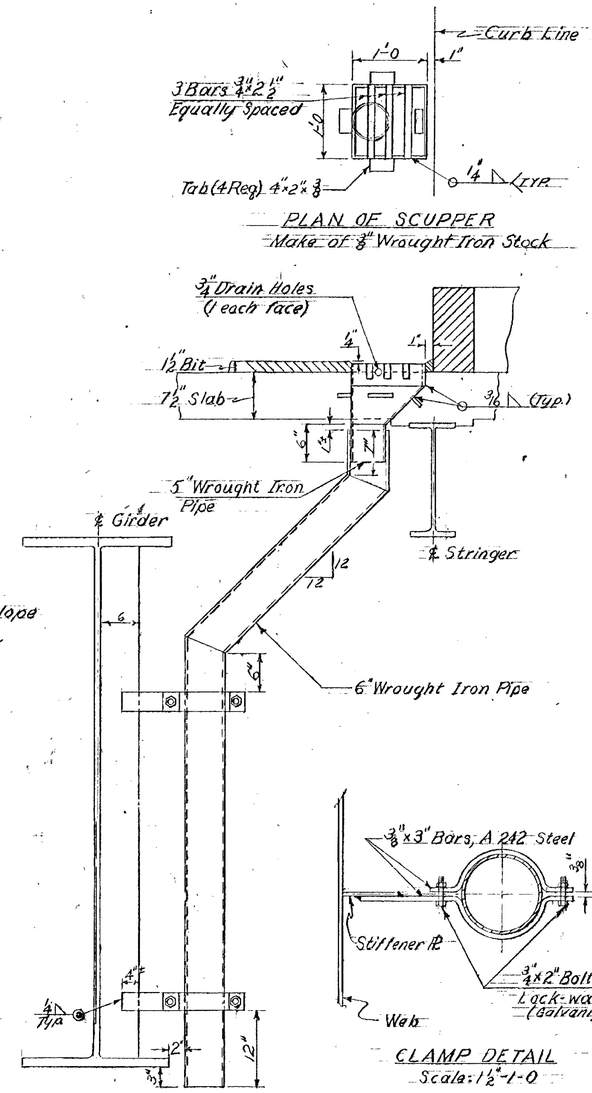

PLAN OF SCUPPER

Make of ⅜" Wrought Iron Stock

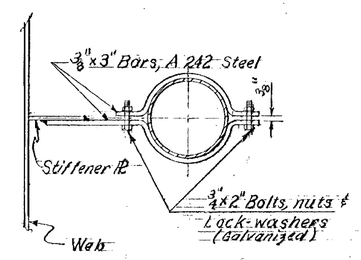

CLAMP DETAIL

Scale: 1½" = 1'-0

SCUPPER DETAIL

Scale: 1" = 1'-0

ITEM NO.	ITEM	UNIT	NET	OVERRUN	TOTAL	FINAL
	CHAN. EXCAV. OF EARTH	C.Y.				
	CHAN. EXCAV. OF ROCK	C.Y.				
	UNCLASS. CHAN. EXCAV.	C.Y.				
	STRUCT. EXCAV.	C.Y.				
	CONC. CLASS B	C.Y.				
	REINF. STEEL	LBS.				
	ASPHALTIC-TOP. COATING	S.Y.				
	TREATED TIMBER PILING	L.F.				
	SPLICES FOR STEEL PILING	EA.				
	STEEL PILING	L.F.				
	UNTREATED TIMBER PILING	L.F.				

WINDSOR-HARTLAND
IM MEMB(14)

SHEET 18 OF 39
BRIDGE 33S
FOR REFERENCE ONLY

BR 112 OF 125

STATE OF VERMONT
DEPARTMENT OF HIGHWAYS

TOWN OF WEATHERSFIELD-WINDSOR-HARTLAND

ROAD No. I-91 BRIDGE No.

I-91 OVER Rte. #44 & MILL BROOK

SCUPPER DETAILS

SCALE As Noted

SURVEYED BY

DRAWN BY W CHECKED BY A.G.C.

PROJECT No. I-91-1(21) Cont. #5

SHEET 22 OF 37