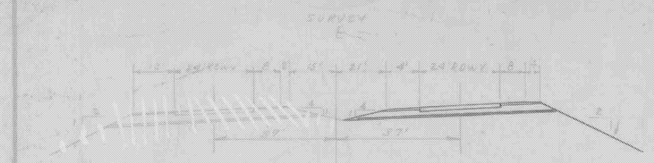

NEW HIGHWAY SECT. STA. TYPICAL TO STA.

SCALE 1"=20'

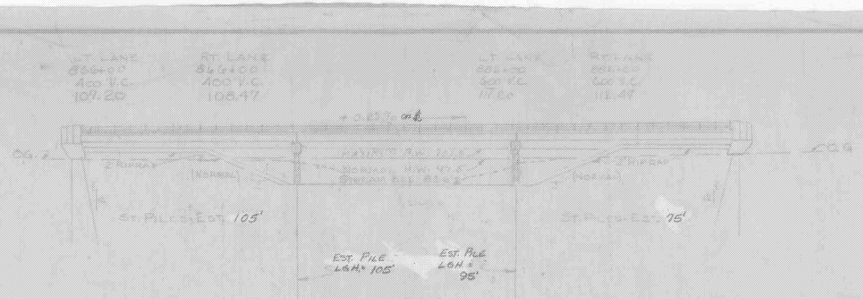

NEW HIGHWAY PROFILE ALONG ℄ (GRADE IS FOR ℄)

SCALE VERT. 1"=30' PILE DATA IS FOR RT. N.B. LANE

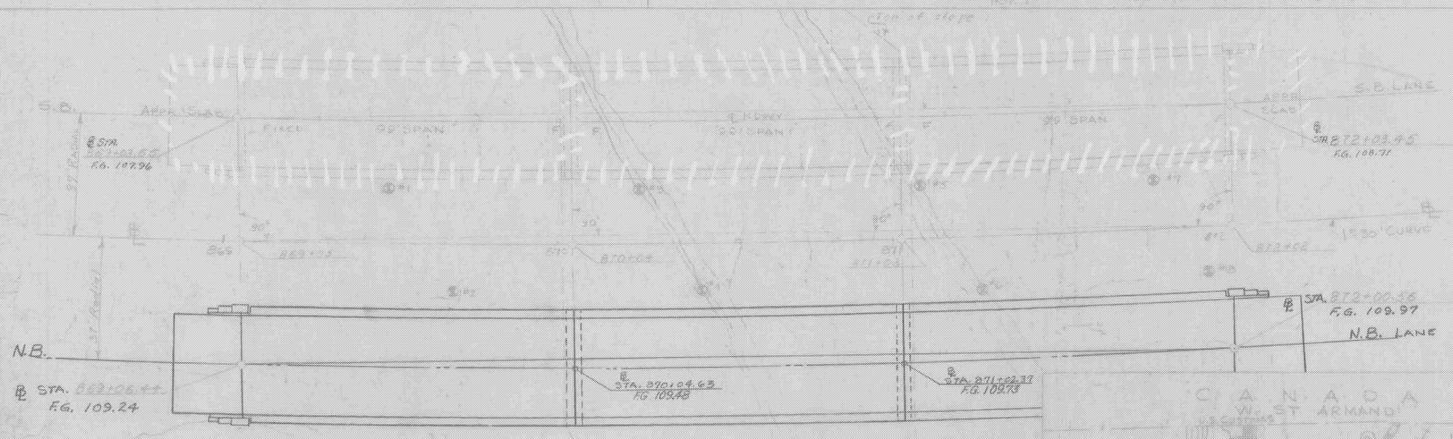

TYPICAL SECTION

SCALE 1"=5'

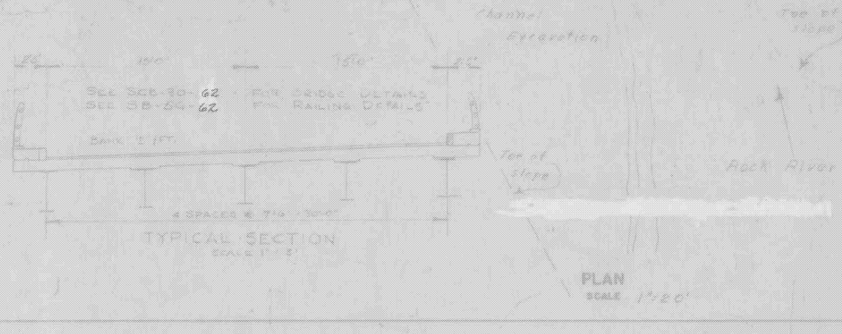

PLAN

SCALE 1"=20'

CANADA
W. ST ARMAND
CUSTOMS
MISSISQUOI BAY
SCALE 1"=½ MILE
PROJECT
LIMEKILN PT
ROCK RIVER
CANADIAN NATIONAL R.R.
LAKE ENTRANCE
LIMEKILN POINT ROAD
CITY
TOWN LINE
SAND BAR
BAY
ROCK RIVER
115
340
343
341
340
340
340