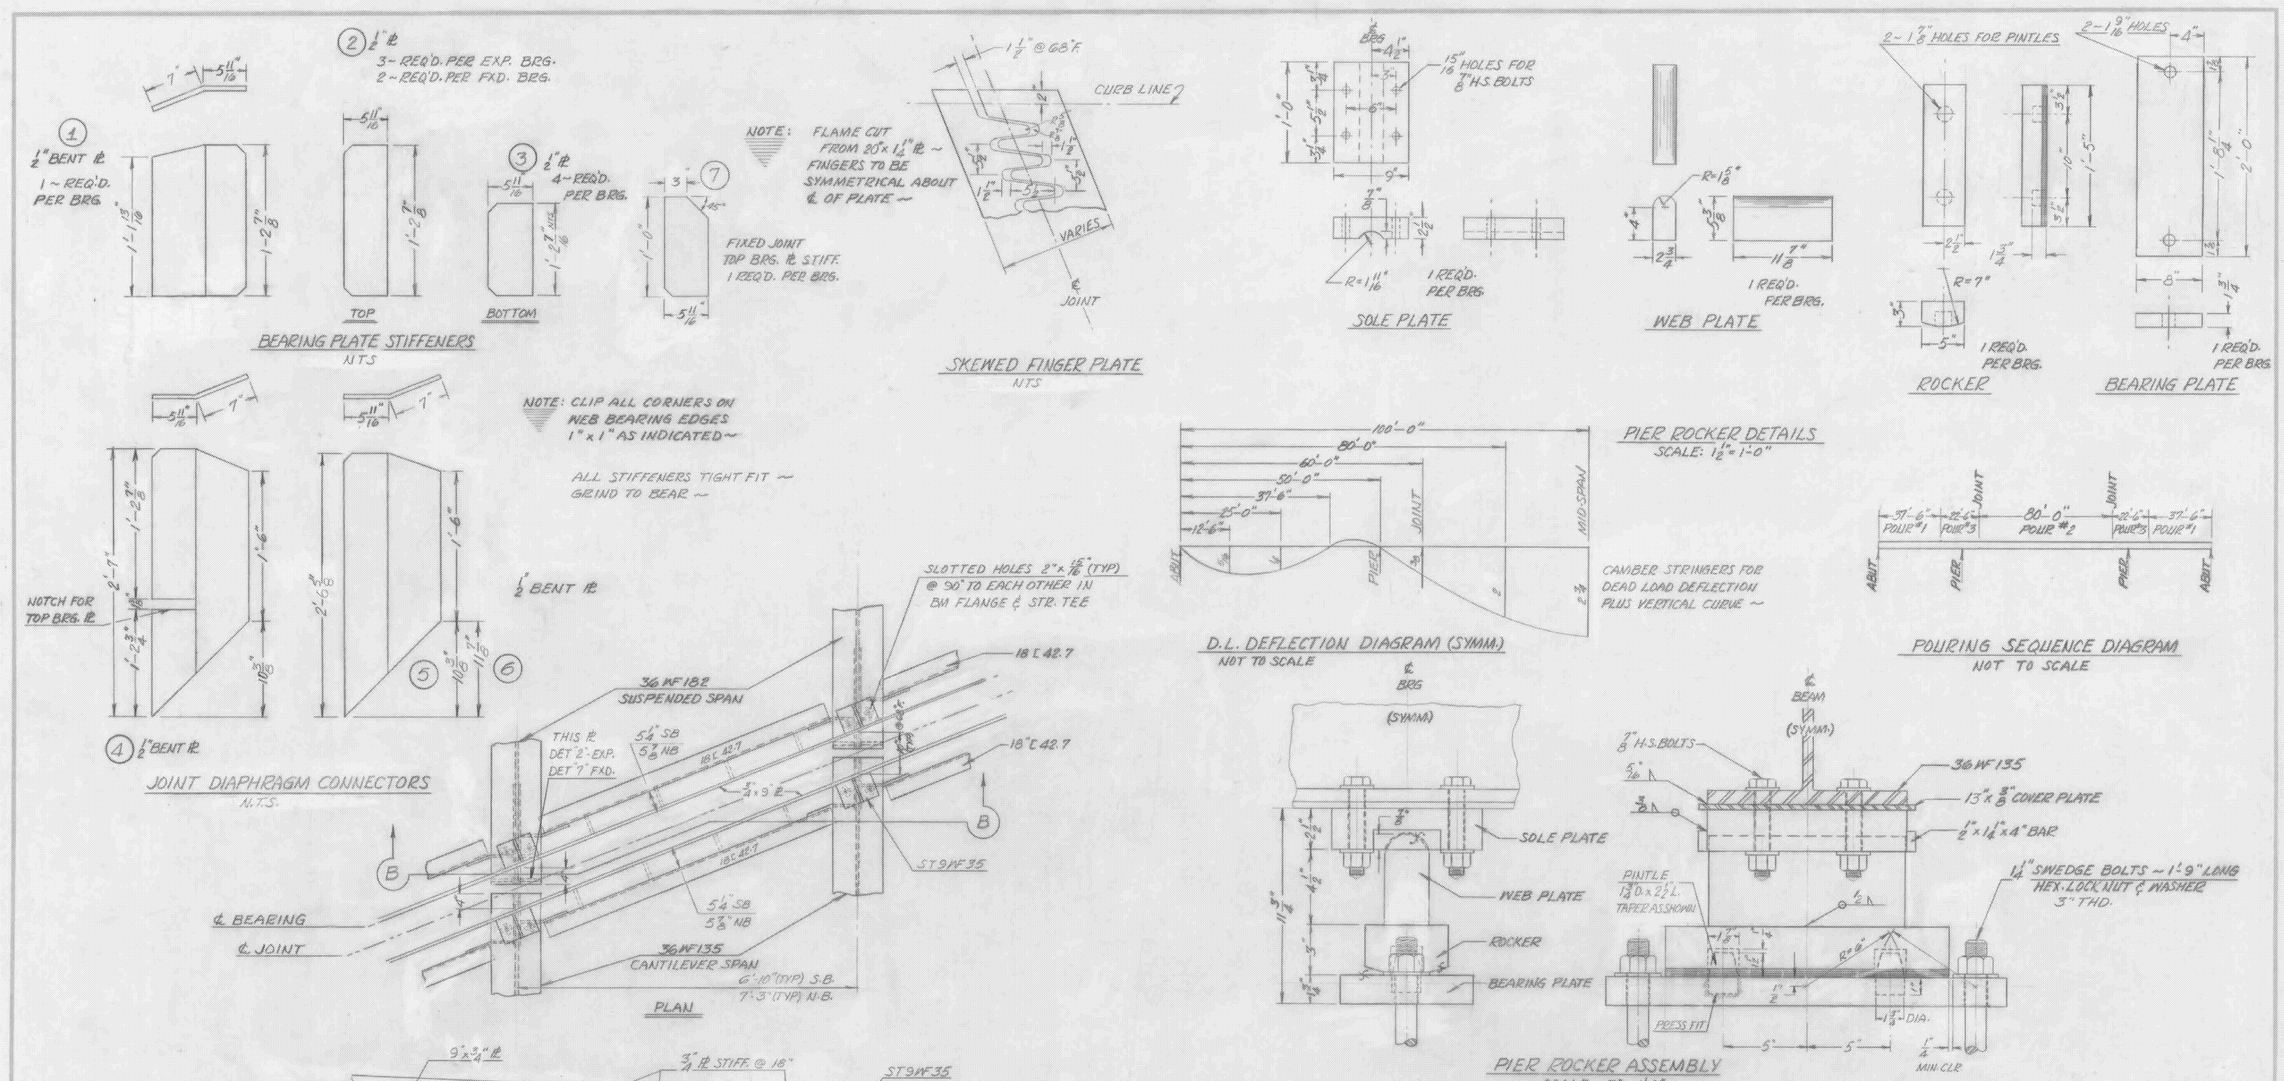

ITEM NO.	ITEM	UNIT	NET		TOTAL	FINAL
	CHAN. EXCAV. OF EARTH	C.Y.				
	CHAN. EXCAV. OF ROCK	C.Y.				
	UNCLASS. CHAN. EXCAV.	C.Y.				
	STRUCT. EXCAV.	C.Y.				
	CONC. CLASS AA (MOD.)	C.Y.				
	CONC. CLASS B (MOD.)	C.Y.				
	REINF. STEEL	LBS.				
	ASPHALTIC-ASB. COATING	S.Y.				
	TREATED TIMBER PILING	L.F.				
	SPLICES FOR STEEL PILING	EA.				
	STEEL PILING	L.F.				
	UNTREATED TIMBER PILING	L.F.				

HARTFORD-SHARON
IM MEMB(15)

SHEET 34 OF 47
BRIDGE 43S
FOR REFERENCE ONLY

STATE OF VERMONT
DEPARTMENT OF HIGHWAYS

TOWN OF HARTFORD URBAN-SOUTH
ROAD NO. I 91 BRIDGE NO.
JOINT DIAPHRAGM & PIER ROCKER ASSEMBLY
SOUTHBOUND I 91 OVER US #5
SCALE AS SHOWN
SURVEYED BY
DRAWN BY RHW CHECKED BY RND-SWA
PROJECT NO. I 91-2(2)
SHEET 92 OF 219

BR 109 OF 124